

Summer & Co.  
Zoned SR - Suburban Residential

Zoned R - Rural  
Present Use - Single Family Res.

3.956 Ac.  
Hugh E. Kirkwood Jr. & Mildred Kirkwood  
Zoned Rural

Zoned AR-12  
Apartment Residential

(Deed)  
43.286 Ac.  
D.B. 3053, Pg. 179

Highway Easement  
7.024 Ac.  
Parcel No. 122-2-1A, etc.  
Case No. 200341 Court  
of Common Pleas.

27.4196 Ac.  
(Survey)

No Direct Vehicular Access Line  
560'


781.64' New N. 88° 49' 24\"W.  
Ex. 2.157 Ac. (Deed 2.149 Ac.) Parcel 2  
D.B. 3526, Pg. 440 - to City of Columbus

$\Delta = 30^{\circ} 11'$   
 $E R = 231.00'$   
 $T = 62.29'$

— Certification —

I hereby certify that I personally made an actual survey of the premises shown on this plat on the 1<sup>st</sup> day of July, 1983; that this plat is a correct representation of the premises as determined by said survey. I further certify that there are no encroachments either way across any boundary line of the premises except as shown hereon.

*Harry L. Greene*  
Harry L. Greene, Reg. Surveyor - 4053.  
Signed at Columbus, Ohio, this 5<sup>th</sup> day of July, 1983.

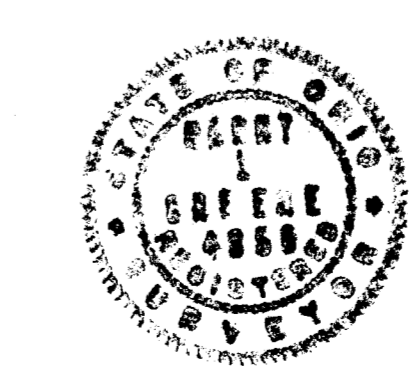

Survey showing the Joe Asmo and Dante Asmo property in the City of Columbus, Franklin County, Ohio, of record in Deed 3053, Pg. 179, Recorder's Office, Franklin County, Ohio. Exceptions and Easements as shown above.

(Revised July 1, 1983 to show 5,0005 Ac.)  
Mar. 22, 1979

Scale 1" = 100'

*Harry L. Greene*  
Harry L. Greene, Reg. Surveyor - 4053.  
2160 Tiamant Ctr., Columbus, Ohio - 43221. Ph. 486-0714