


Being 4.649 Acres, part of Lots 1 through 8, inclusive, Ohlen Estates Subdivision, Complete Record 178, Page 423, Office of Clerk of Court of Common Pleas, and all of Lots 109 through 115, inclusive, Lots 129 through 136, inclusive, and part of Lot 116 of Samuel Doyle's Lockwin Addition, Plat Book 1, Page 3, vacated Welch Alley, vacated portion of English Alley and vacated portion of Yoeman Street, in City of Columbus, County of Franklin, State of Ohio.

For  
**THE TIMKEN COMPANY**

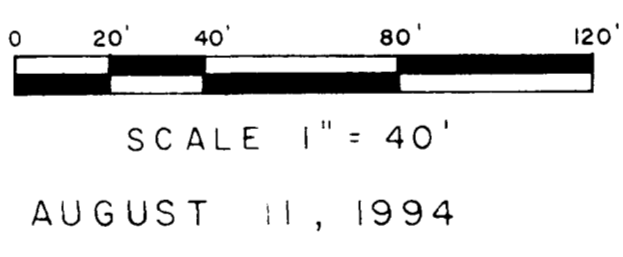

*Paul T. Dinan*  
 Paul T. Dinan P.S. 7312



**MyersSurveying**  
 COMPANY

2740 East Main Street  
 Bexley, Ohio 43209  
 (614) 236-8877  
 Telefax 236-4559

I hereby certify that the foregoing Boundary Survey was prepared from actual field measurements in accordance with Chapter 4733-27 Ohio Administrative Code. True pins set were 3/8" x 1 1/2" with a red plastic plug inscribed "P.S. #2312", unless otherwise noted. Basis of bearings is N 86° 19' 47" W on north line of Timken Street per O.R.V. 2509 A06.