

7/19/50 Bill


L.E. 1737 8-3-50

FIRST PHASE OF DEVELOPMENT FOR

**OSCAR L. THOMAS** 319 E. Town St.

BY:  
A.C. ALLEN & ASSOCIATES  
52 W. GAY ST.  
SEPT. 8, 1949 COLUMBUS, OHIO

LA 2105 Rev June Ma 4315

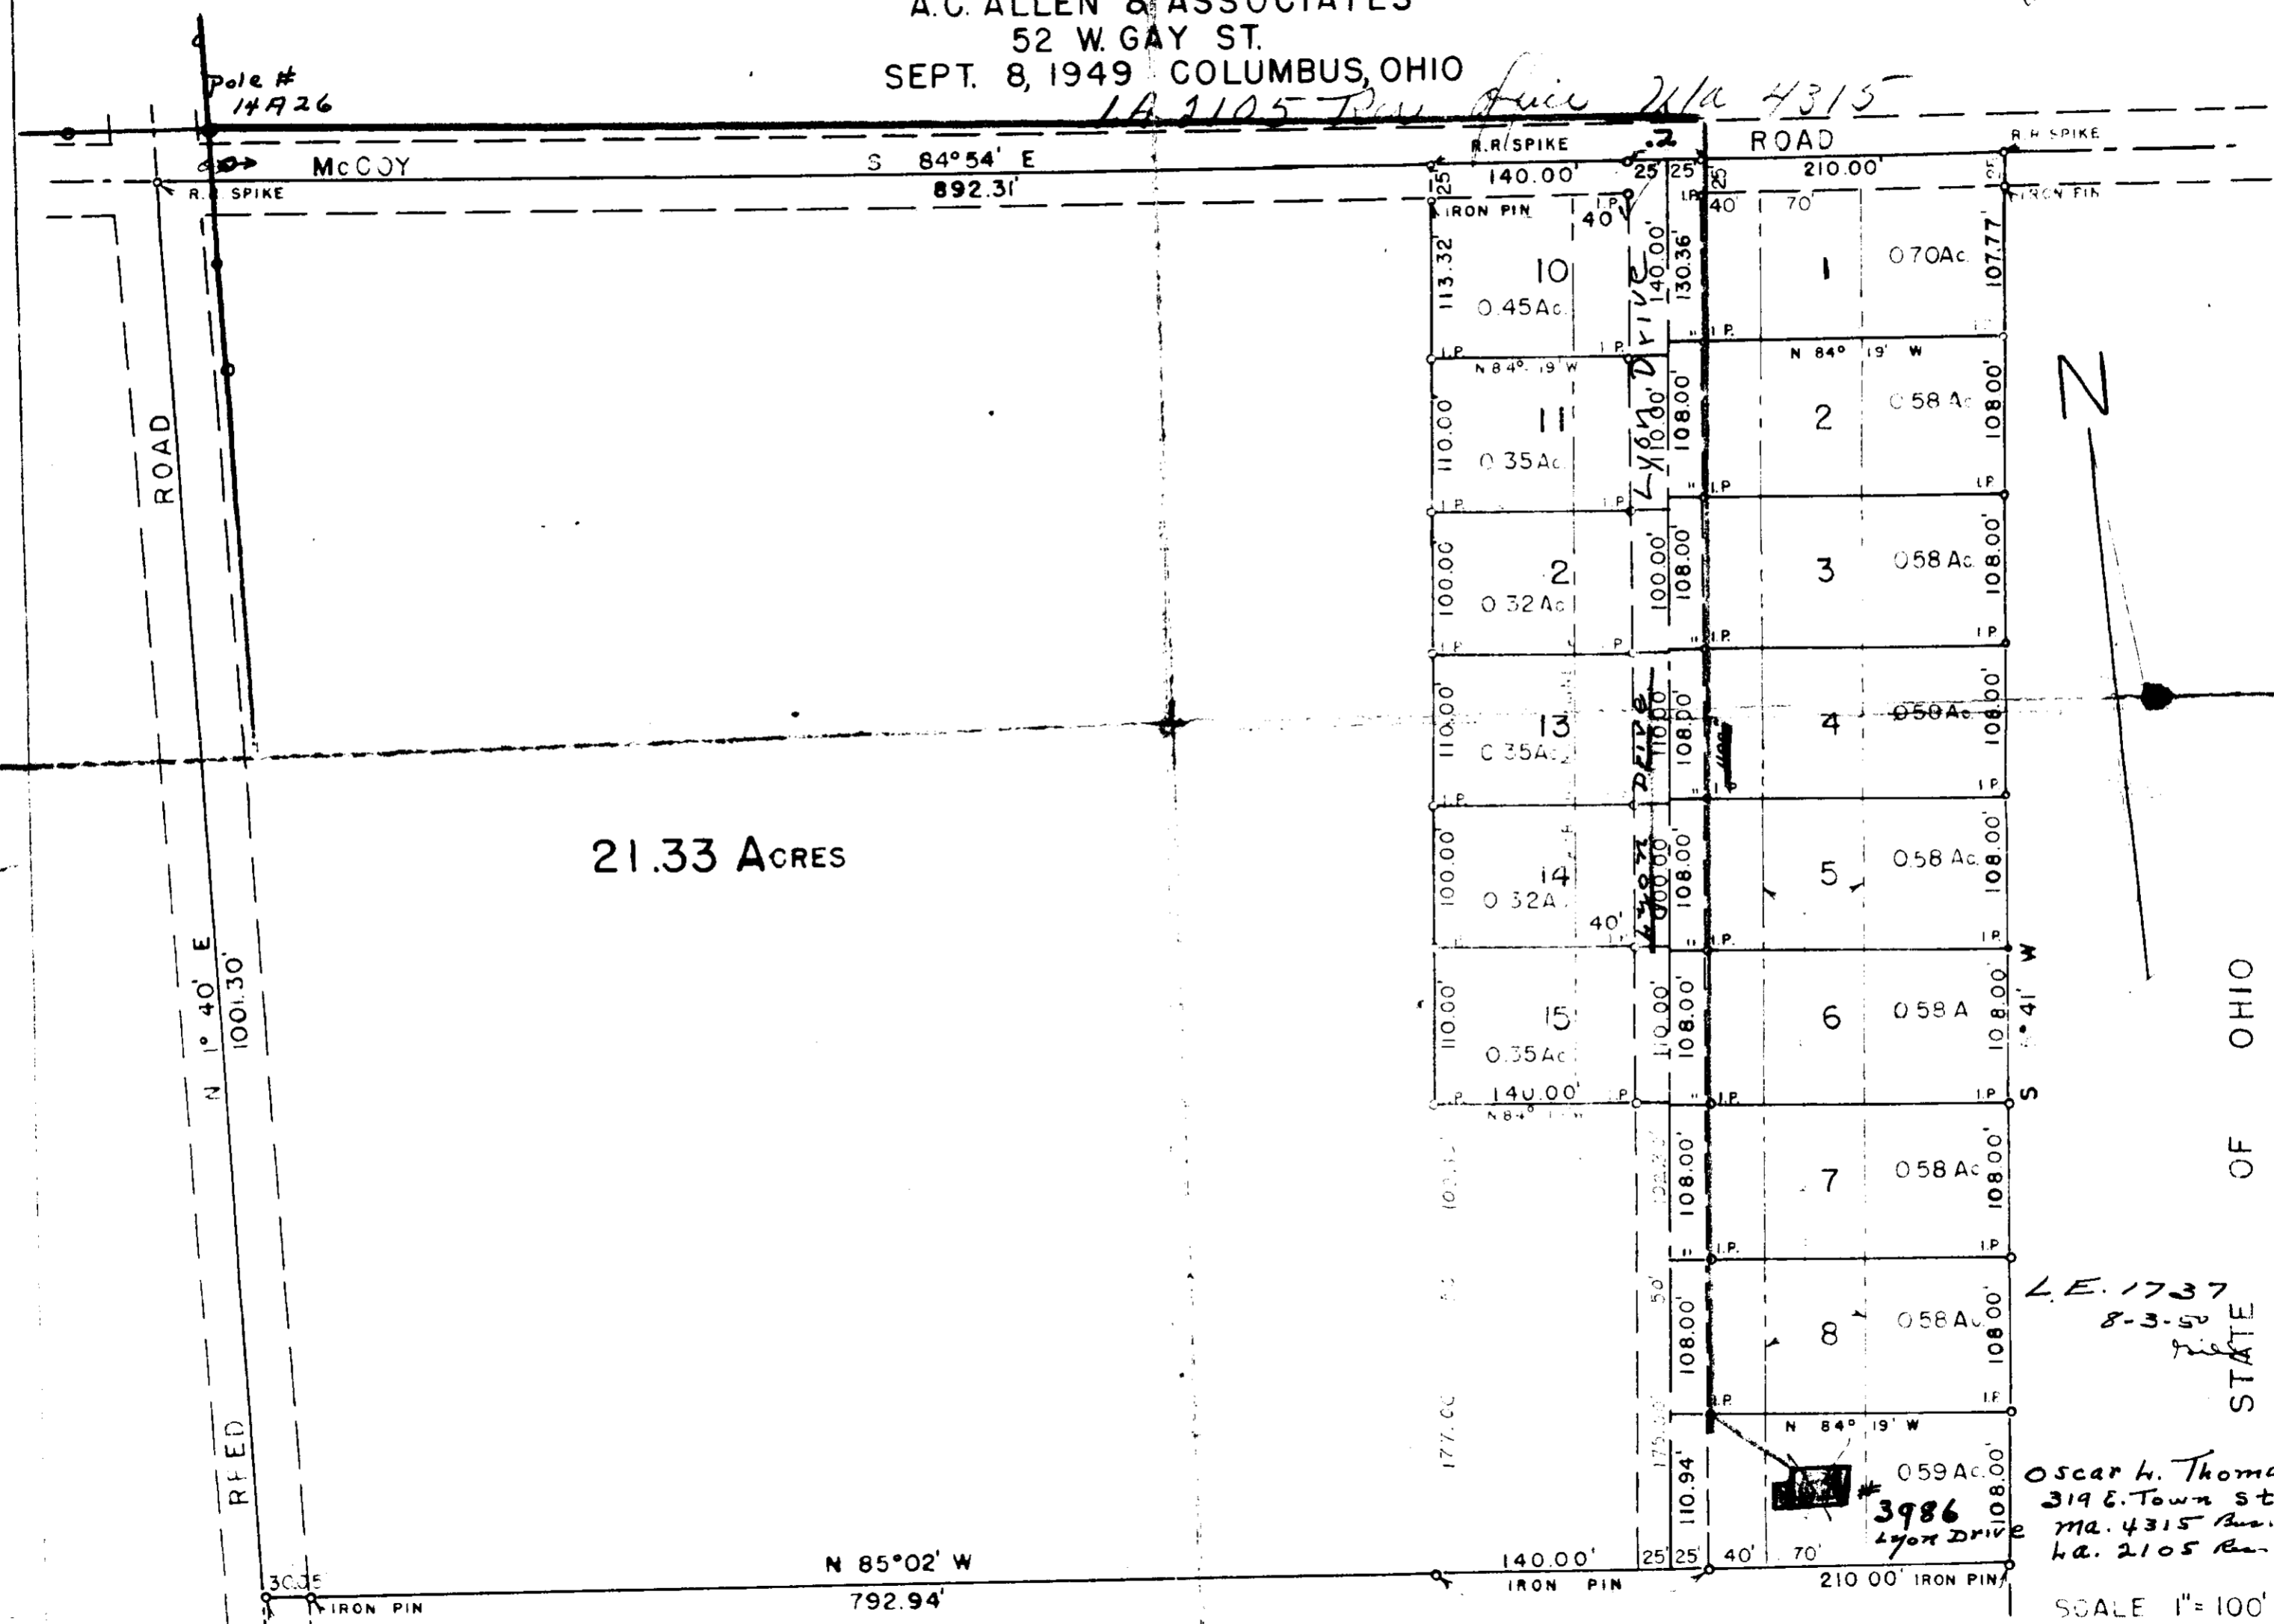

21.33 ACRES

L.E. 1737  
8-3-50  
Bill

Oscar L. Thomas  
319 E. Town St.  
Ma. 4315 Rev.  
La. 2105 Rev.

SCALE 1" = 100'

W. HARTSOCK

