

RESERVE + E. 1/2 VAC. ALLEY.  
PARCEL No. OIO-72,480. (10-20-72.)  
PHILIP E. ABSI and GLORIA T. ABSI


LOT No. 9, PARCEL No. OIO-72,473,  
No. 18 E. GLENMONT AVE.,  
DOROTHY C. BEEM, (D.B. 3557, P.246.)

M-49

VACATED ALLEY, ORDINANCE No. 1155-67, 9-25-67.

CITY RESERVES EASEMENT RIGHTS

A L L E Y

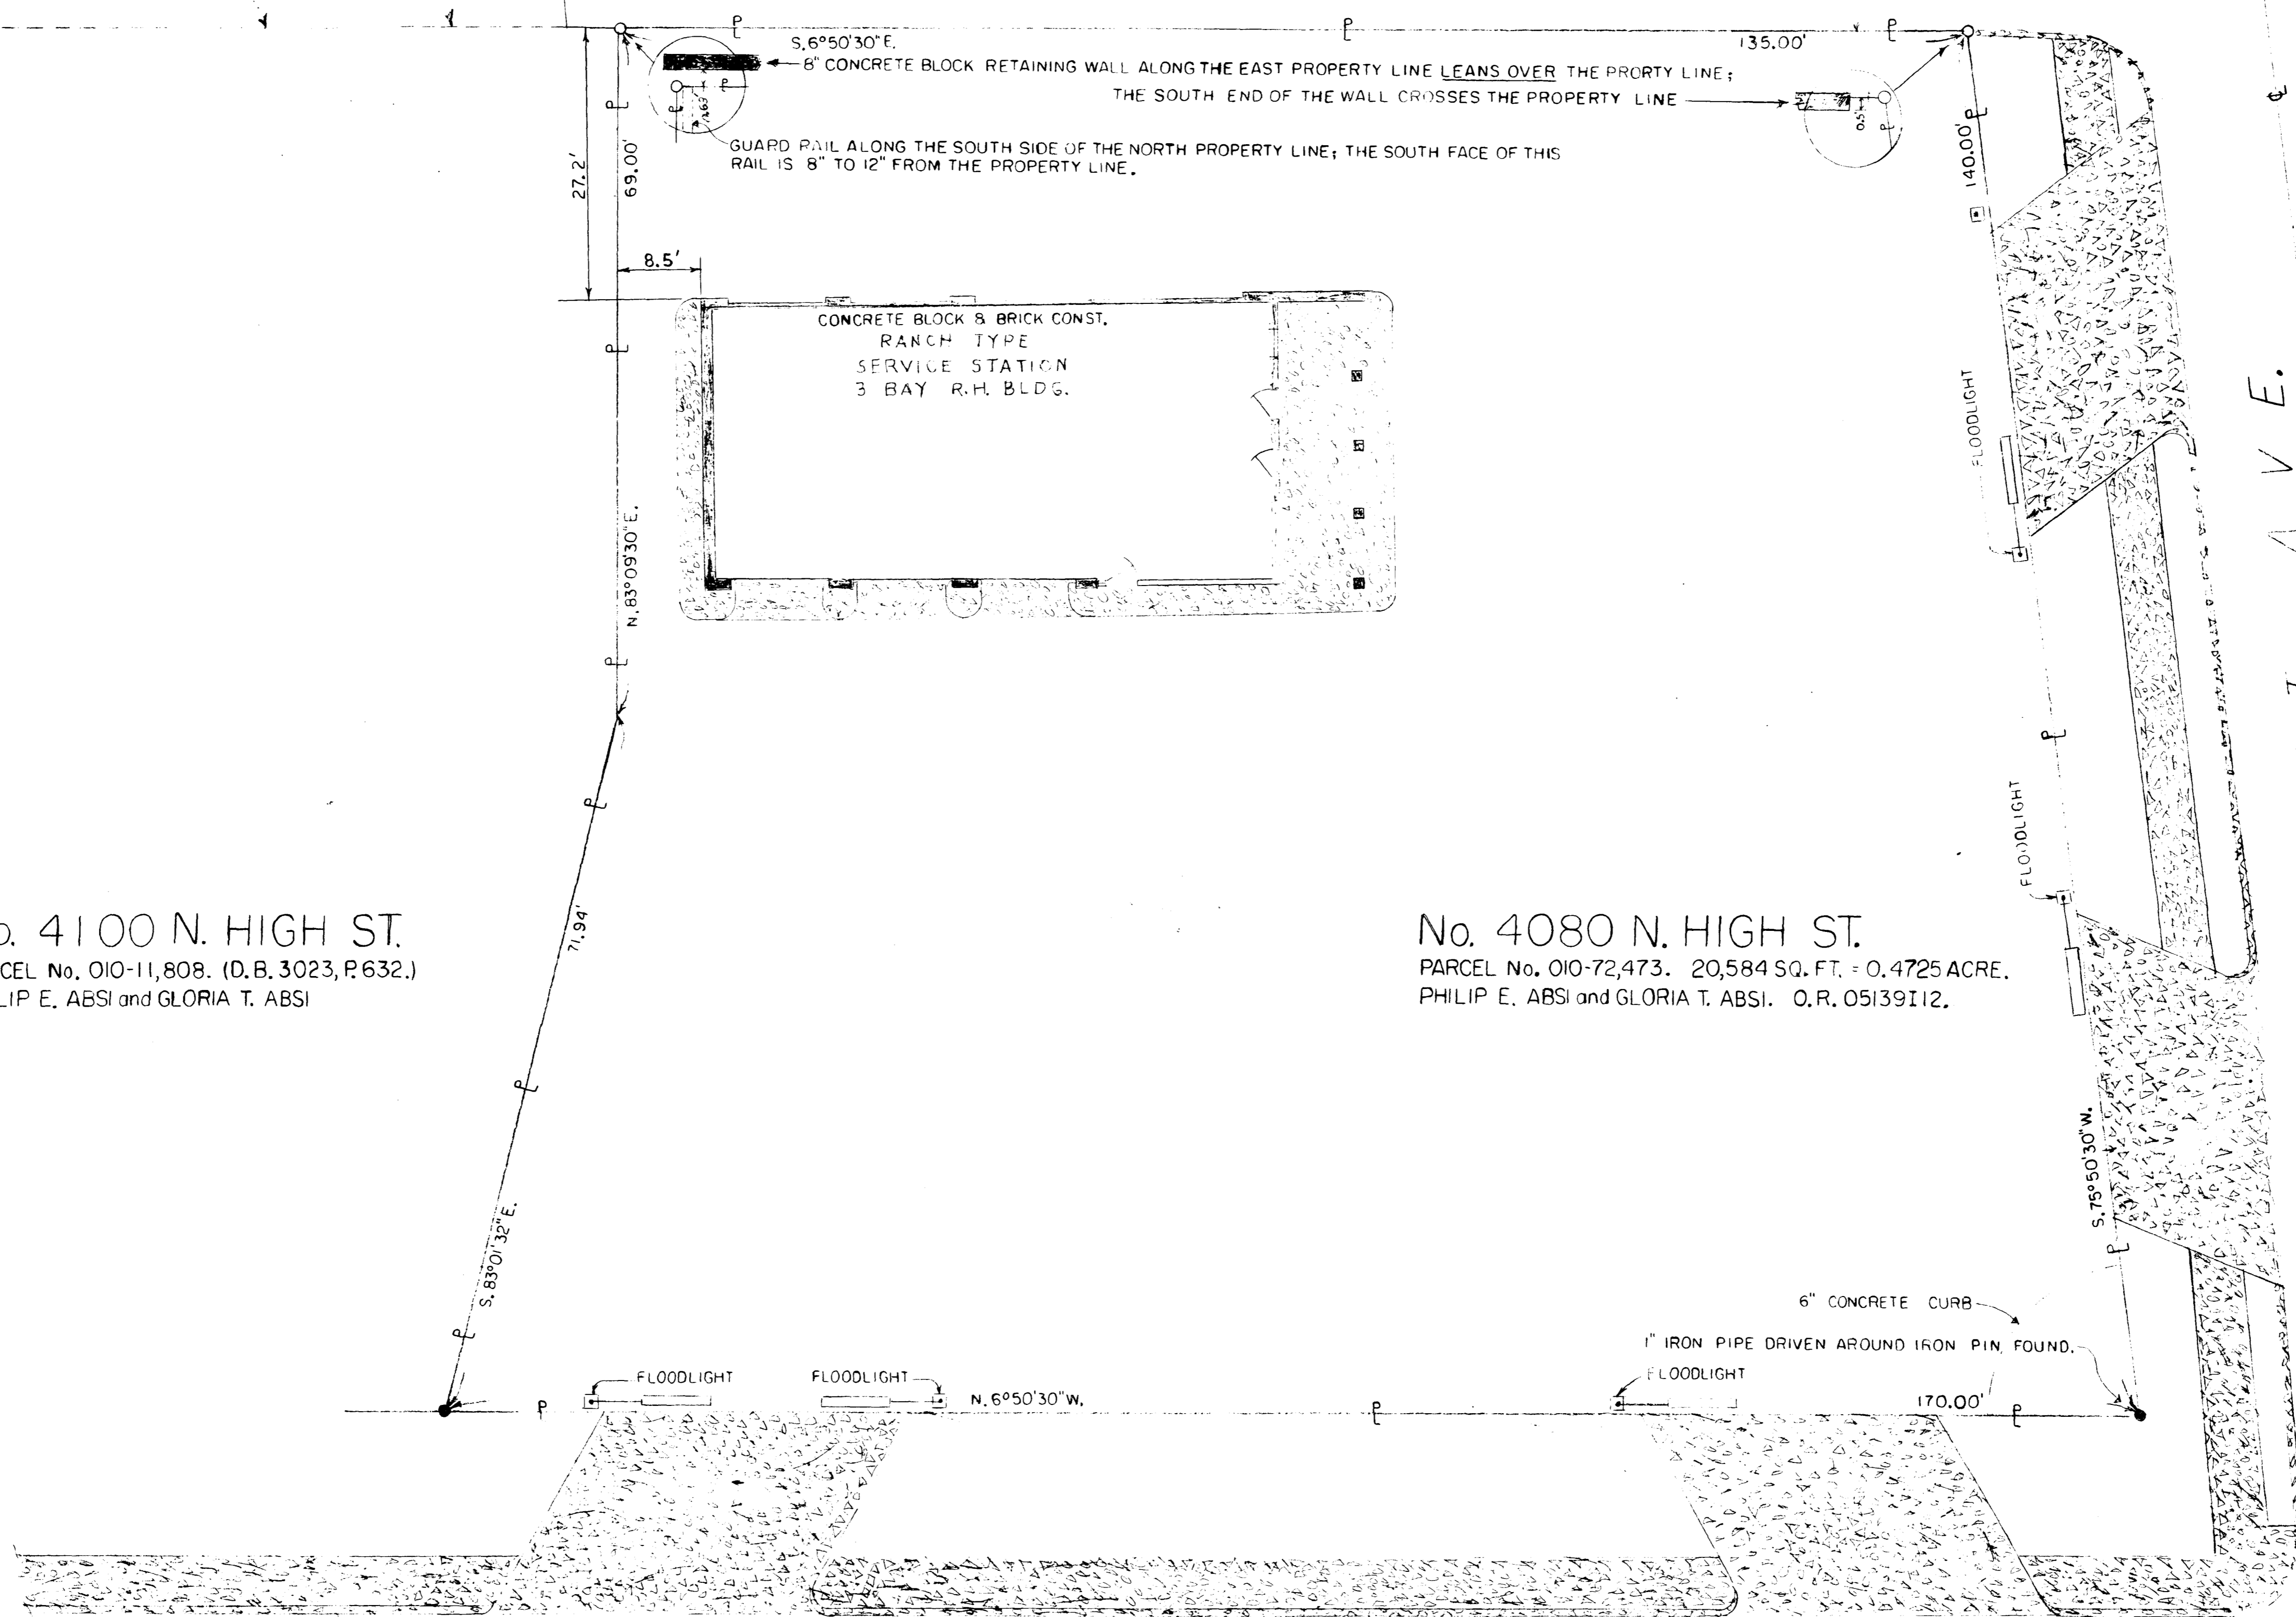

No. 4100 N. HIGH ST.  
PARCEL No. OIO-11,808. (D.B. 3023, P.632.)  
PHILIP E. ABSI and GLORIA T. ABSI

No. 4080 N. HIGH ST.  
PARCEL No. OIO-72,473. 20,584 SQ. FT. = 0.4725 ACRE.  
PHILIP E. ABSI and GLORIA T. ABSI. O.R. 05139112.

SURVEY OF 4080 N. HIGH ST.,  
COLUMBUS, OHIO, OHIO, 43214.

SITUATED IN THE STATE OF OHIO, IN THE COUNTY OF FRANKLIN, AND IN THE CITY OF COLUMBUS.  
BEING LOTS NOS. 6, 7, 8, AND THE SOUTH PART OF LOT NO. 5 OF C. W. SNOW'S SUBDIVISION, AS RECORDED IN PLAT BOOK 17, PAGE 3, IN THE RECORDER'S OFFICE IN THE SAID COUNTY.

SURVEYED & PLATTED BY:  
MYERS ENGINEERING CO.  
498 OAKLAND PARK AVE.,  
COLUMBUS, OHIO, 43214.  
TEL. (614) 268-8624.

L E G E N D

- P — PROPERTY LINE OF SURVEYED PROPERTY.
- IRON PIPE OR IRON PIN FOUND.
- IRON PIPE SET.
- ▨ CONCRETE PAVEMENT.


I CERTIFY THAT THIS DRAWING IS CORRECT. CERTIFIED TO CHICAGO TITLE INS. CO., AND TO PHILIP E. and GLORIA T. ABSI; and THE STATE SAVINGS CO.

*Orval C. Myers*  
ORVAL C. MYERS, P.S., P.E.  
REGISTERED SURVEYOR, NO. 3933.

JAN. 16, 1985.

SCALE, 1" = 10'

SEE:  
AUDITOR'S TAX MAP M-49.  
CITY MAP 232-6.  
N.W. COLUMBUS QUAD., U.S.G.S.

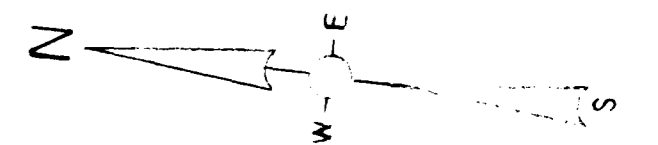

N. H I G H S T.

E. G L E N M O N T A V E.