O-14

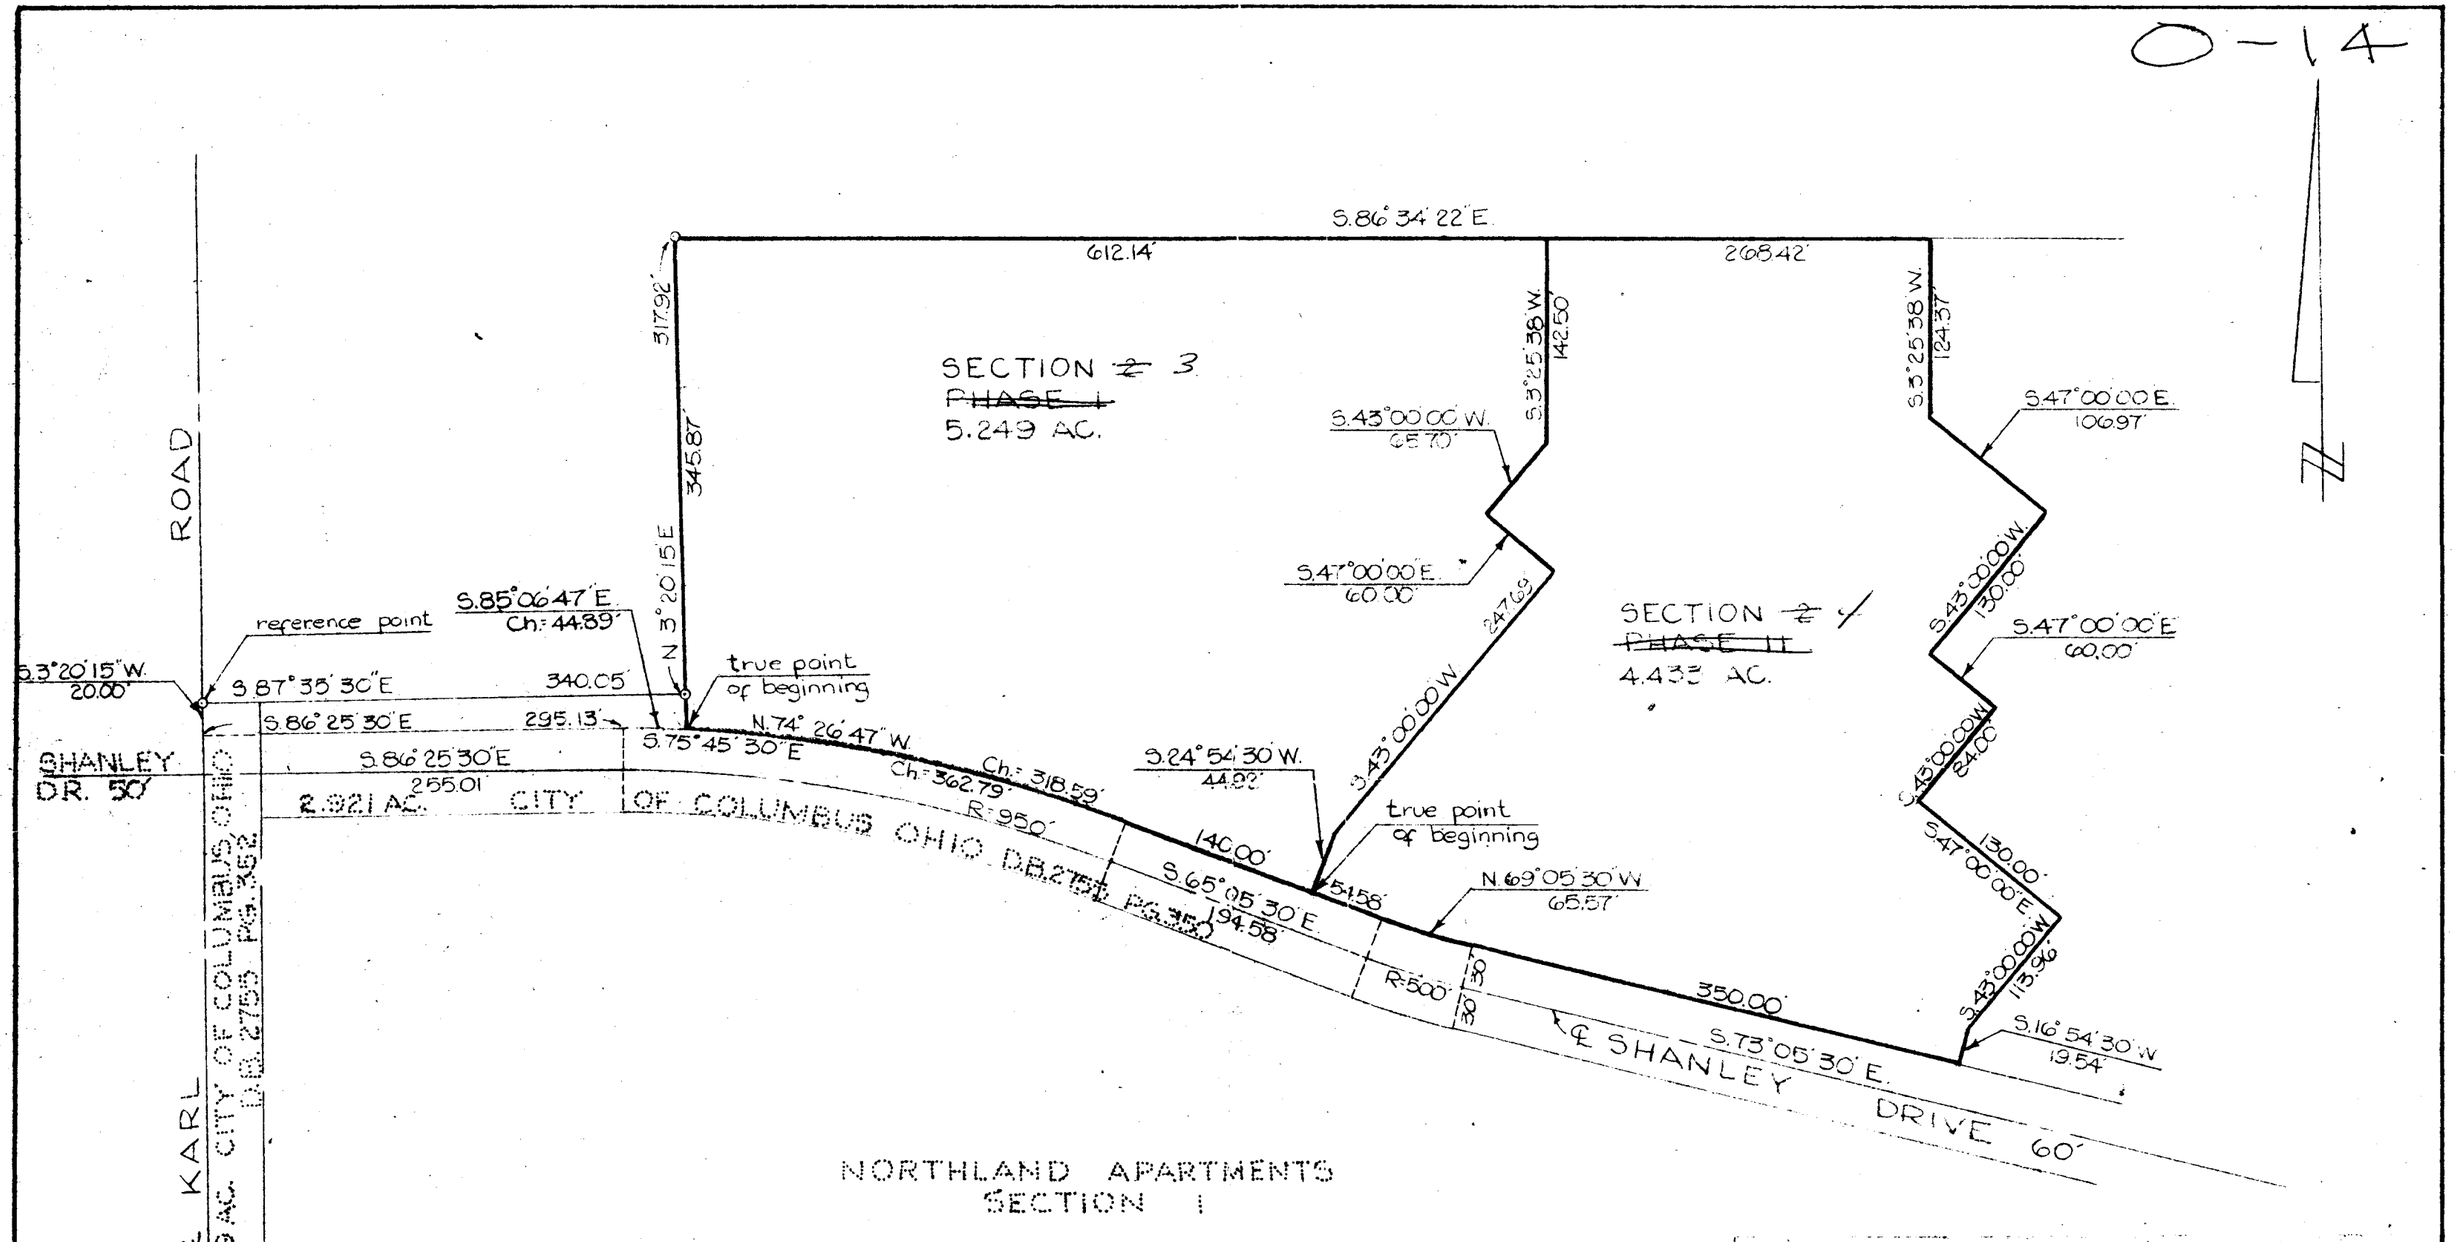

TYPE OF DRAWING	BOUNDARY PLAT

BOUNDARY PLAT OF PHASE I AND PHASE II OF NORTHLAND APARTMENTS SECTION 2

SCALE: 1"=100'	FOR: GRANT-HOLLADAY	
DRAWN: 10-29-69 J.C.	HOCKADEN-LIPES-ROUSCULP, INC. CONSULTING ENGINEERS 260 7½ NORTH HIGH ST. COLUMBUS, OHIO	[redacted]
CHECKED: FAB 10-29-69		ORDER NO. OF P-290
REVISED:		

2530 120 070 096 E KARL W SHANLEY DRIVE 1969 0140 03

(11)