


SCALE 1" = 40'  
 NOVEMBER 29, 1986

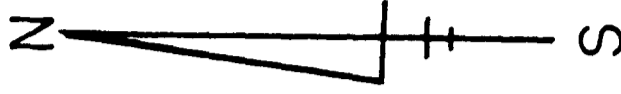

Being a 2.650 Acre tract ( 2  
 Parcels, a 1.995 Acre and 0.655  
 Acre tract ). Being a part of  
 Quarter Township 1, Township  
 1 North, Range 19 West,  
 United States Military Lands,  
 and is situated in the City of  
 COLUMBUS, OHIO

For  
 BUILDERS & DEVELOPERS TITLE AGENCY, INC.  
 and/or  
 CITIZENS FEDERAL SAVINGS & LOAN ASS'N.

We hereby certify that the foregoing  
 plat was prepared from an actual  
 survey of the premises. No side line  
 of principal building is less than  
 dimension shown. Iron pins not set  
 unless indicated thus - 0-. For  
 Mortgage Loan & Title Insurance  
 purposes only.

*Albert O. Myers Jr.*  
 ALBERT O. MYERS JR., Registered Surveyor #3352  
 Myers Surveying Company, Inc.  
 2740 E. Main Street  
 Columbus, (Bexley) Ohio, 43209  
 614-235-8677

