




GERTRUDE E. ANDERSON
(D.B. 931, P. 485)

J.W.B. J. BITZER
1.317 AC
(D.B. 2205 P. 624)

SURVEY OF A 3.655 ACRE TRACT (BEING THE TRACT CONVEYED TO VALENTINO & MAXINE G. DI PIETRO, RECORDED IN D.B. 2196, P. 202, RECORDER'S OFFICE, FRANKLIN CO., OHIO), AND BEING A PART OF LOT 2, (THE CASE OF DAVID SKINNER et al. vs SARAH MORRIS et al.), AS SHOWN IN CHANCERY RECORD 6, Pg. 350, COMMON PLEAS COURT, FRANKLIN CO., OHIO, AND BEING IN SECTION 2, TOWNSHIP 1, RANGE 17, U.S. MILITARY LANDS, MIFFLIN TOWNSHIP, FRANKLIN COUNTY, OHIO

FOR

M.R. VALENTINO DI PIETRO

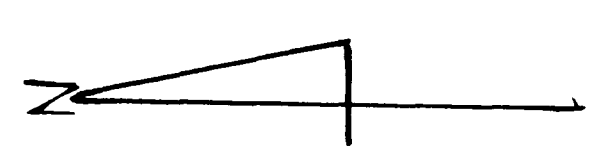

1120 051014 WESTERVILLE 11770 05164 005