


LOCATED IN THE CITY OF COLUMBUS, COUNTY OF FRANKLIN, STATE OF OHIO.

LEGEND

- — 3/4" I.D. Pipe Set
- ⊗ — 3/4" I.D. Pipe Found
- ⊙ — 1" I.P. Found

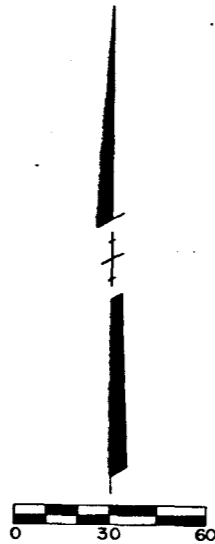

North Referenced From Green Countrie Section Two, Phase One As Recorded in Plat Book 50 Page 120 As Recorded in The Recorder's Office, Franklin County, Ohio.

KILLBUCK FINANCIAL CORPORATION AND SERVICE RESOURCES, INC.

D.V. 3352 P680
ZONED C4
VACANT LAND

WESTLAND INVESTMENT COMPANY
D.V. 3482 P368
ZONED PUB8
VACANT LAND

ACRES = 3.576

D.V. 3775 P676
ZONED PUB8
VACANT LAND

GREEN COUNTRIE SECTION 5 PHASE I
P.B. 53 P.78,79
ZONED PUB8
SINGLE FAMILY RESIDENTIAL

KILLBUCK FINANCIAL CORPORATION AND SERVICE RESOURCES, INC.


D.V. 3352 P680
ZONED PUB8
VACANT LAND

DANBURY MEADOW CONDOMINIUMS PHASE ONE

Cond. Platbook 14 P 54
ZONED PUB8
CONDOMINIUMS

GALLOWAY ROAD

OLD IRISH DRIVE 60' R/W

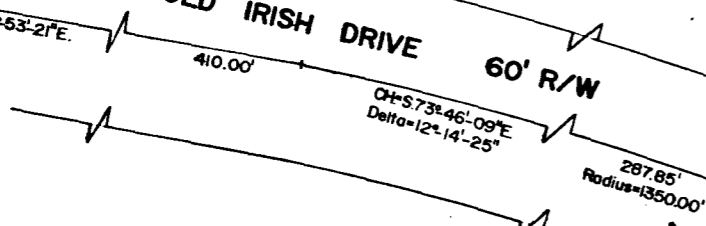

NOTE

According to U.S. Department of Housing and Urban Development Federal Insurance Administration, Community-Panel Number 390170-0008 A Dated February 3, 1978, this property is not in a Flood Hazard Area.

TO ALL PERSONS INTERESTED IN THE TITLE TO THE PREMISES SHOWN ON THIS SURVEY PLAT:

We do hereby certify that an actual field survey was made of the premises shown on this plat on the 26th day of January, 1984; that this plat is a correct representation of the premises as determined by said survey. We further certify that there are no encroachments either way across any boundary line of the premises except as shown hereon.

Signed at 4:11 P.M. this 24th day of May, 1984

KOSANCHICK & ASSOCIATES, INC.

By _____
Registered Surveyor No. _____

KOSANCHICK & ASSOCIATES, INC.
SURVEYORS & ENGINEERS
COLUMBUS, OHIO OFFICE: 6119 EAST BROAD STREET COLUMBUS, OHIO 43213 PHONE: (614) 861-7211
ATLANTA, GEORGIA OFFICE: 1895 PHOENIX BOULEVARD ATLANTA, GEORGIA 30349 PHONE: (404) 991-0688
ALTIMONTE SPRINGS, FLORIDA OFFICE: 850 NORTH LAKE BOULEVARD SUITE 430 ALTIMONTE SPRINGS, FLORIDA PHONE: (305) 850-8310



PLAT OF SURVEY FOR CARDINAL INDUSTRIES
OLD IRISH DRIVE
COLUMBUS, OHIO

REV'D:
DATE: JAN 1984
SCALE: 1" = 30'
DRAWN: L.H.B.J.
CHECKED: M.K.
FILE: SHEET:
1330