


PLAN OF SURVEY
 0.934 ACRE TRACT
 TOWNSHIP OF BLENDON, QUARTER TOWNSHIP 3,
 TOWNSHIP 2, RANGE 17, U.S.M. LANDS,
 CITY OF COLUMBUS, FRANKLIN COUNTY,
 OHIO


BLENDON ADDITION

BRANDYWINE MEADOWS ADDITION

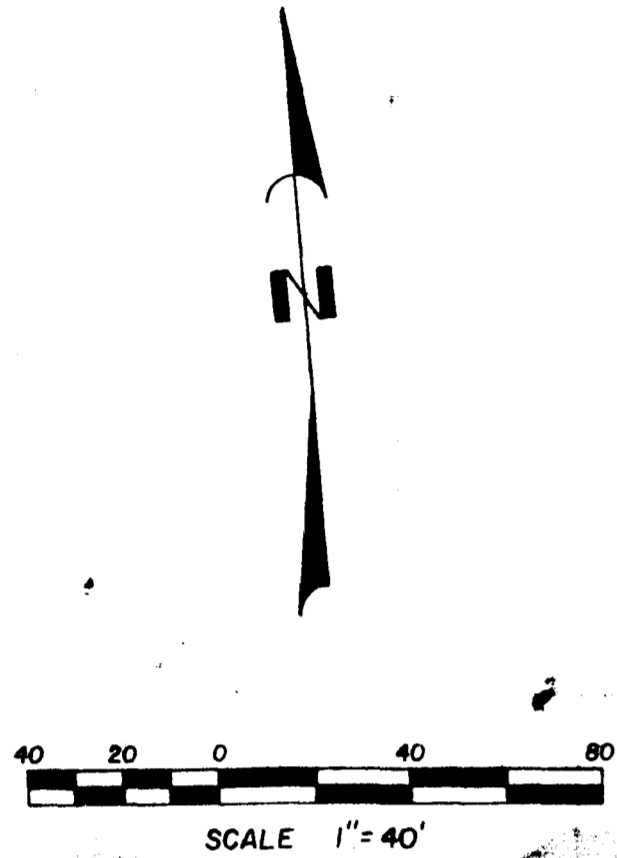

CLEVELAND AVE.

SURVEYED FOR:
 GENE DEAL
 MIRACLE CAR WASH
 MANSFIELD, OHIO

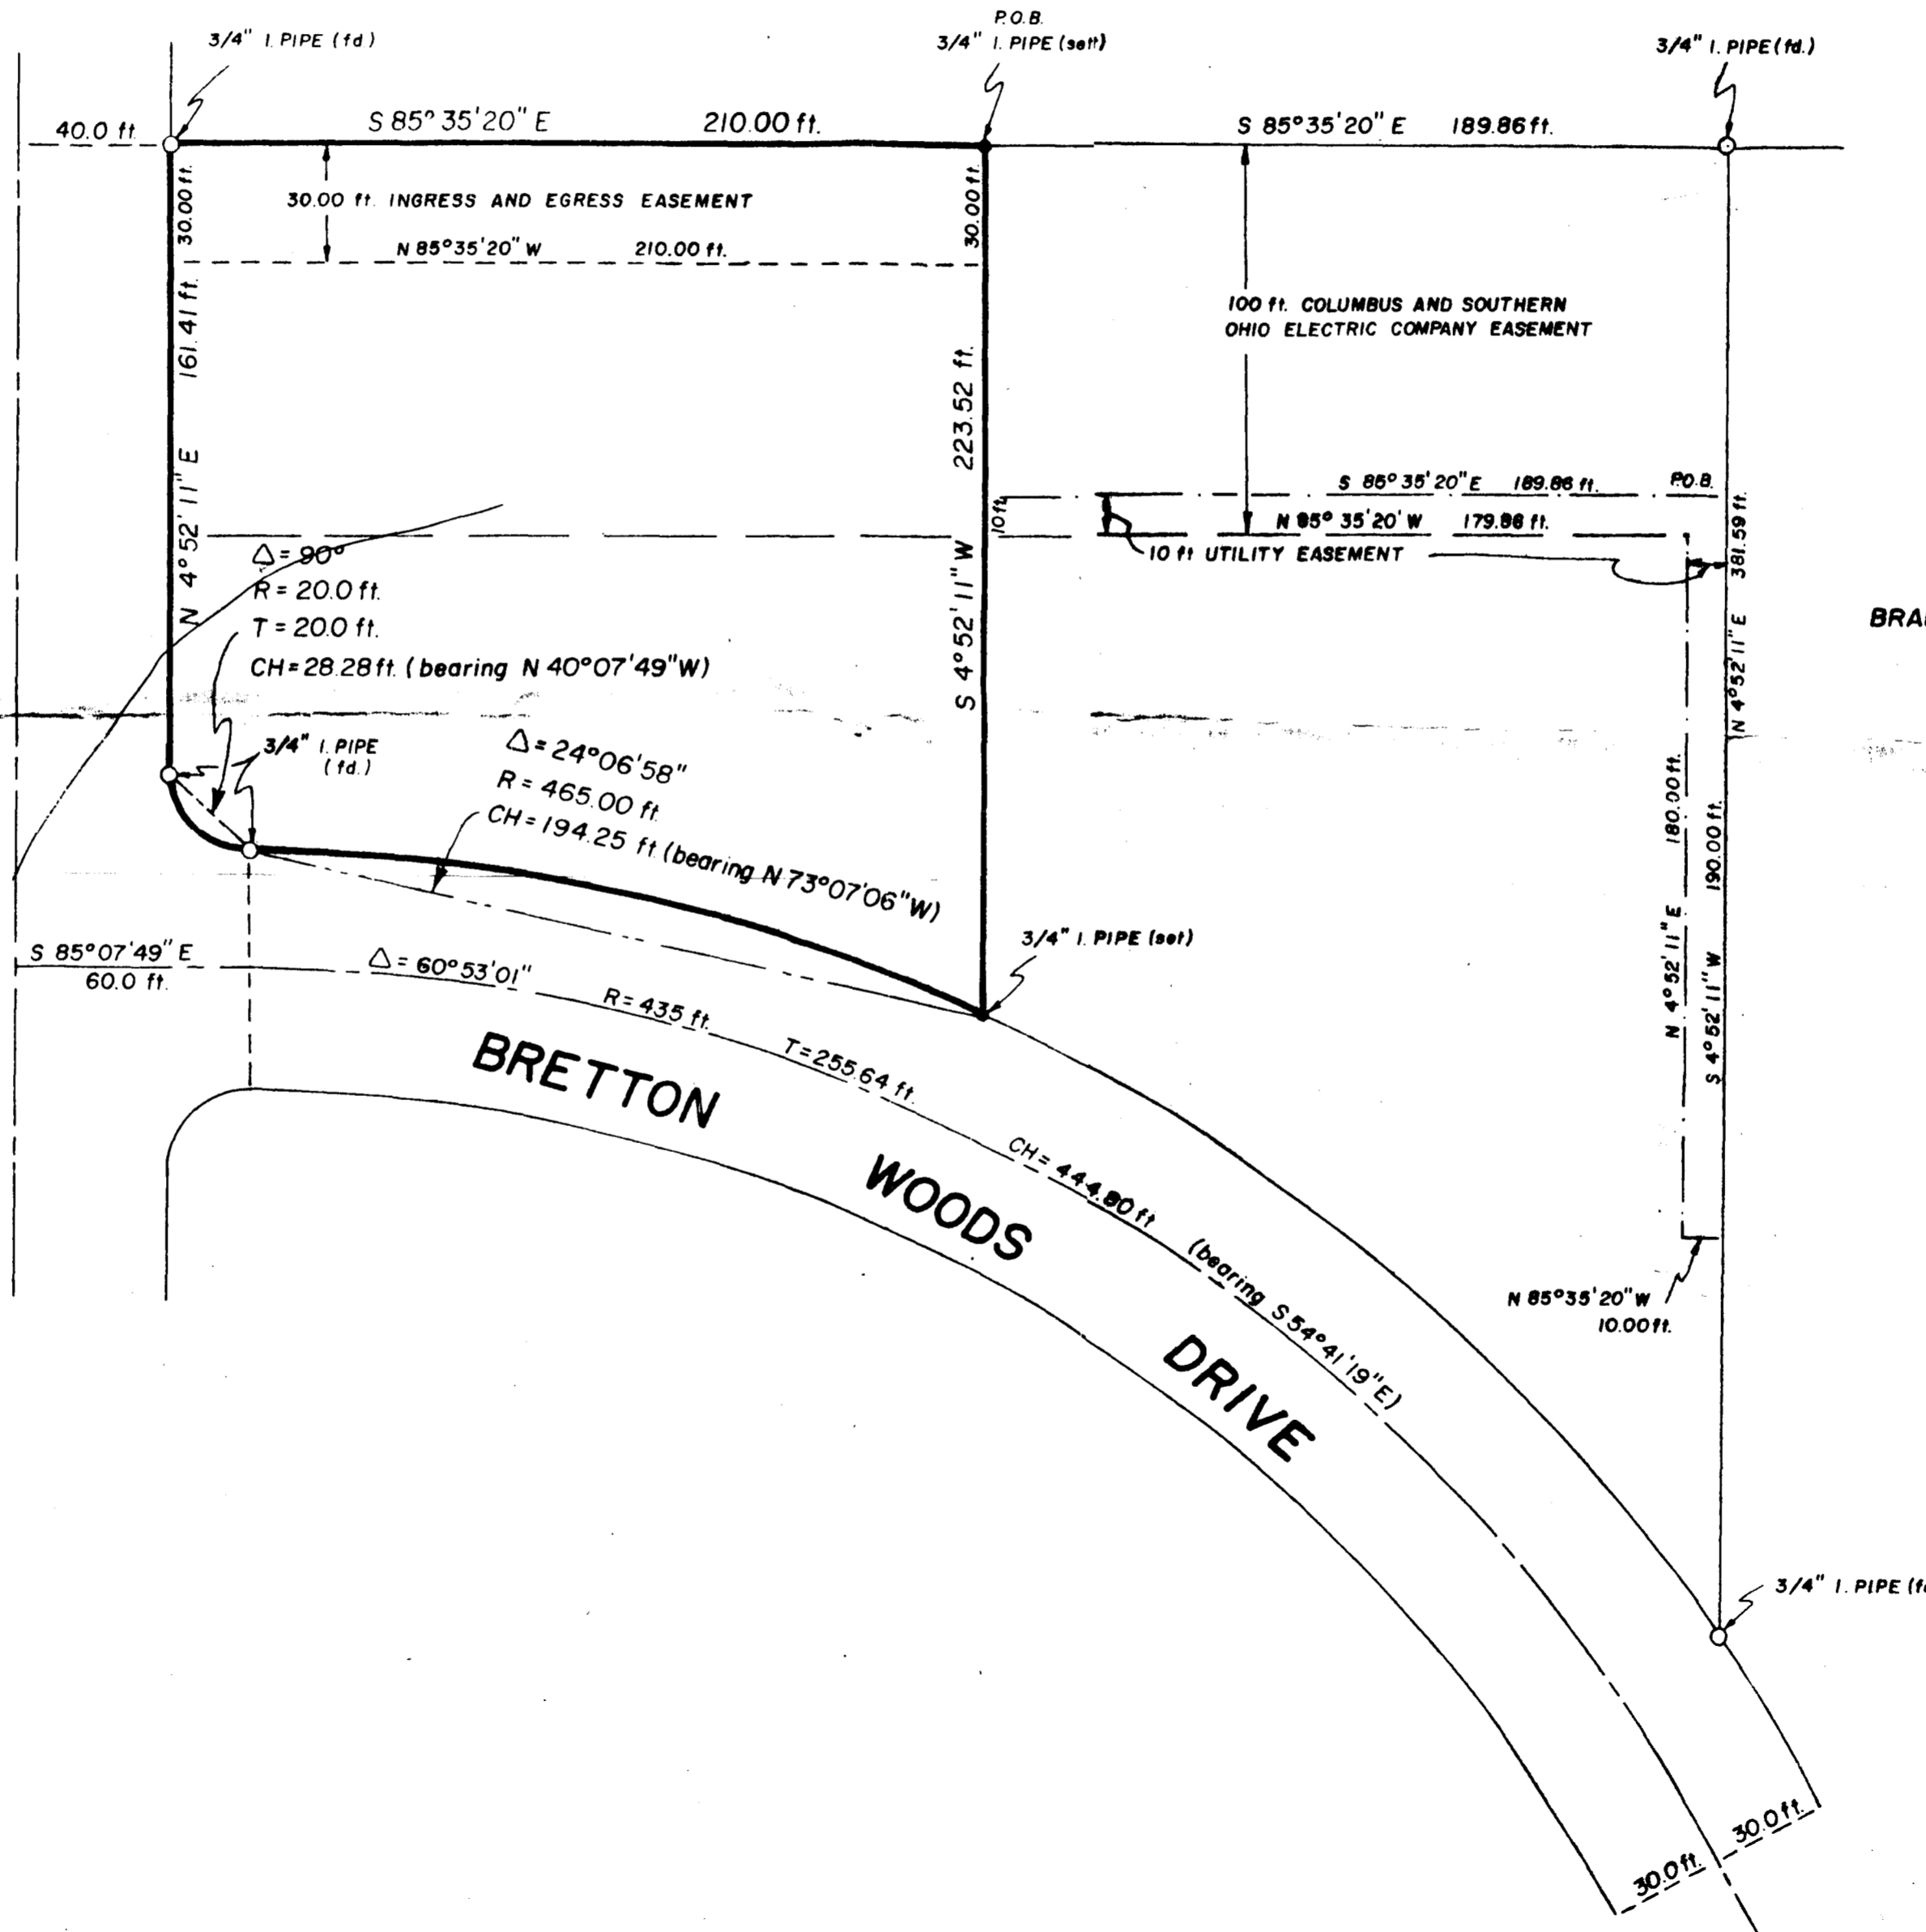

LOCKWOOD AND ASSOCIATES INC.
 1720 STRINGTOWN ROAD
 LANCASTER, OHIO 43130
 614 - 687 - 5542

I HEREBY CERTIFY THAT THIS
 CONFORMS TO A SURVEY PER-
 FORMED UNDER MY SUPER-
 VISION IN SEPTEMBER, 1985.

Gary R. Lockwood 11-25-85
 GARY R. LOCKWOOD DATE
 REGISTERED SURVEYOR NO. 6755

