

LOCATION MAP

UNCLAY
O.P.M. 12117, PG. 1-10
9.813 ACRES

DESCRIPTION



Beginning at an iron pin found at the southwestern corner of said Lot 2 and in the northern right-of-way line of Business Park Drive, 150.00 feet from centerline;









This description was prepared from a drawing, map, plan or sketch, based on information obtained from actual field surveys.

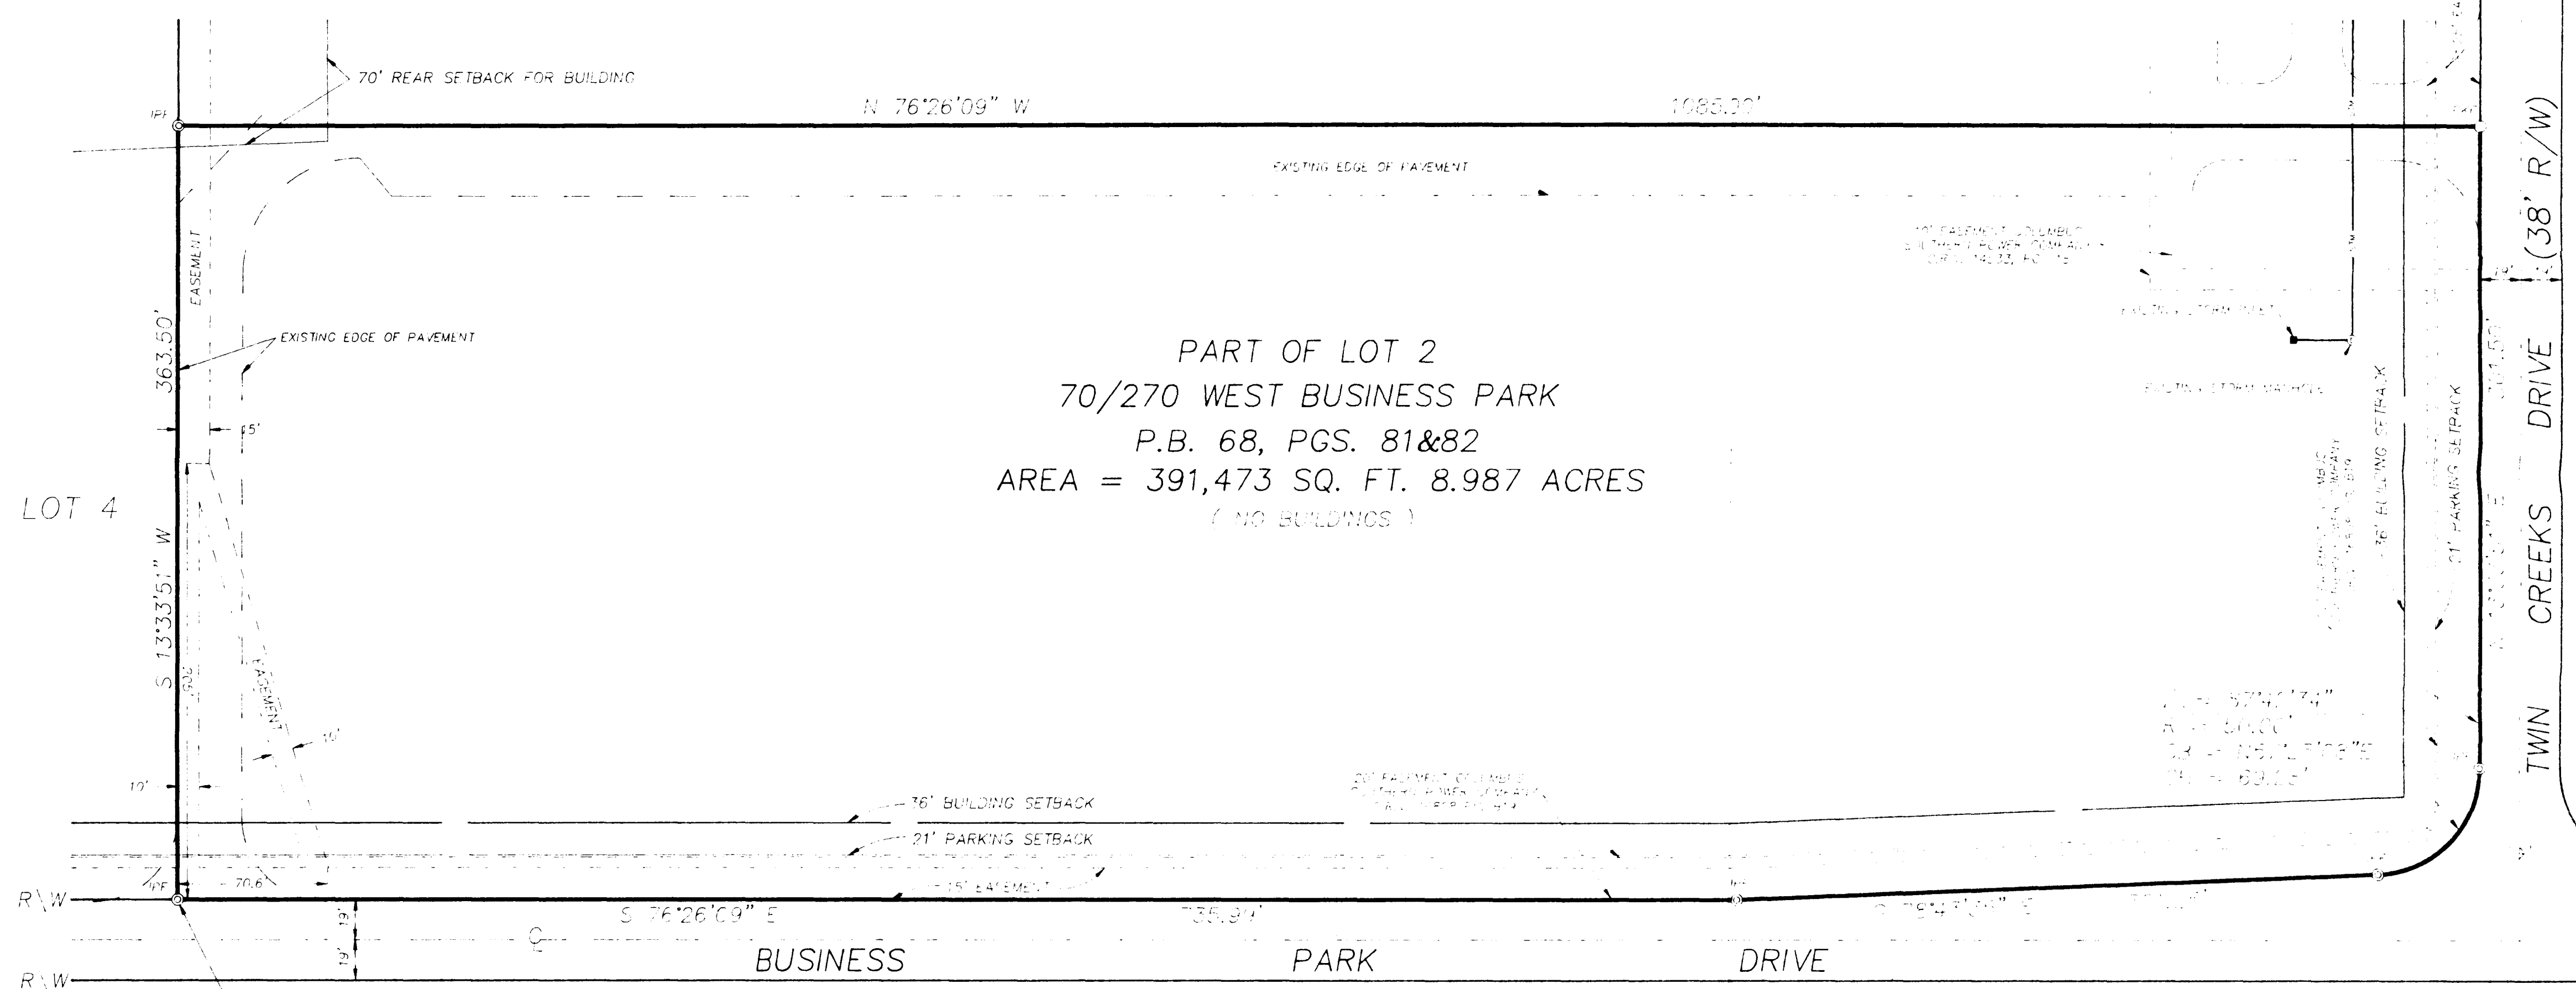

SURVEYOR'S CERTIFICATE

The undersigned hereby certifies to The Huntington National Bank and/or The Huntington Mortgage Company and/or their respective successors and assigns as their respective interest may appear and to Chicago Title Insurance Company, Chicago Title Agency of Central Ohio, Inc. and Business Park Company as of August 8, 1991 that this survey was actually made upon the ground; that it and the information, courses and distances shown thereon are accurate; that the title lines and lines of actual possession are the same; that the property description "closes" by engineering calculation; that this survey correctly shows the size, location and type of all buildings, structures and other improvements on the property and all are within the boundary lines and applicable set-back lines (whether established by subdivision plat, recorded restrictions or applicable zoning or building codes) affecting the property; that there are no easements or uses affecting the property appearing from a careful physical inspection of the same, other than those shown thereon; that all utility services necessary for the operation of the property are present on the property or within adjacent public right of way or recorded easement; that there are no encroachments on adjoining premises, streets or alleys by any of said buildings, structures or other improvements or encroachments upon the property by any building, structure or other improvement situated upon any adjoining premises; and that the property does not lie within any flood hazard area shown on any U.S. Department of H.U.D. Flood Insurance Boundary Map or special flood hazard area map published by the Federal Emergency Management Agency. This survey was made in accordance with the "Minimum Standard Detail Requirements for Land Title Surveys" jointly established by ALTA and ACSM in 1986 and meets the accuracy requirements of a Class A Survey, as defined therein.

NOTES

- FACEMENTS SHOWN HEREON ARE FLATTEN UNLESS OTHERWISE NOTED.
- THE LOT SHOWN HEREON IS IN THE 570 TAX DISTRICT.
- THE PROPERTY SHOWN HEREON IS NOT WITHIN A FLOOD HAZARD AREA ACCORDING TO F.E.M.A. MAPS FOR THE CITY OF COLUMBUS PANEL NUMBERS 390170 00558 AND 390170 00100.
- BEARINGS SHOWN HEREON ARE BASED ON THOSE OF THE PLAT "70/270 WEST BUSINESS PARK," P.B. 68, PGS. 81 & 82.

REVISIONS	DESCRIPTION
DATE	BY

M-E ENGINEERING INC.
CIVIL DIVISION
500 So. FRONT STREET
COLUMBUS, OHIO 43215
PHONE: (614) 469-4903
FAX: (614) 469-4989

MORTGAGE SURVEY
PART OF LOT 2
70/270 WEST BUSINESS PARK
COLUMBUS, OHIO

FIELD	PM	DRAWN
	BW	DC
SCALE	HORIZ. 1" = 50'	
	VERT.	
JOB	893020-1-1-26	
DATE	JULY 1991	
SHEET NO.	1/1	
	PRINT DATE	

REGISTERED SURVEYOR NO. 11111
DATE

August 8, 1991