
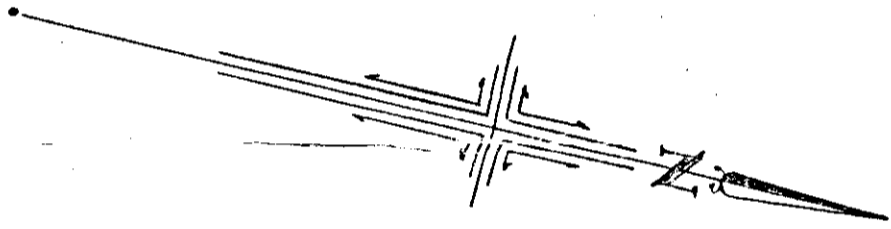


F-20

Survey BK 2
Pg. 272

DAKOTA AVE.

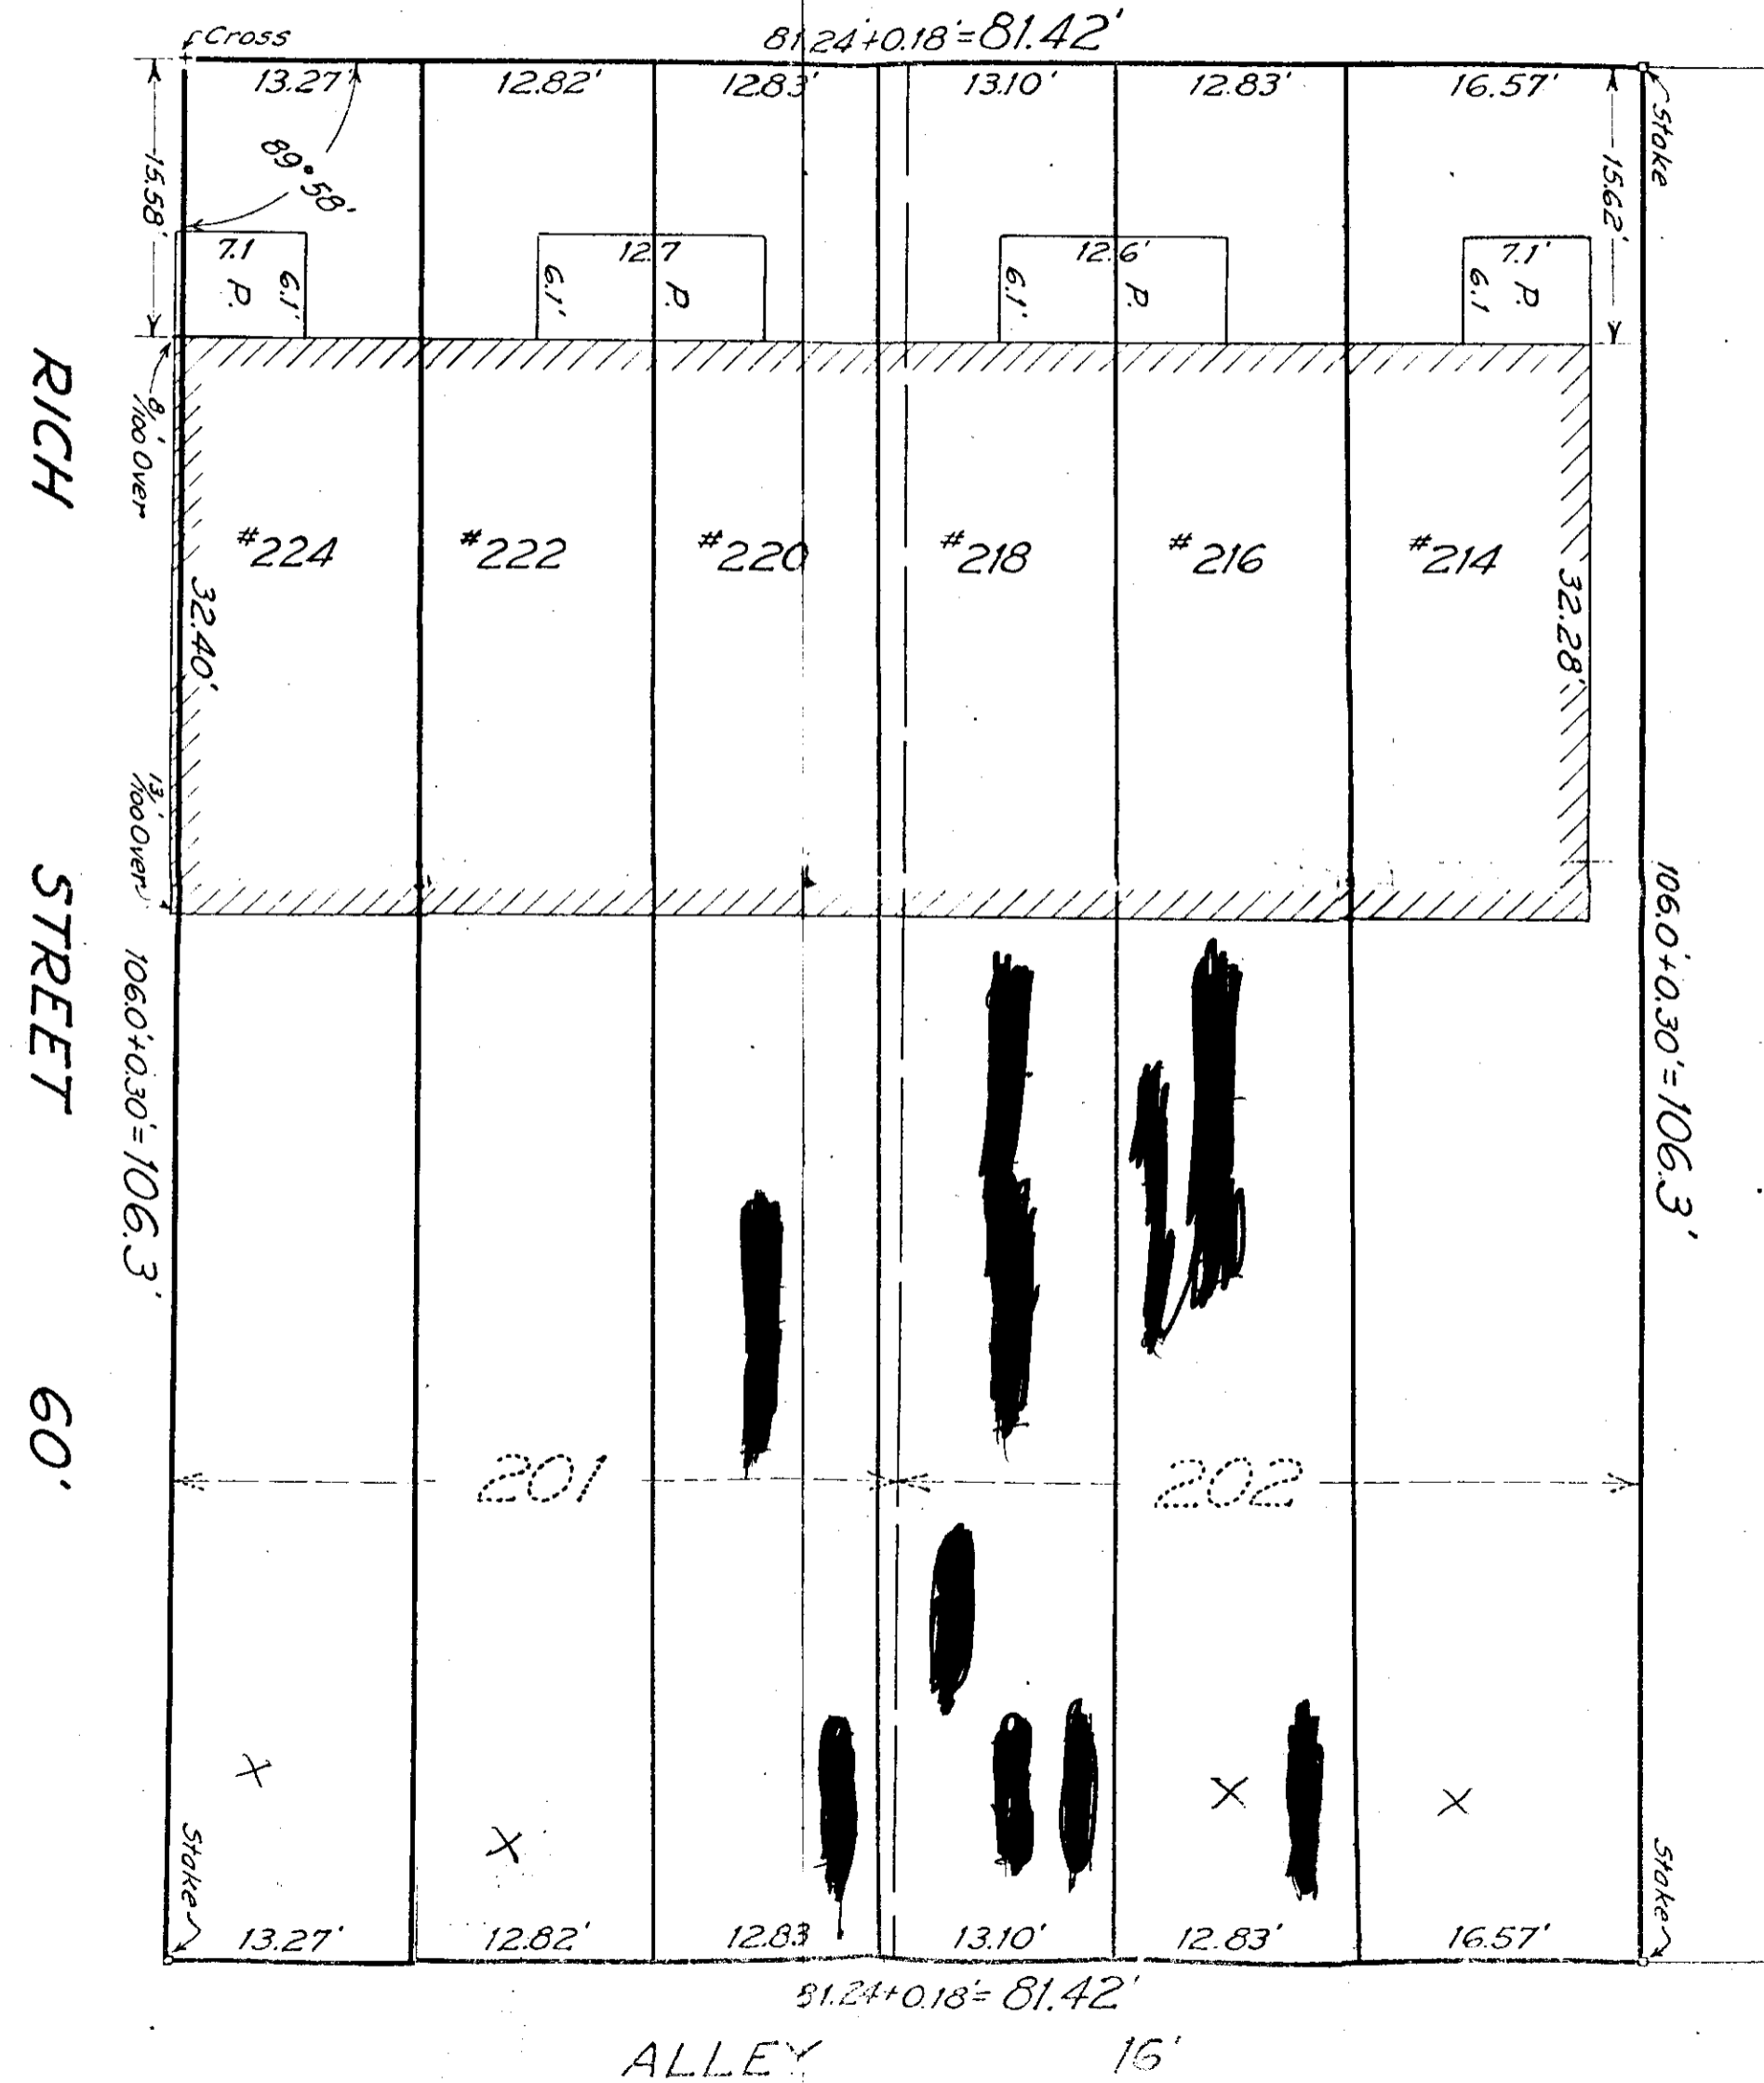

F-20

DIVISION OF LOTS 201 & 202
WEST PARK ADDITION, COLUMBUS, OHIO
FOR

SHAENLY COMPANY
SCALE 1"=10'
JAN 18, 1949
THE JENNINGS-LAWRENCE CO.
CIVIL & MUNICIPAL ENGINEERS
COLUMBUS, OHIO

By R. J. Durrell
REGISTERED SURVEYOR