
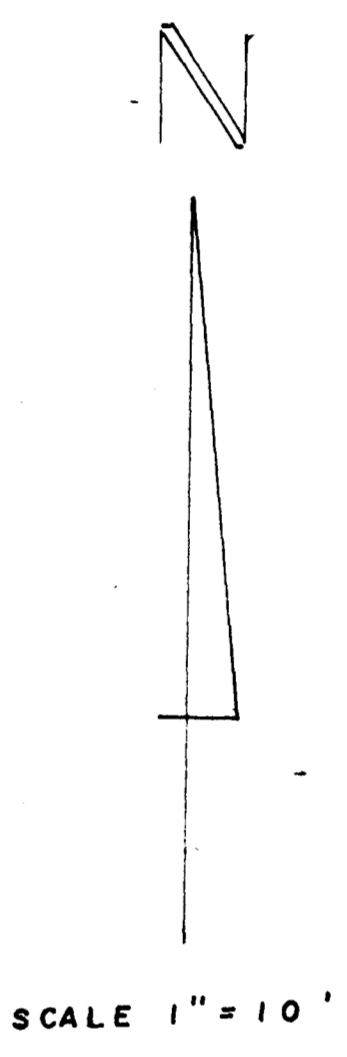
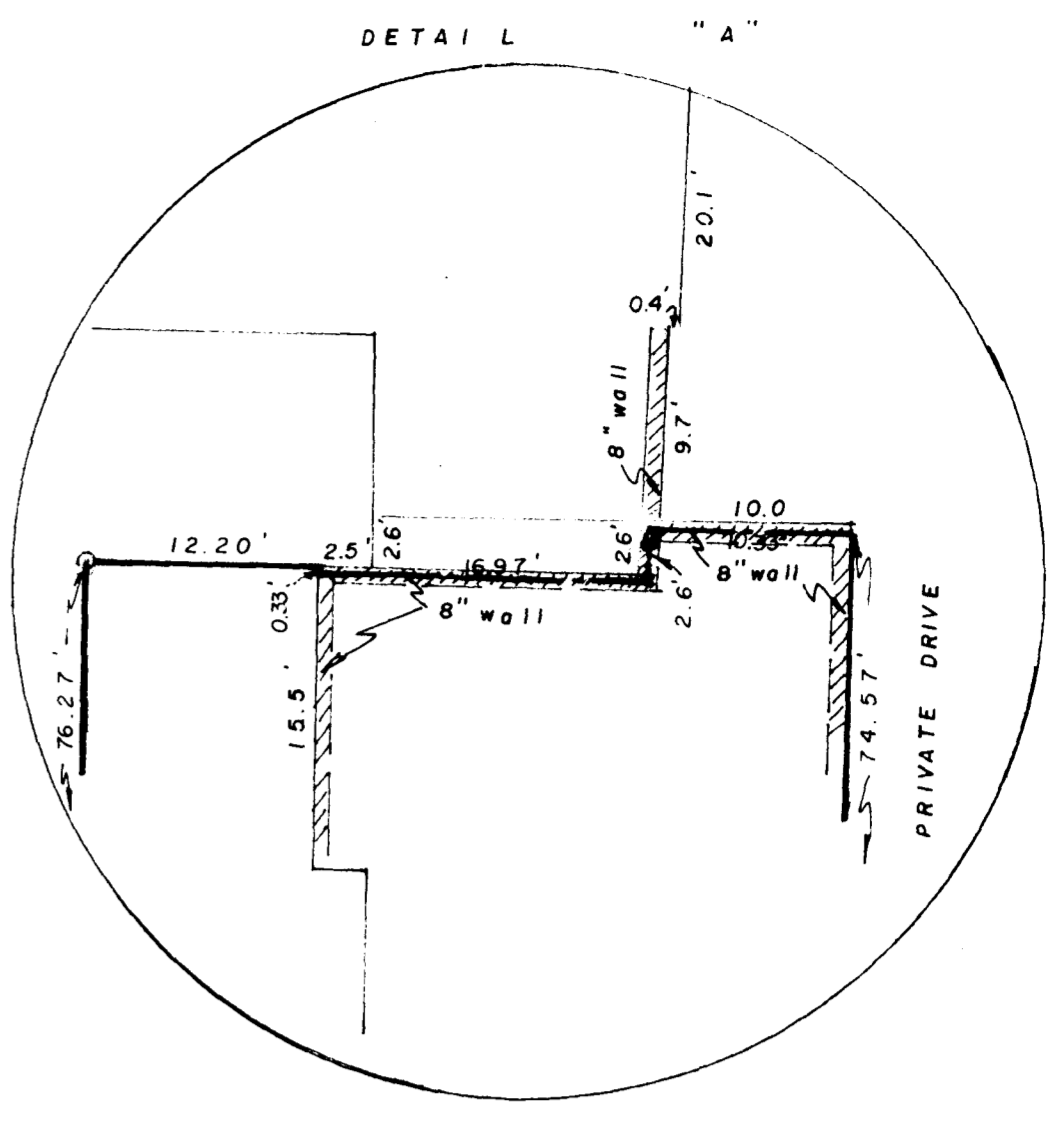


L-25

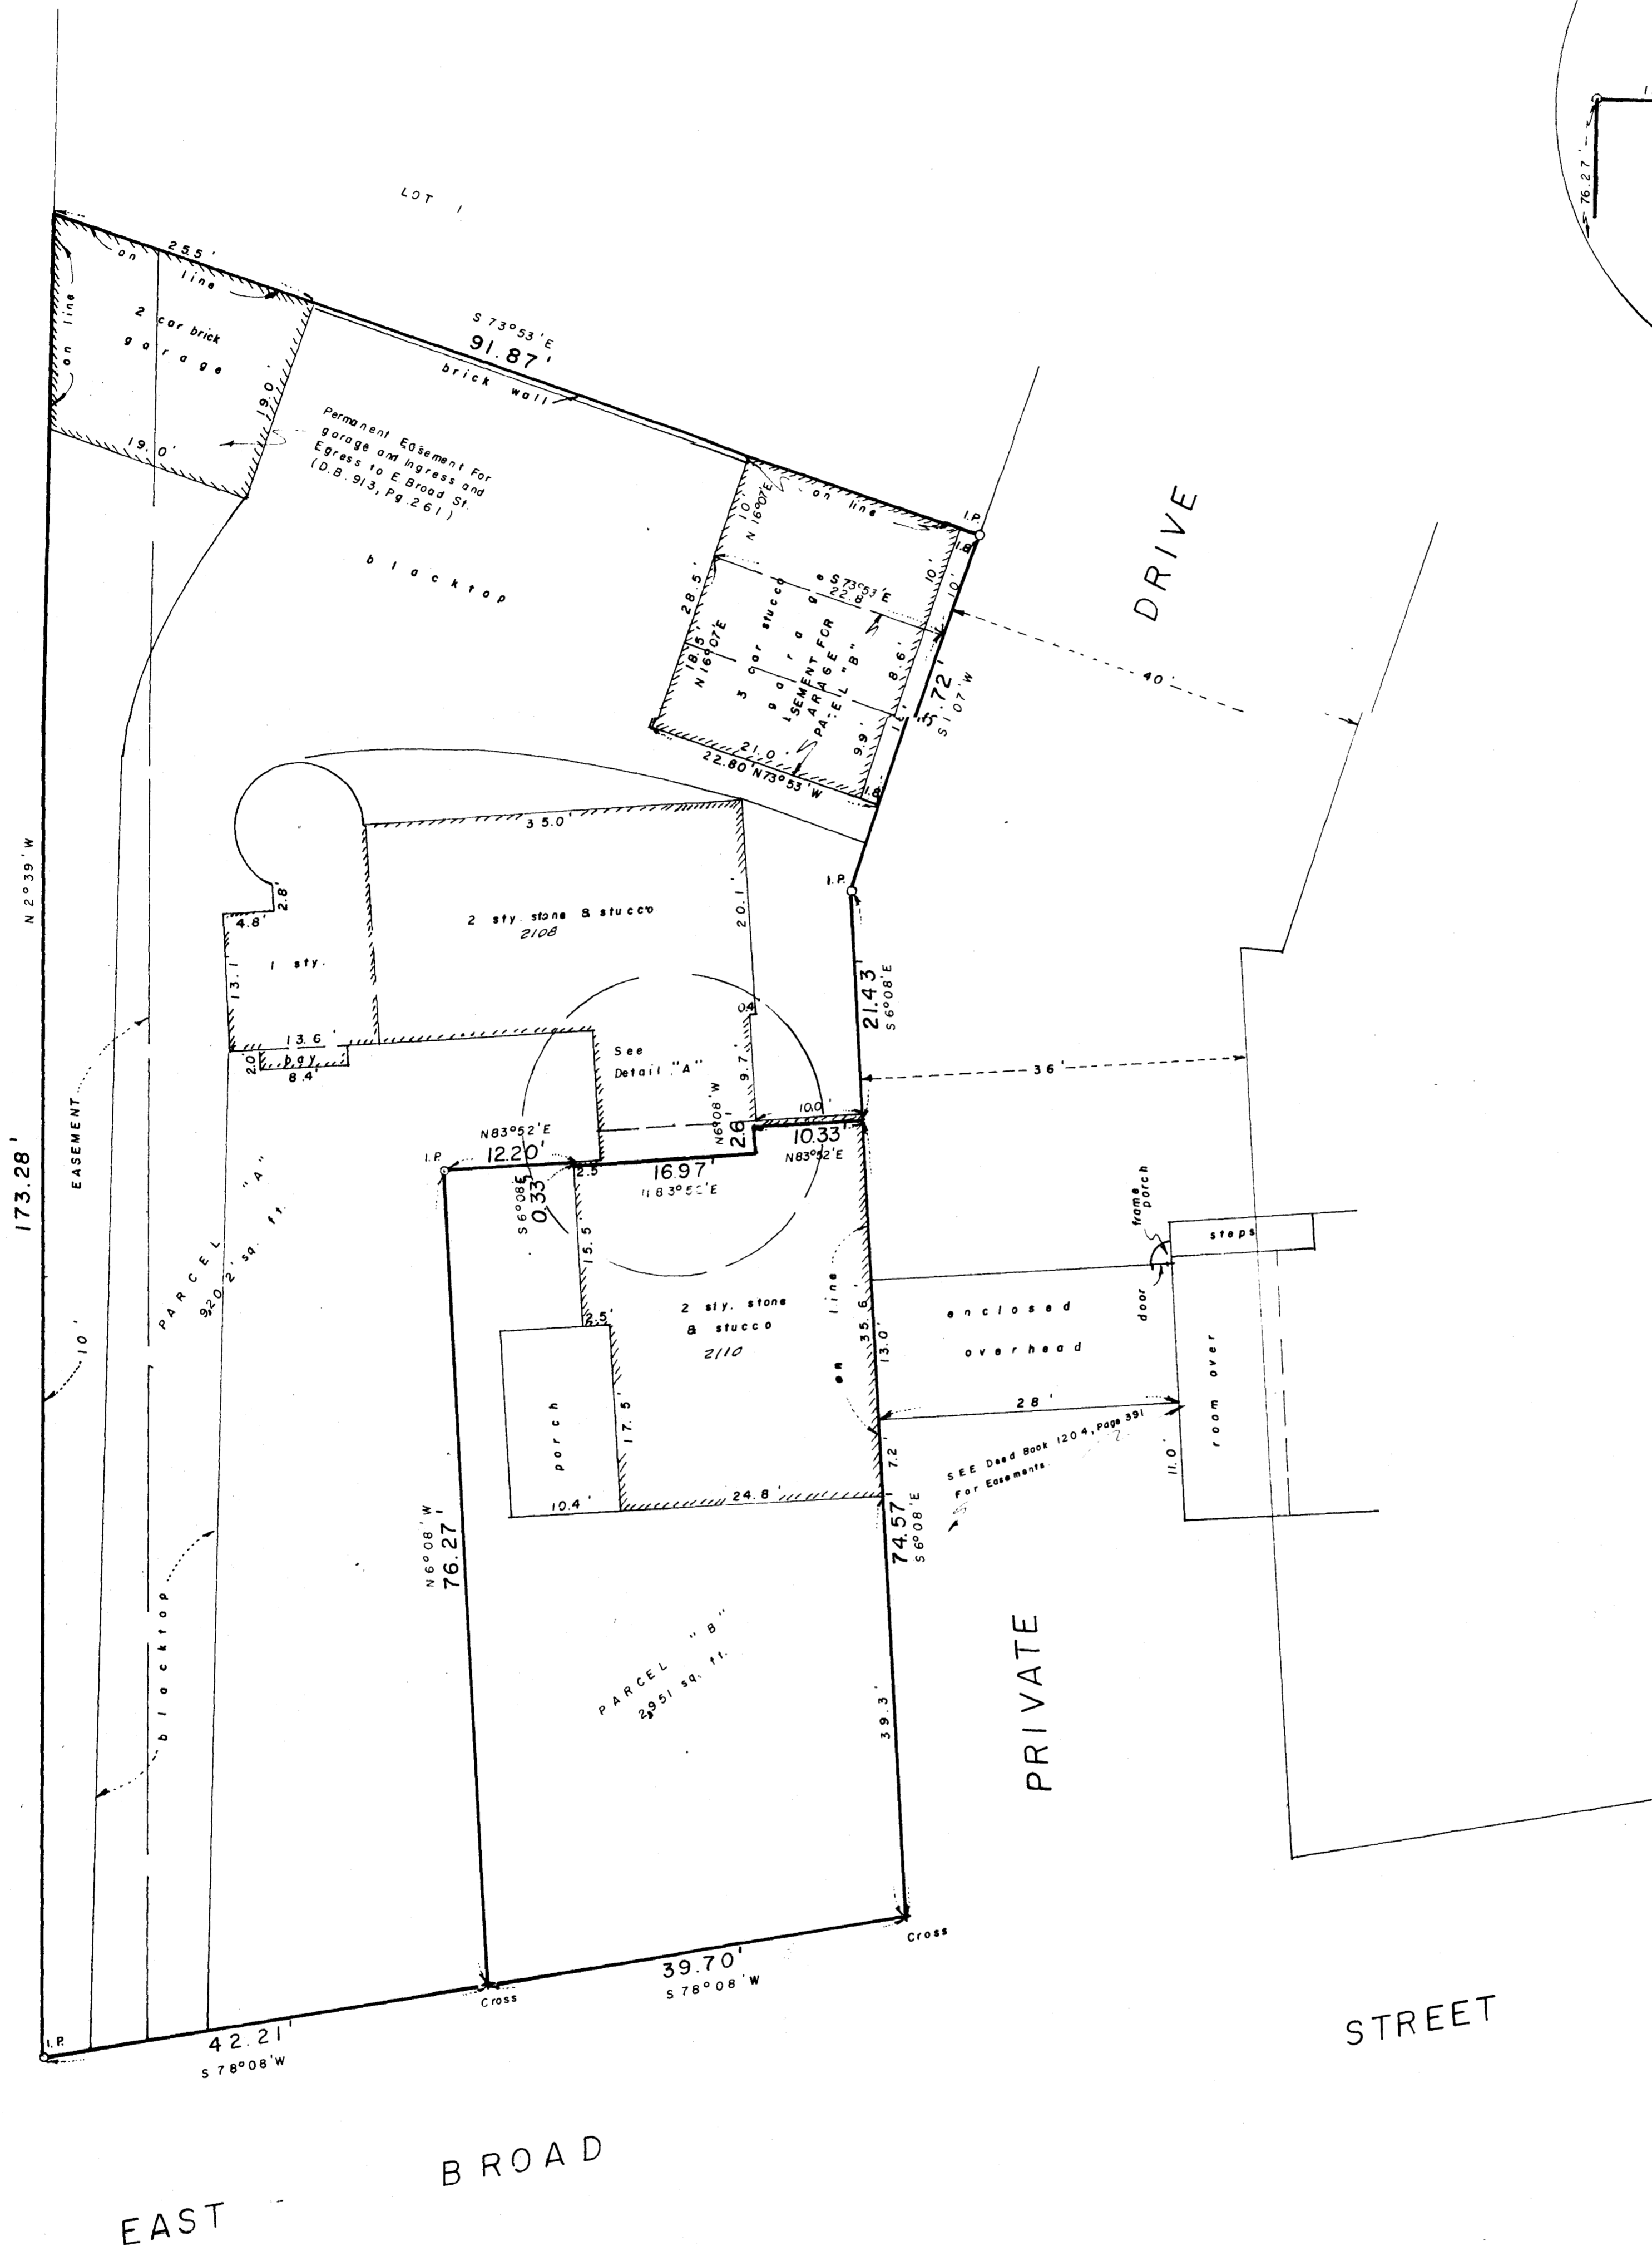

PLAT OF SURVEY OF LOT 29, SESSIONS,
 AS RECORDED IN PLAT BOOK 19, PAGE 44, (RECORDER'S
 OFFICE, FRANKLIN COUNTY, OHIO), SITUATED IN THE
 CITY OF BEXLEY, OHIO

for
 MR. JOE RECCHIE

I hereby certify that the foregoing
 plat represents a true return of survey
 made by me in December, 1977
 By *Albert O. Myers Jr.*
 Albert O. Myers Jr. Registered Surveyor # 3352

MYERS SURVEYING COMPANY
 Civil Engineers and Surveyors
 Columbus, Ohio

December 5, 1977