


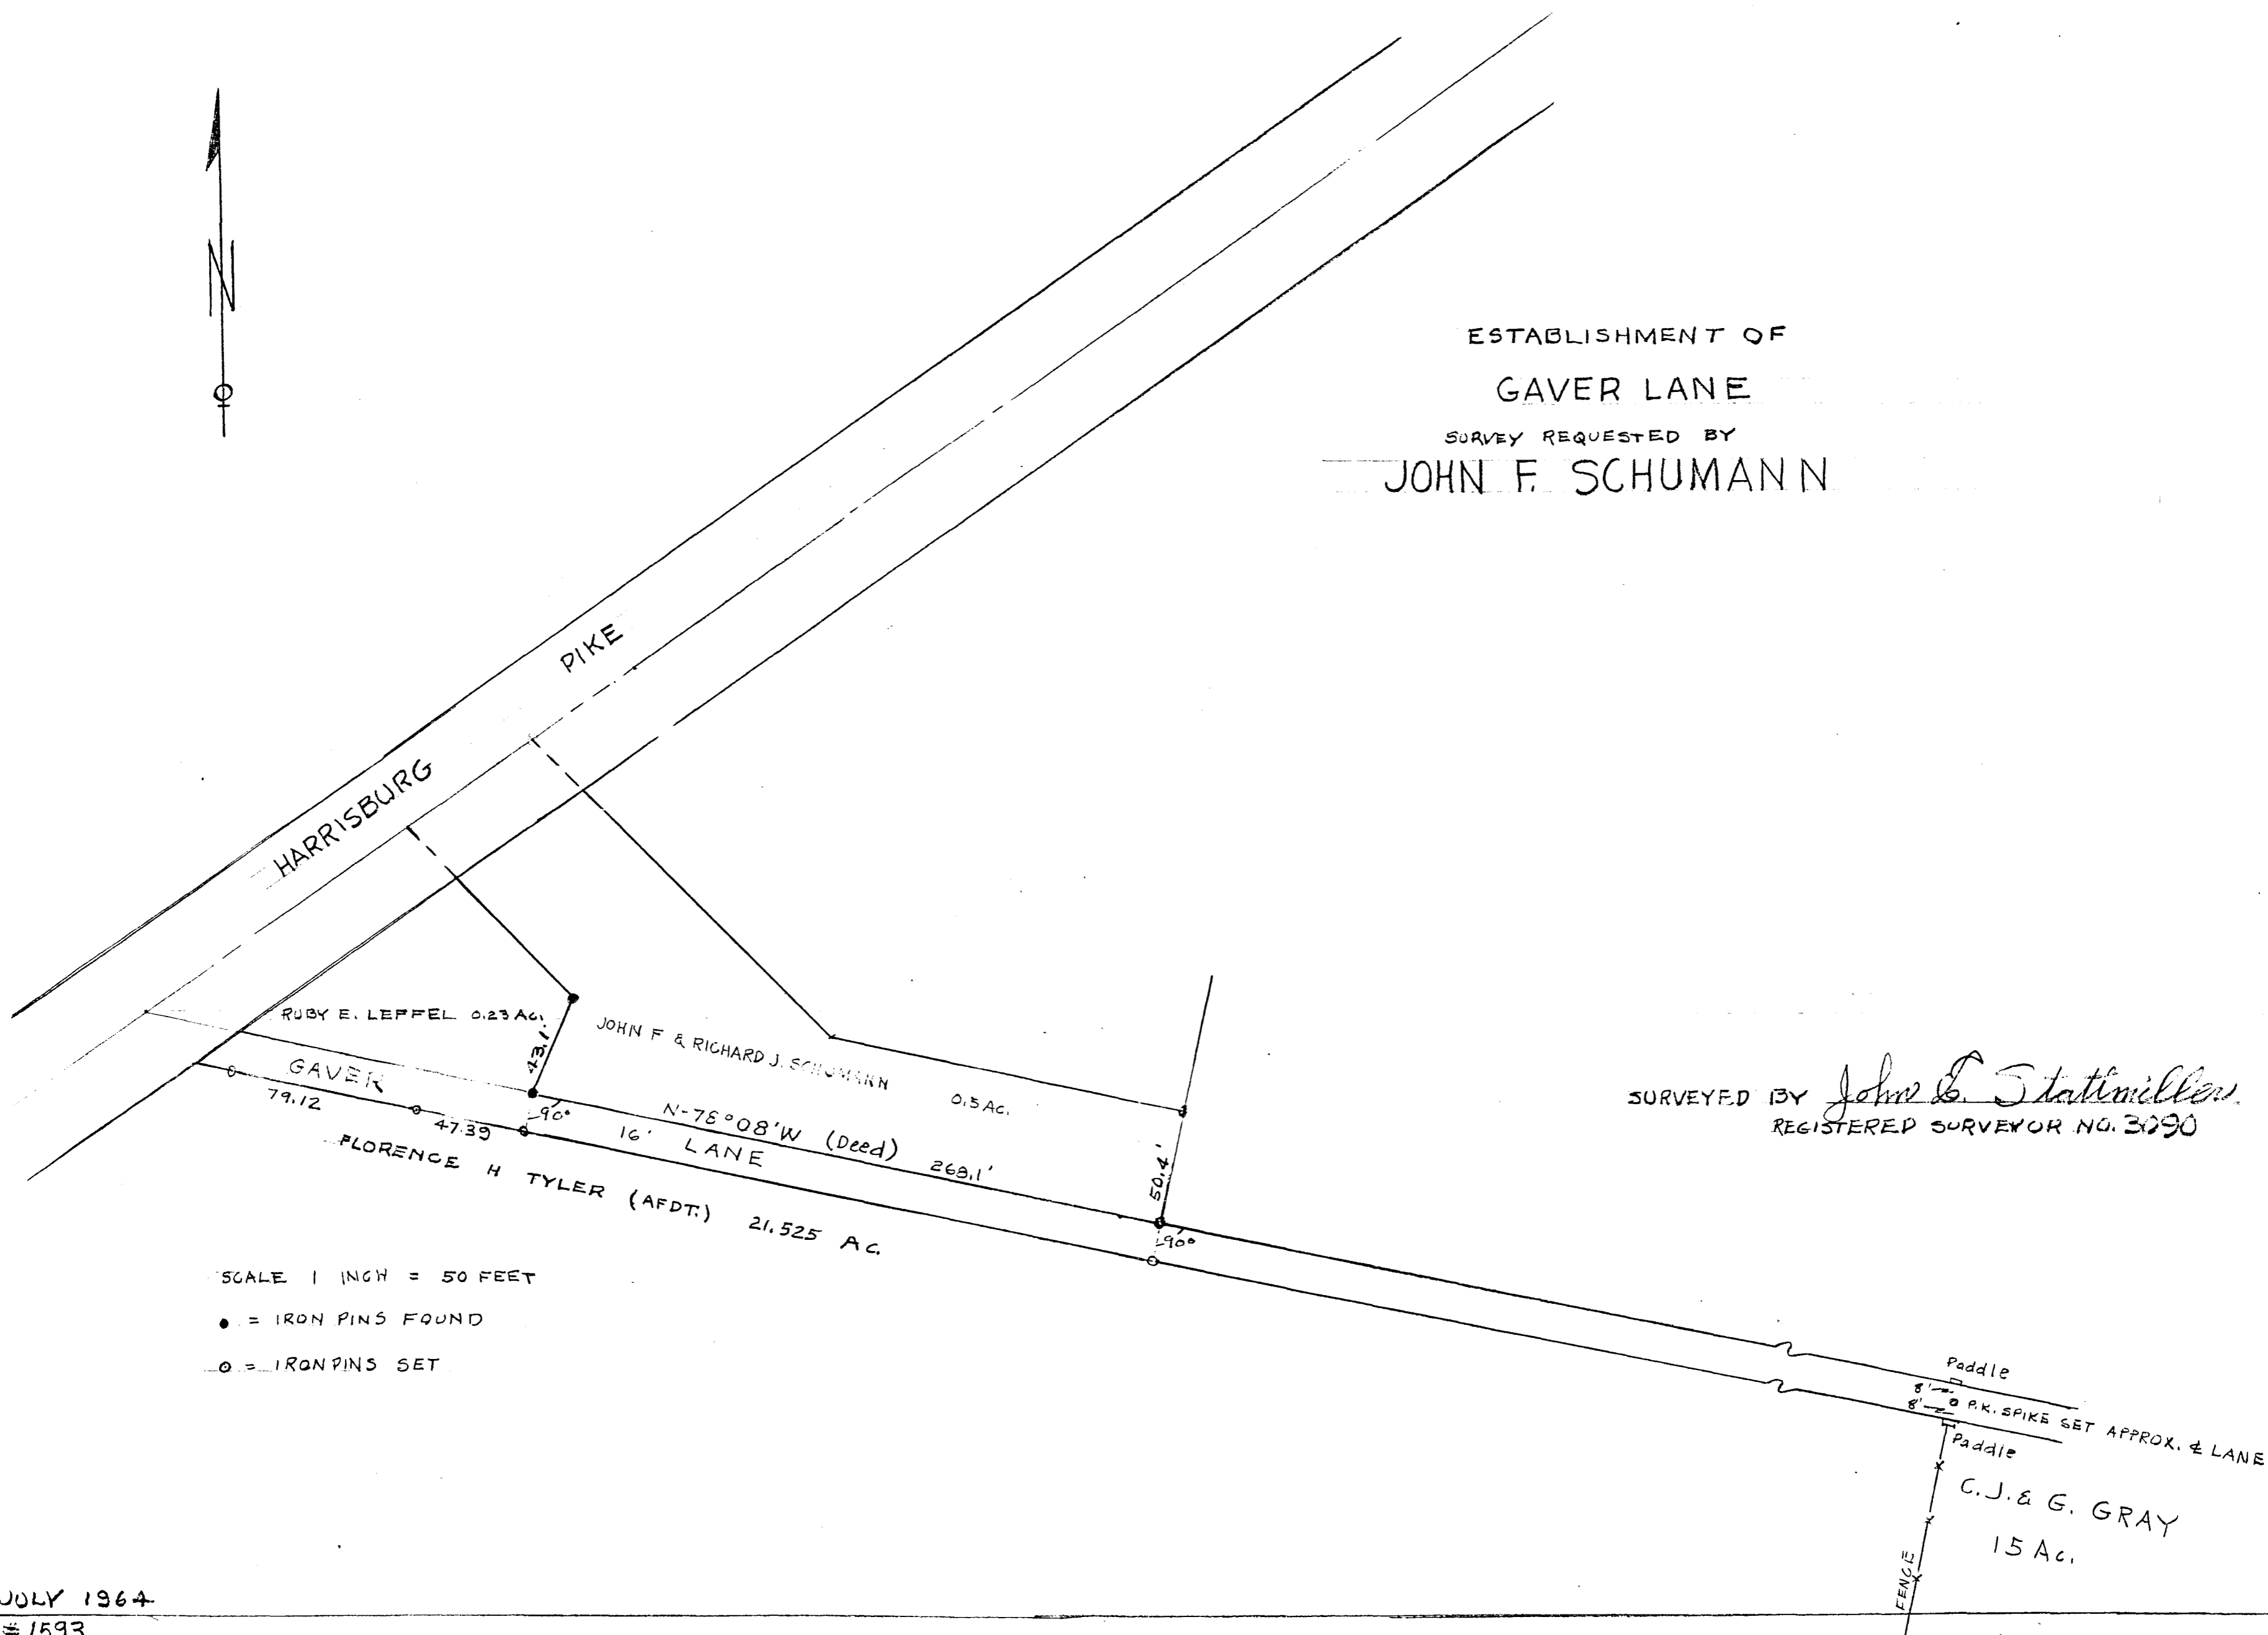

ESTABLISHMENT OF
 GAVER LANE
 SURVEY REQUESTED BY
 JOHN F. SCHUMANN



SURVEYED BY *John E. Statton*
 REGISTERED SURVEYOR NO. 3090

SCALE 1 INCH = 50 FEET
 ● = IRON PINS FOUND
 ○ = IRON PINS SET