


82-44-35  
2-49-53  
71-54-72

forced  
See new plat No  
@ bottom of sheet

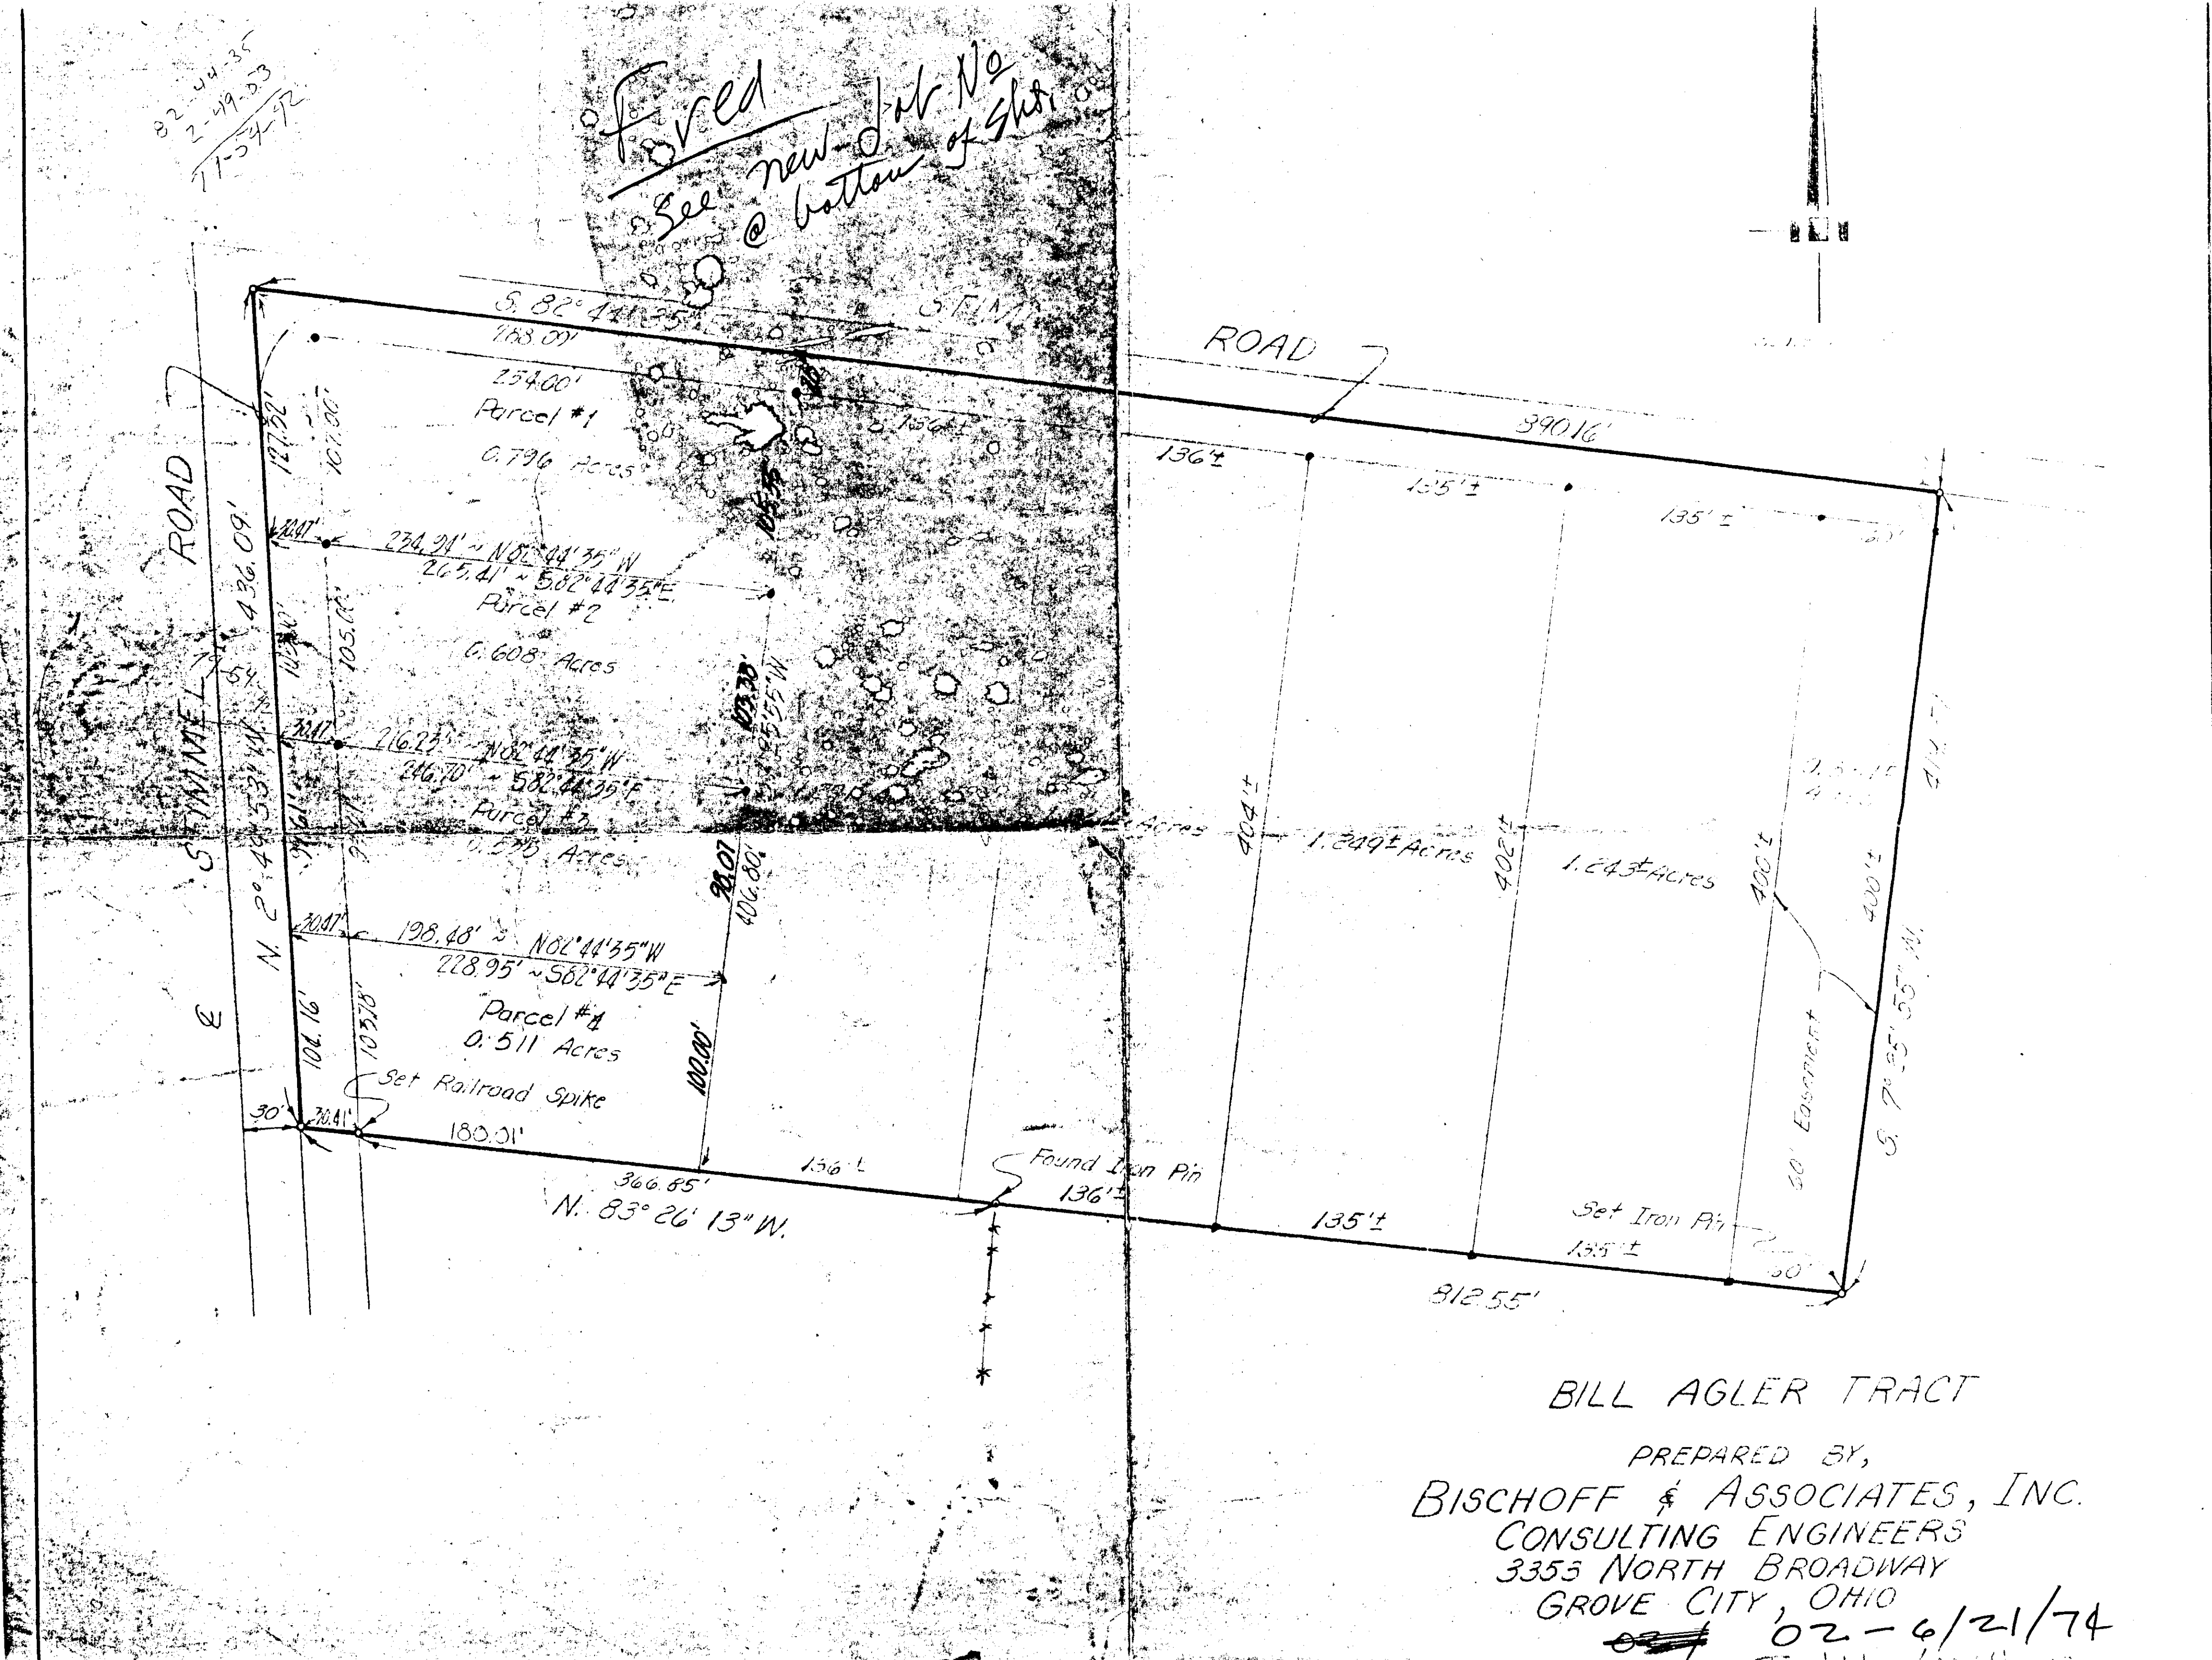

BILL AGLER TRACT

PREPARED BY,  
BISCHOFF & ASSOCIATES, INC.  
CONSULTING ENGINEERS  
3355 NORTH BROADWAY  
GROVE CITY, OHIO  
02-6/21/74