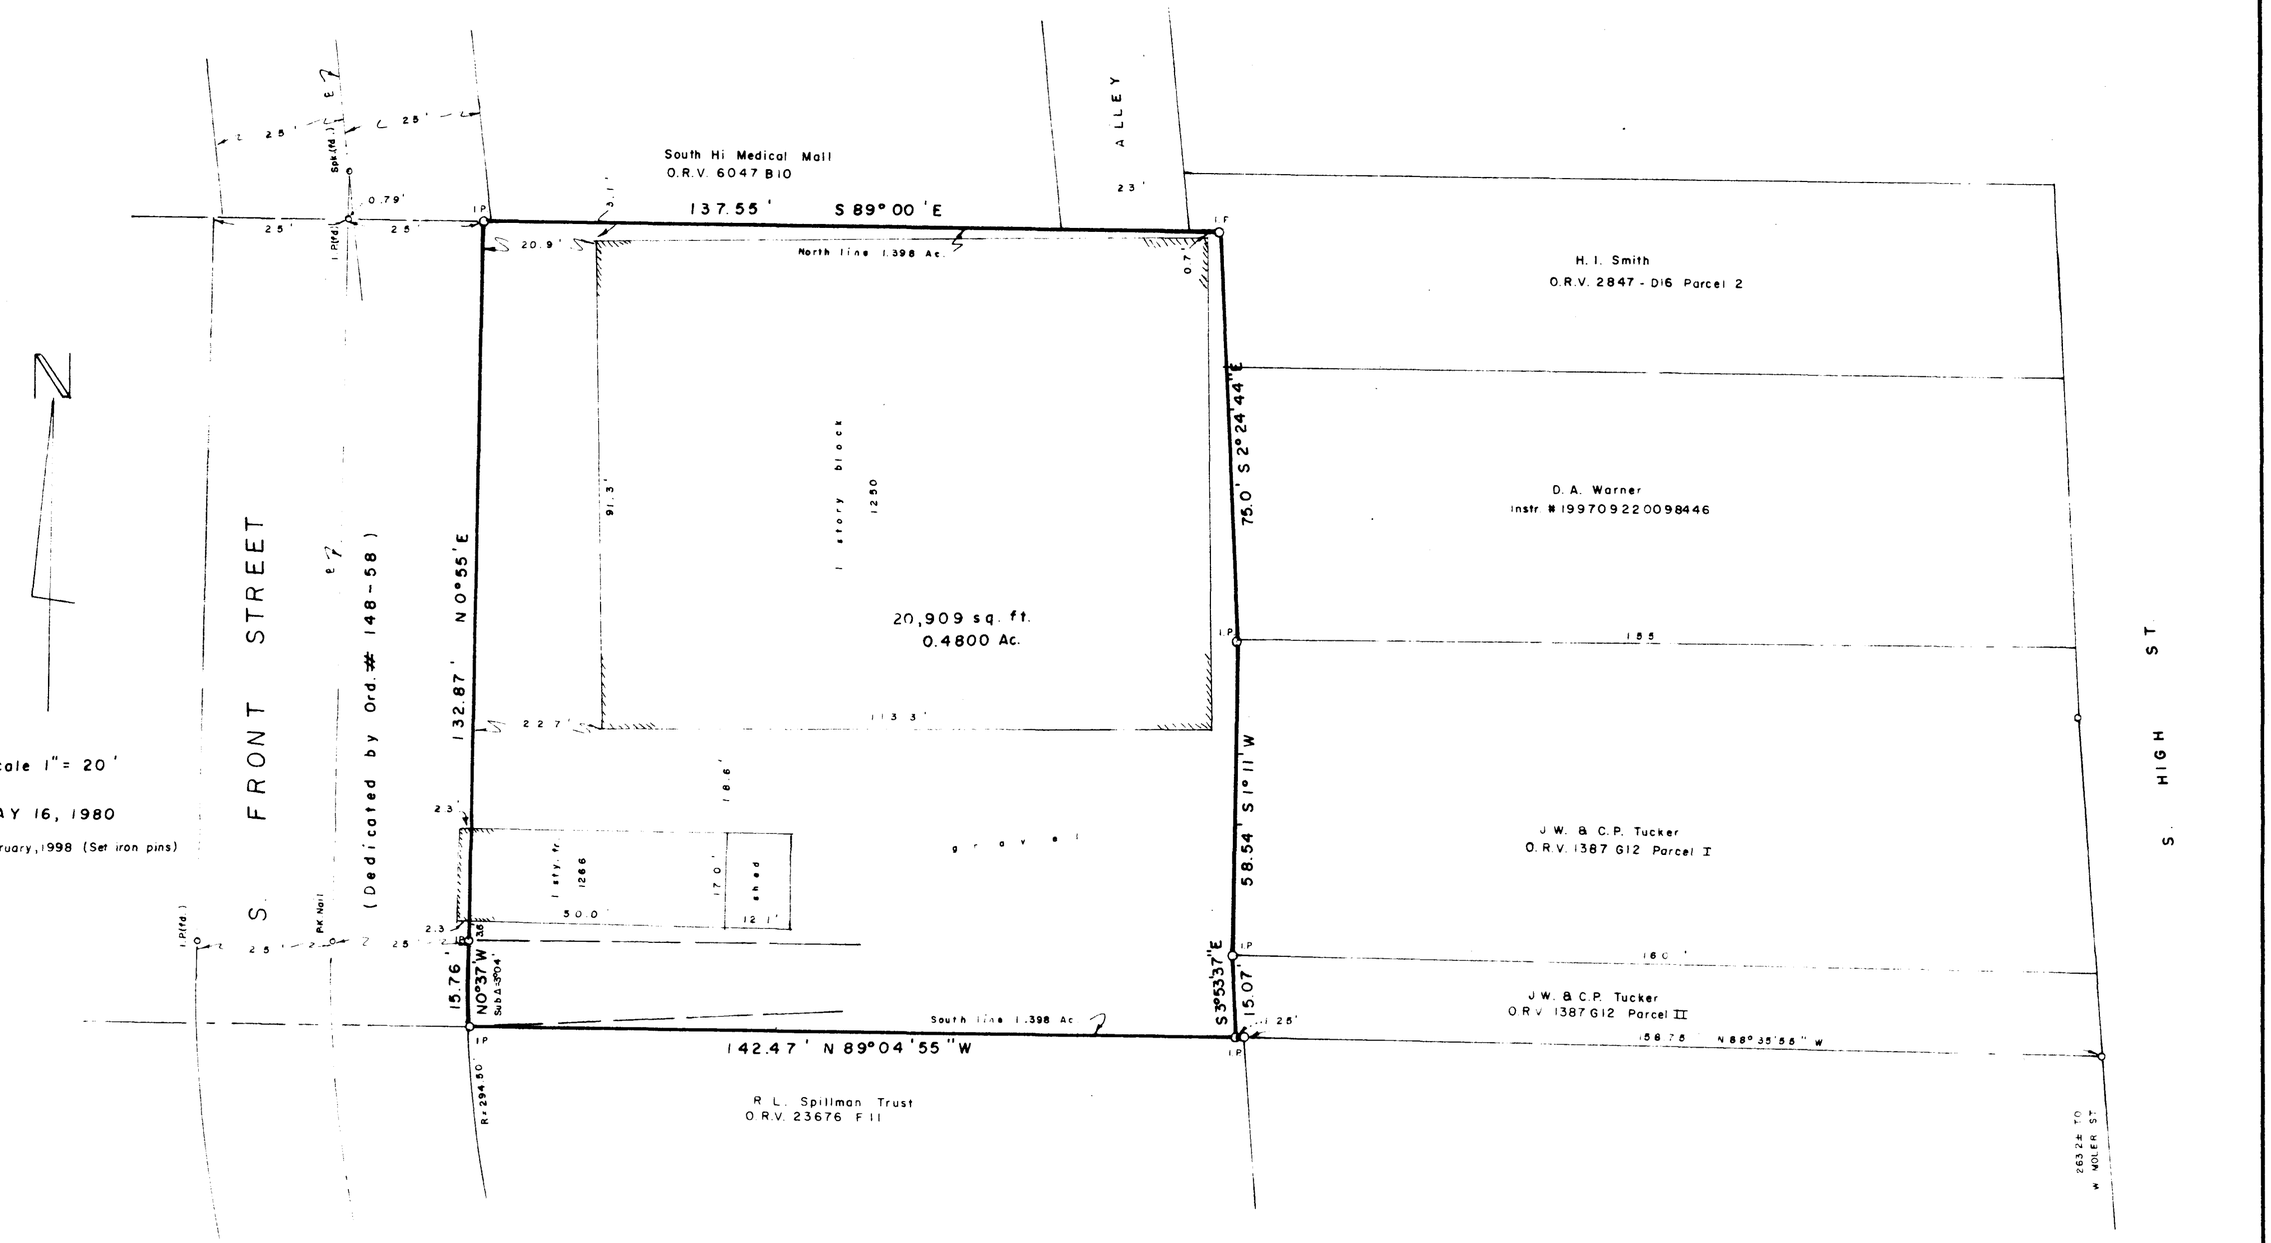

SURVEY OF 0.4800 ACRES, PART OF AN ORIGINAL 1.398 AC. TRACT CONVEYED TO R.L. SPILLMAN (D.B. 2065, PG. 453, PARCEL 1, RECORDER'S OFFICE, FRANKLIN COUNTY), IN HALF SECTION 29, TOWNSHIP 5, RANGE 22, REFUGEE LANDS, COLUMBUS, OHIO

For

ROBERT L. SPILLMAN

We hereby certify that the foregoing Boundary Survey was prepared from actual field measurements in accordance with Chapter 4733-37 Ohio Administrative Code. Iron pins set are 30"x1" O.D. with an orange plastic plug inscribed "P.S. 6579", unless otherwise noted. Basis of bearing is assumed to be North 88 degrees 28 minutes 00 seconds West on the south line of the Robert L. Spillman Trust tract.

Paul T. Dinan

PAUL T. DINAN P.S. 7312

Myers Surveying COMPANY
2740 East Main Street
Bexley, Ohio 43209-2577
(614) - 235 - 8677