


SITUATED IN THE STATE OF OHIO, COUNTY OF FRANKLIN, CITY OF COLUMBUS,
 & BEING 13.548 Ac. & 35.365 Ac. DIVIDING A 48.913 Ac. TRACT,
 (49.49 Ac. DEED) IN THE NAME OF
WEST 5TH AUTO THEATRE INC.
 D.B. 1881, PAGE 216, RECORDER'S OFFICE, FRANKLIN CO. OHIO.

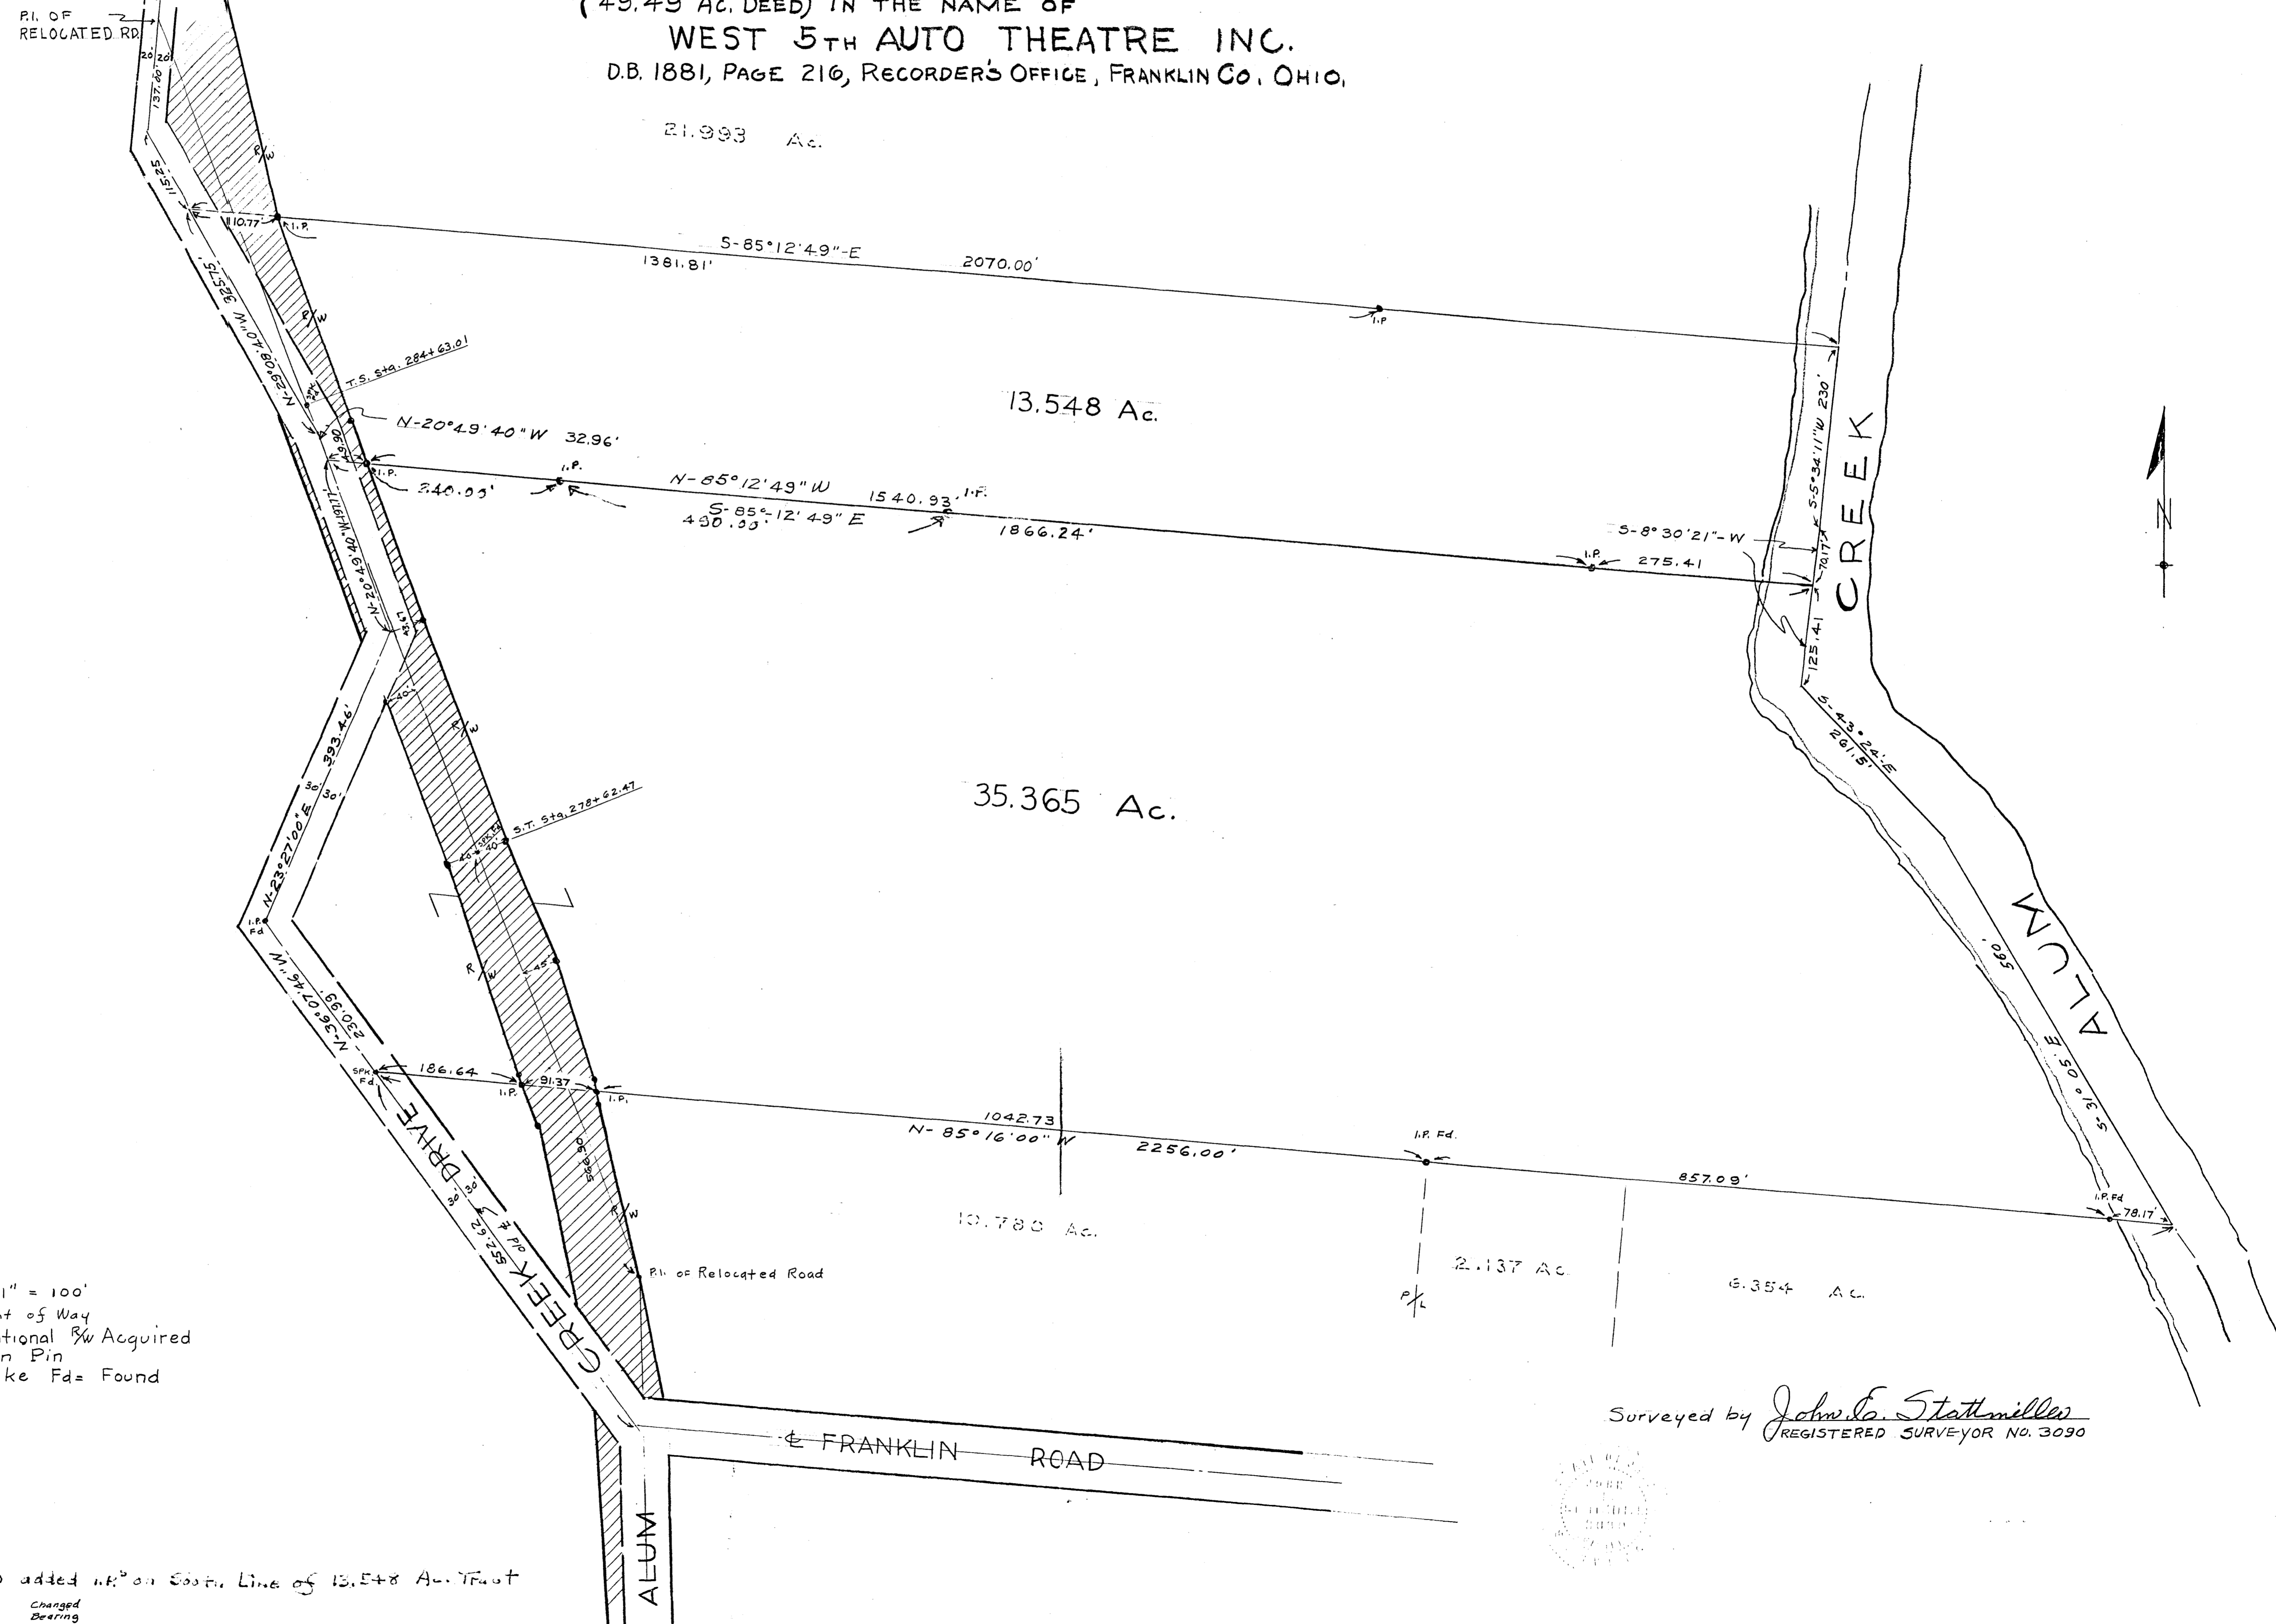

SCALE 1" = 100'
 RW = Right of Way
 [Hatched Area] = Additional RW Acquired
 I.P. = Iron Pin
 SPK. = Spike Fd = Found

Surveyed by *John E. Stathmiller*
 REGISTERED SURVEYOR NO. 3090

June 23, 1960 added I.P. on Sbst. Line of 13.548 Ac. Tract
 Changed Bearing
 June 18, 1960 - 6-23-60