


Being part of a 29.72 acre tract of land in the name of Geo. J. Rohr (DB-1294- Page 145) in the N.E. 1/4 Sec. 2, Tp. 4, City of Columbus, Franklin Co. Ohio

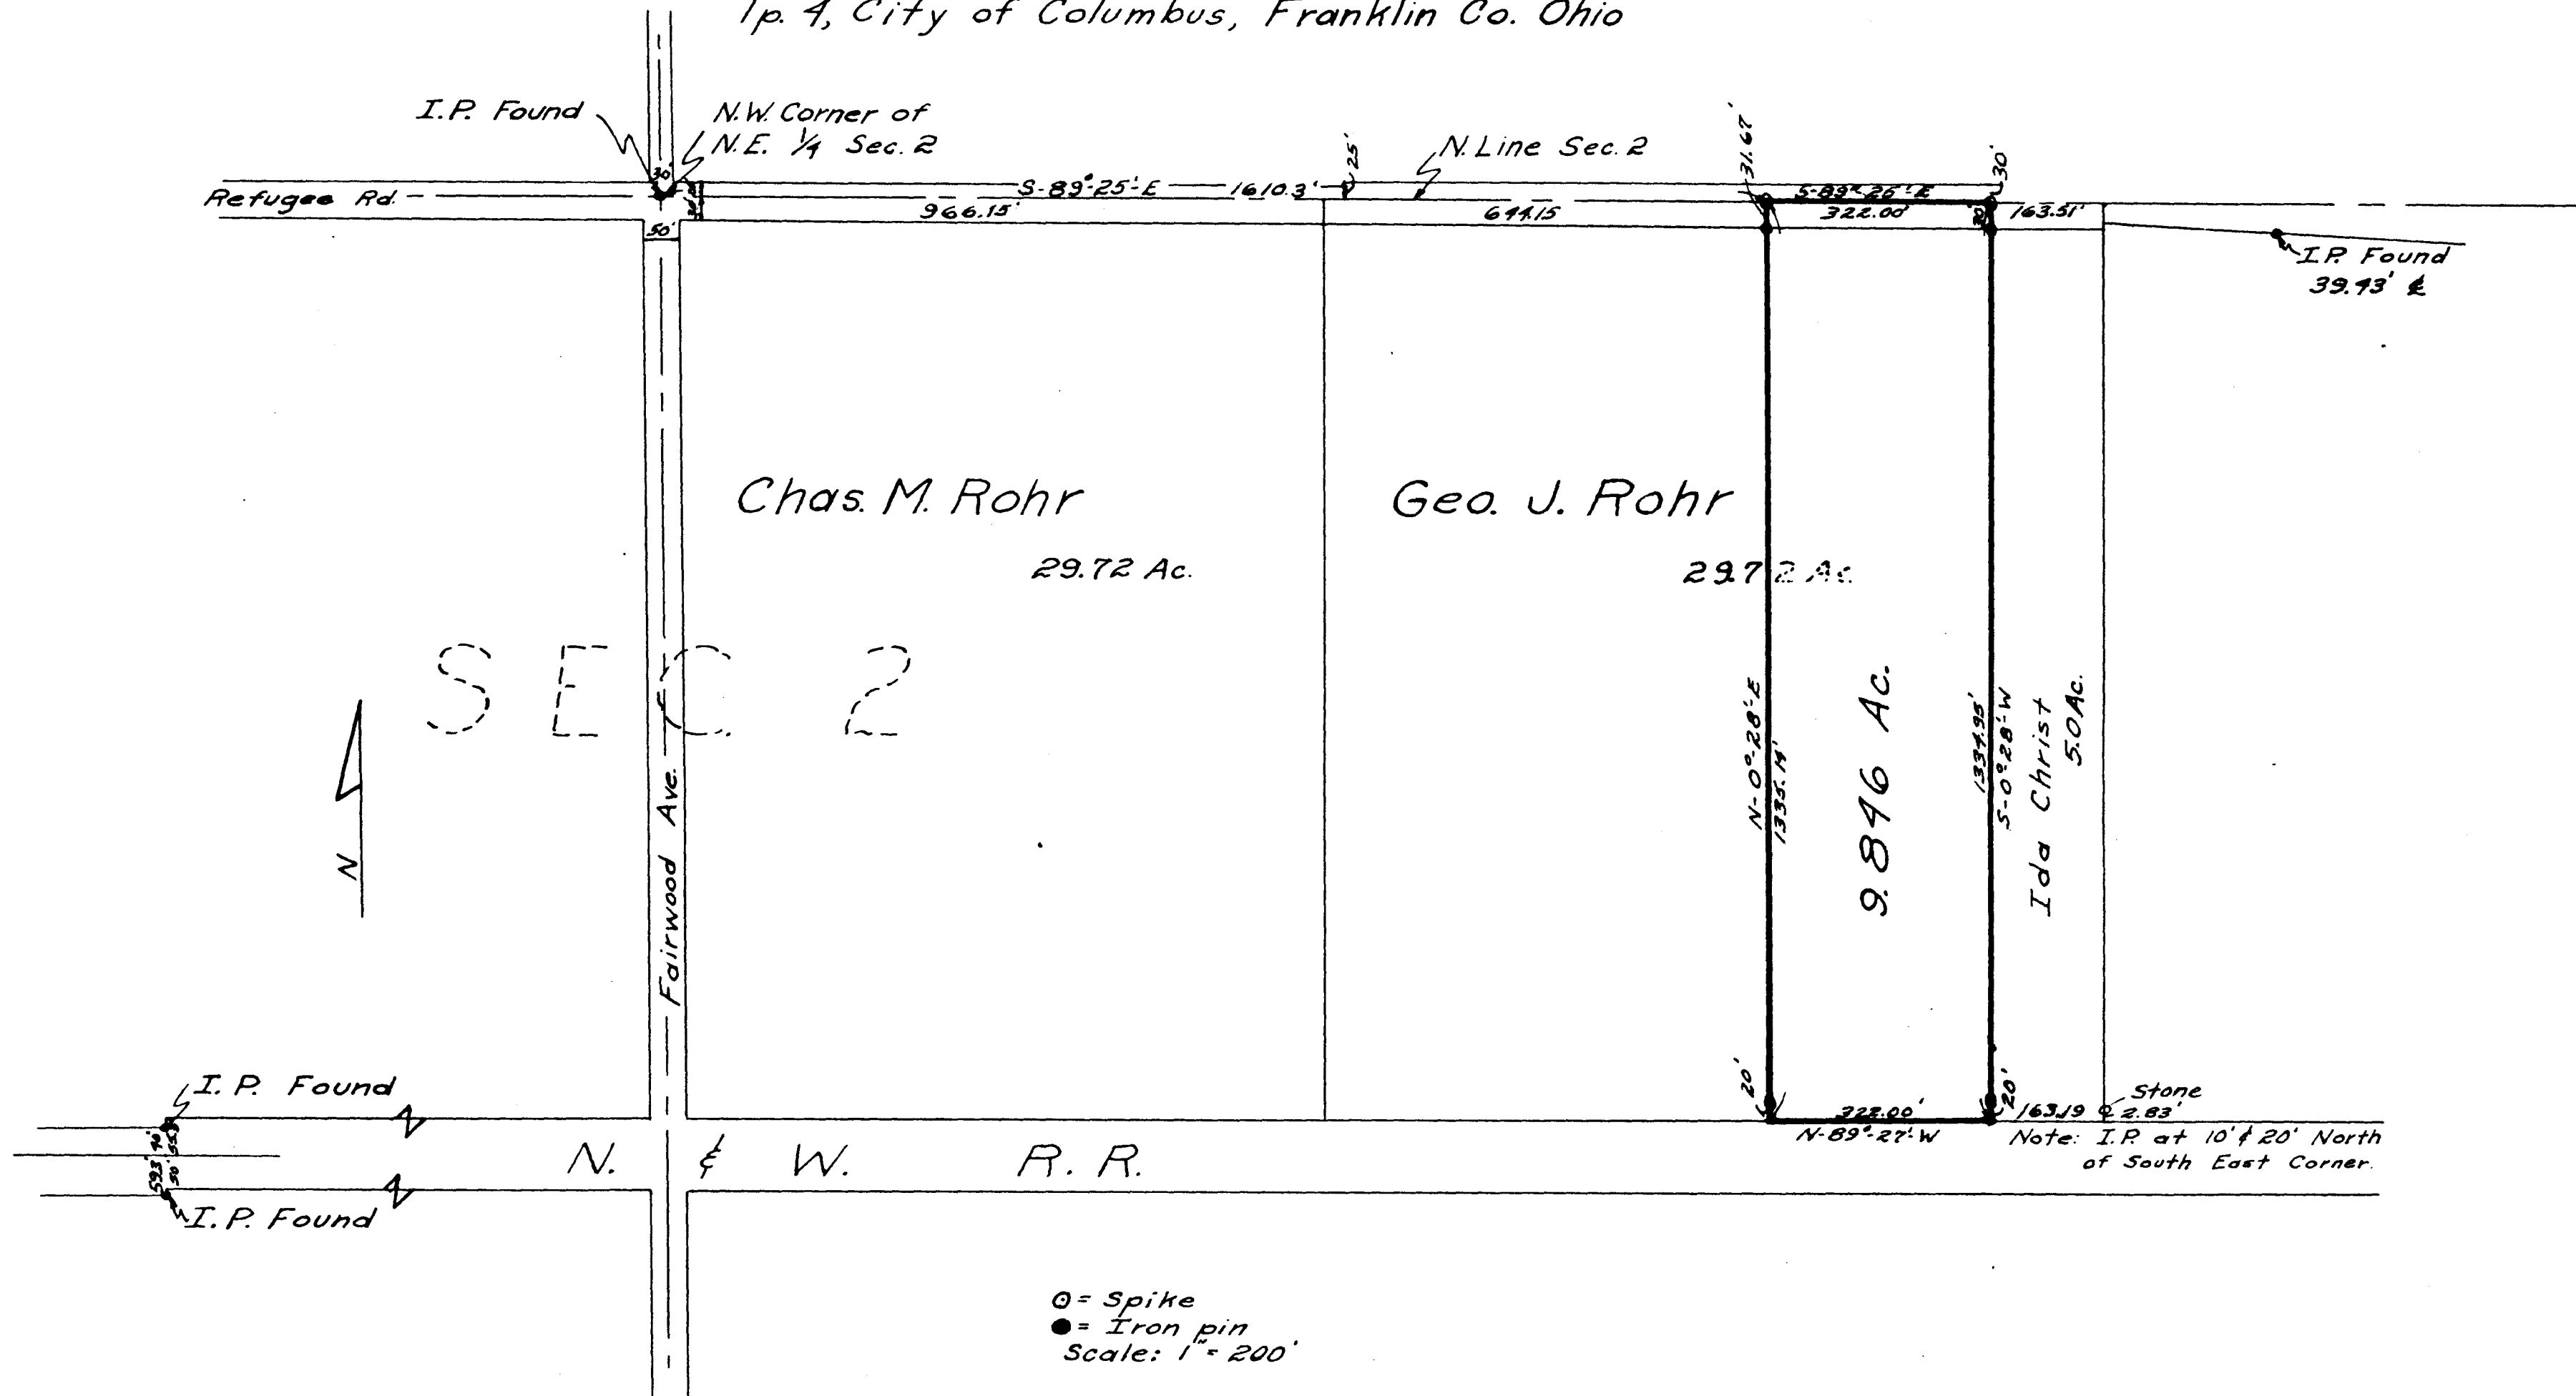

Surveyed By John E. Stattmiller
 John E. Stattmiller
 Reg. Surveyor No. 3090