


0-32-D

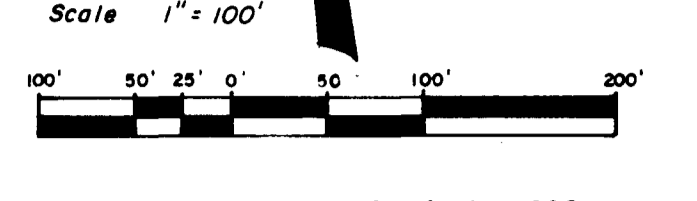

10 April 1990
 Revised 12 June 1991
 (Flood Zone, Easements)
 2) June 1991
 (Temp. ROW Agreement)

Survey of Acreage Parcels, part of the
 75.657 Acre tract conveyed to Carl B. Ziner,
 Trust Agreement, shown of record in O.R.V. 14735 D09,
 Recorder's Office, Franklin County, Ohio, located in
 Virginia Military Survey No. 6839, Jackson Township,
 Franklin County, Ohio, for...


Mr. Carl Ziner

Carl B. Ziner, Trust Agreement
 75.657 Ac.
 O.R.V. 14735 D-09

No.	Page	Acreage	Reference
1	Highland Baptist Church, Grove City, Ohio.	2.848 Ac.	D.B. 2891, Pg. 279
2	Roger L. Stump, et al.	0.54 Ac.	O.R.V. 10587 D-11
3	Village of Grove City, Inc.	1.60 Ac.	D.B. 1045, Pg. 120
4	City of Grove City	2.547 Ac.	D.B. 2267, Pg. 10
5	Jackson Twp. Trustees	1.234 Ac.	D.B. 2567, Pg. 399
6	Jackson Twp. Trustees	2.044 Ac.	D.B. 2567, Pg. 402
7	High Style Homes, Corp.	4.890 Ac.	O.R.V. 12101 F-12
8	High Style Homes, Corp.	6.136 Ac.	O.R.V. 12301 F-10
9	Carriage Court Company	3.311 Ac.	O.R.V. 12374 G-18

Symbol	Description
●	Found Iron Pin
○	Set Iron Pipe
▲	Found Railroad Spike
△	Set Railroad Spike
+	Cross-cut on stone

- NOTES
1. Basis of bearings is the westerly line of "SouthPark" or South 06 degrees 53 minutes 34 seconds East, as same is recorded in Plat Book 71, Page 31, Recorder's Office, Franklin County, Ohio.
 2. Iron pipes set are 30" x 1" O.D. with orange plastic caps inscribed "P.D. 6079", unless otherwise noted.

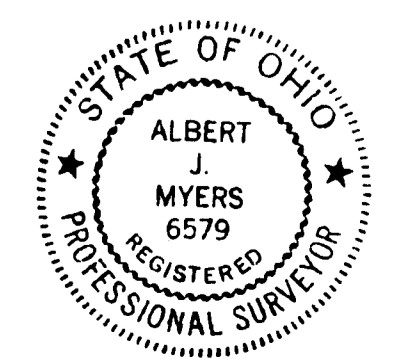

Myers Surveying
 2740 East Main Street
 Bexley, Ohio 43209
 (614) 235-8677

BY Albert J. Myers
 Registered Professional Surveyor #6579

We hereby certify that the foregoing plat was prepared from an actual survey of the premises in April of 1990, and is correct to the best of our knowledge.