




DYER ROAD

BROWN ROAD

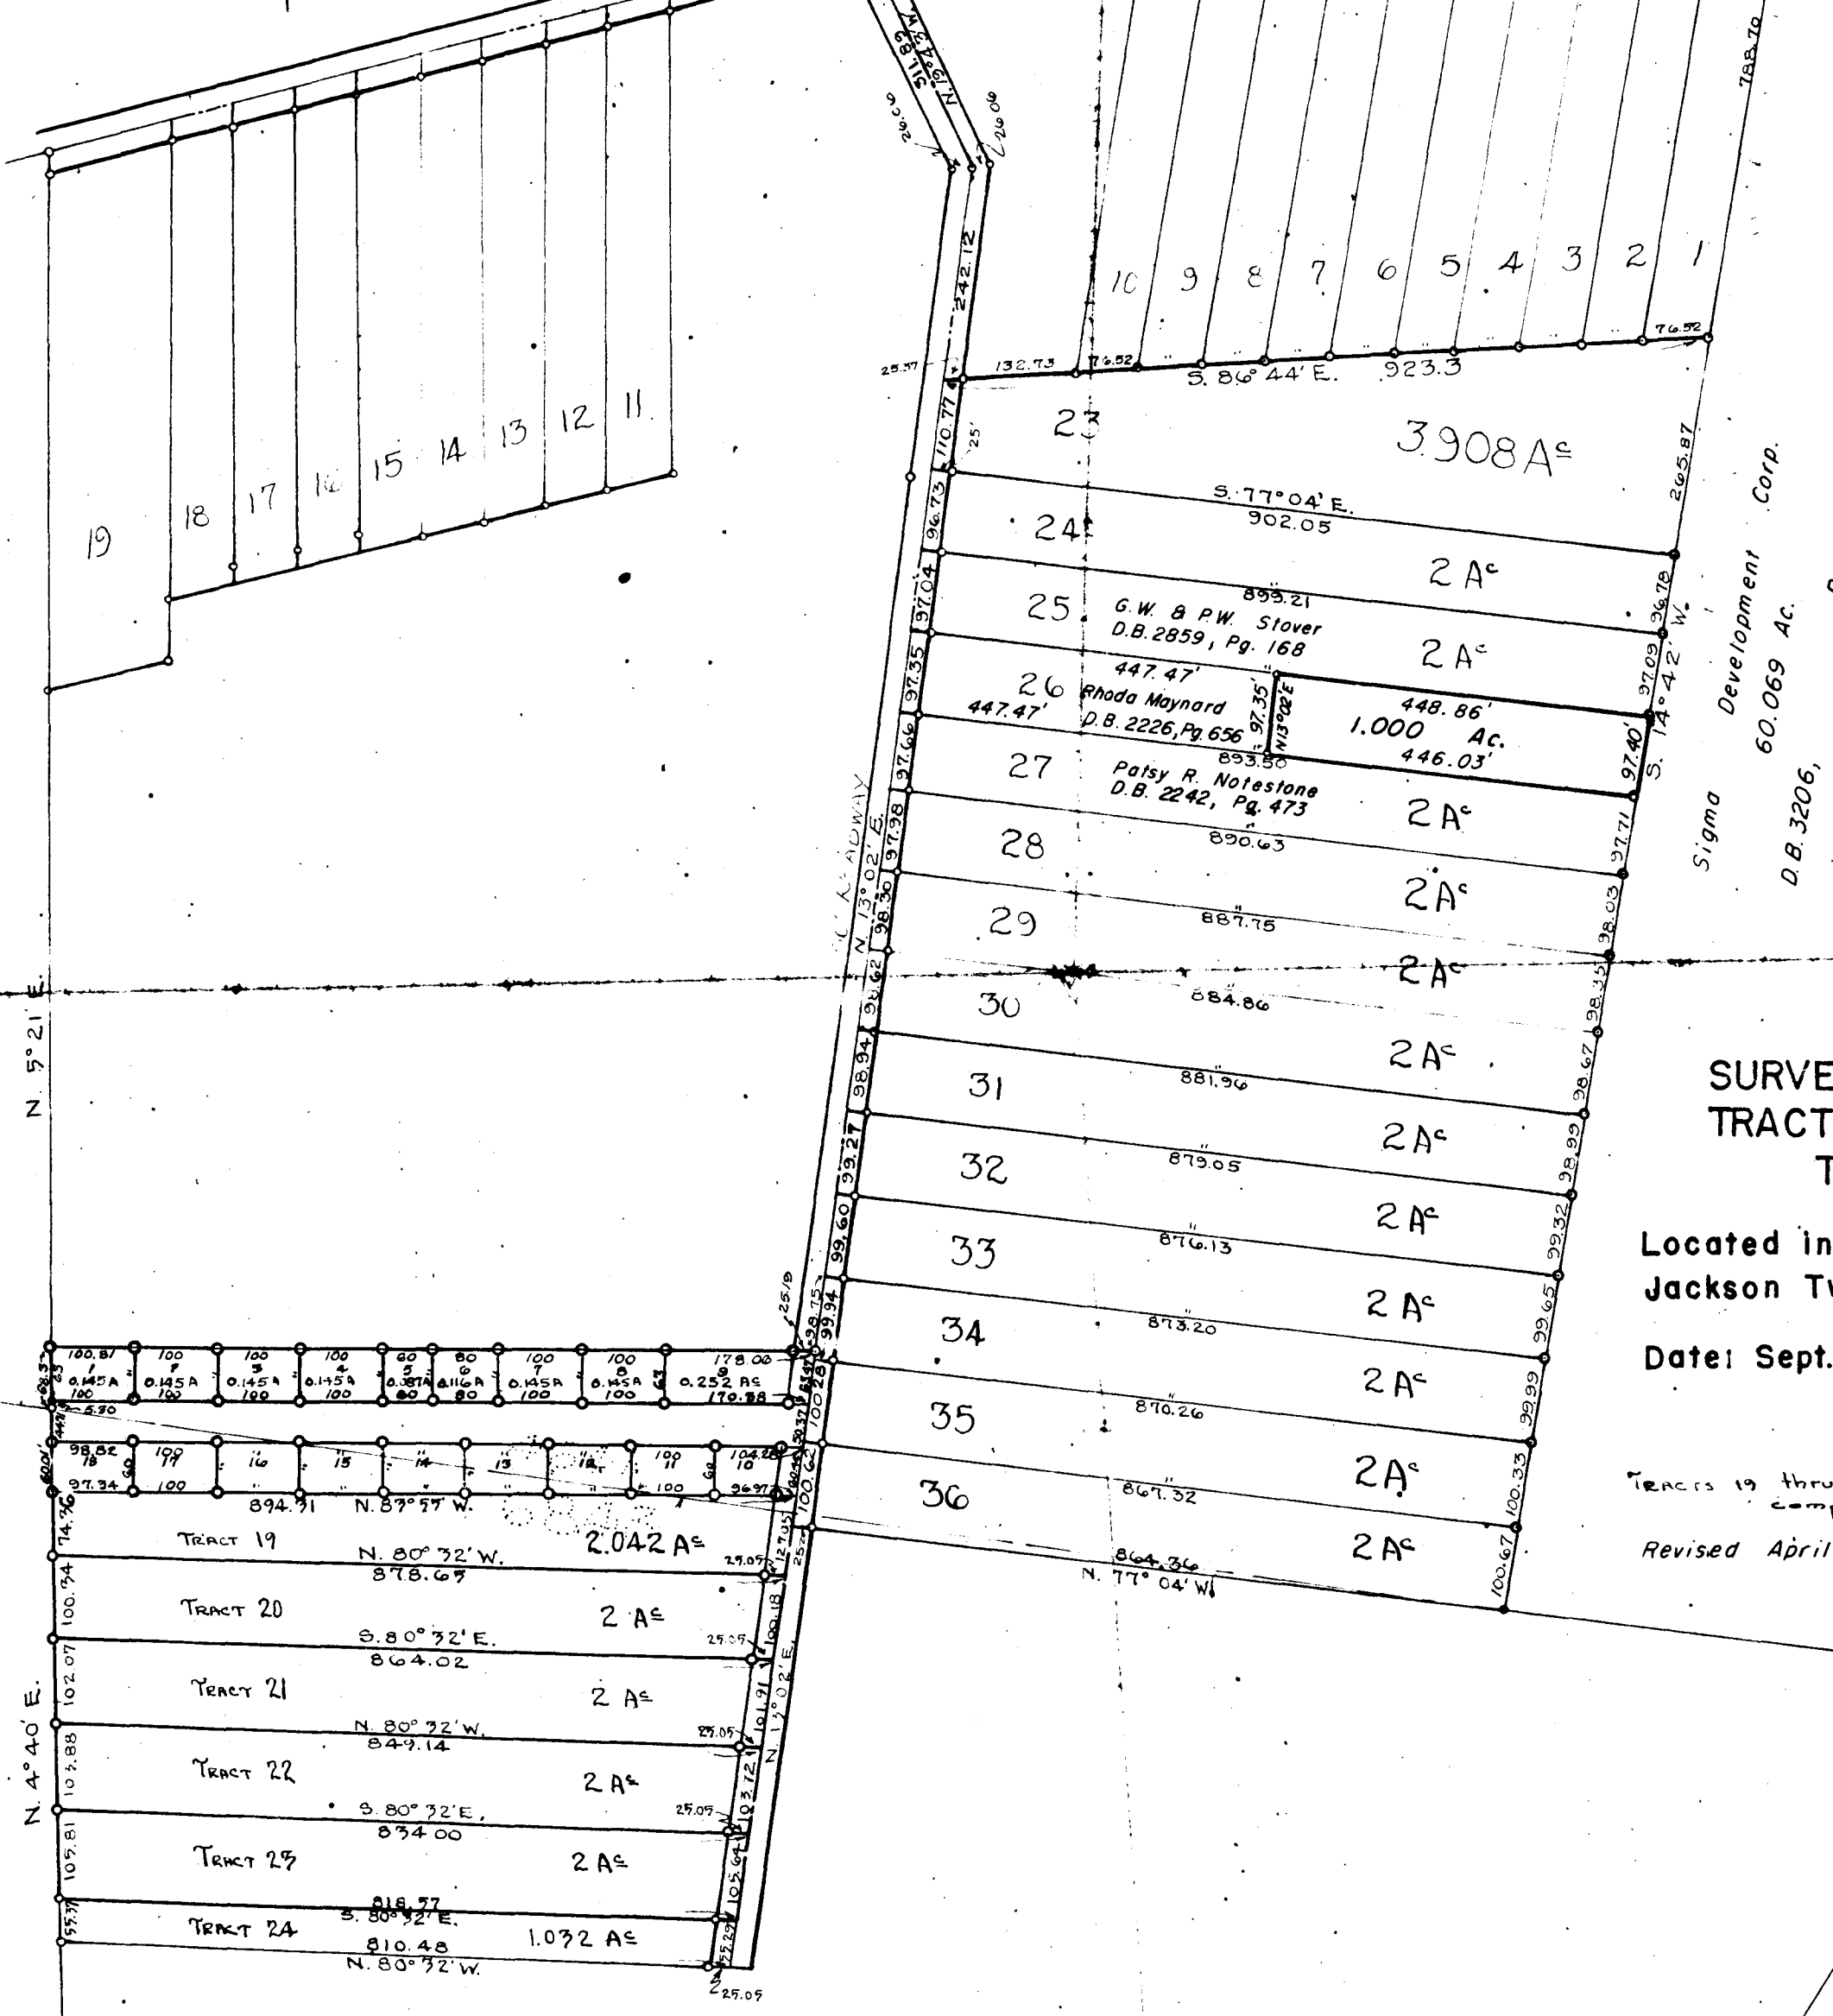

Sigma Development Corp.
60.069 Ac.
D.B. 3206,
Page 643

SURVEY OF ACREAGE TRACTS FOR DIMITAR TRAIKOVICH

Located in V.M.S. 4641 & 6843 Jackson Twp., Franklin Co., Ohio.

Date: Sept., 1952 Scale: 1" = 200'

o = Iron Pin

Tracts 19 thru 23 (2.042 A^c & 4 at 2 A^c) completed April 13, 1952

Revised April 4, 1972

Reg. Surveyor # 483.

1350 120 076 027 1972 0322 03