



DYER ROAD


BROWN ROAD

REMAIN HIGHWAY 5-13-57

288.70
265.87
26.83
1151.35

11-6-63

6.284

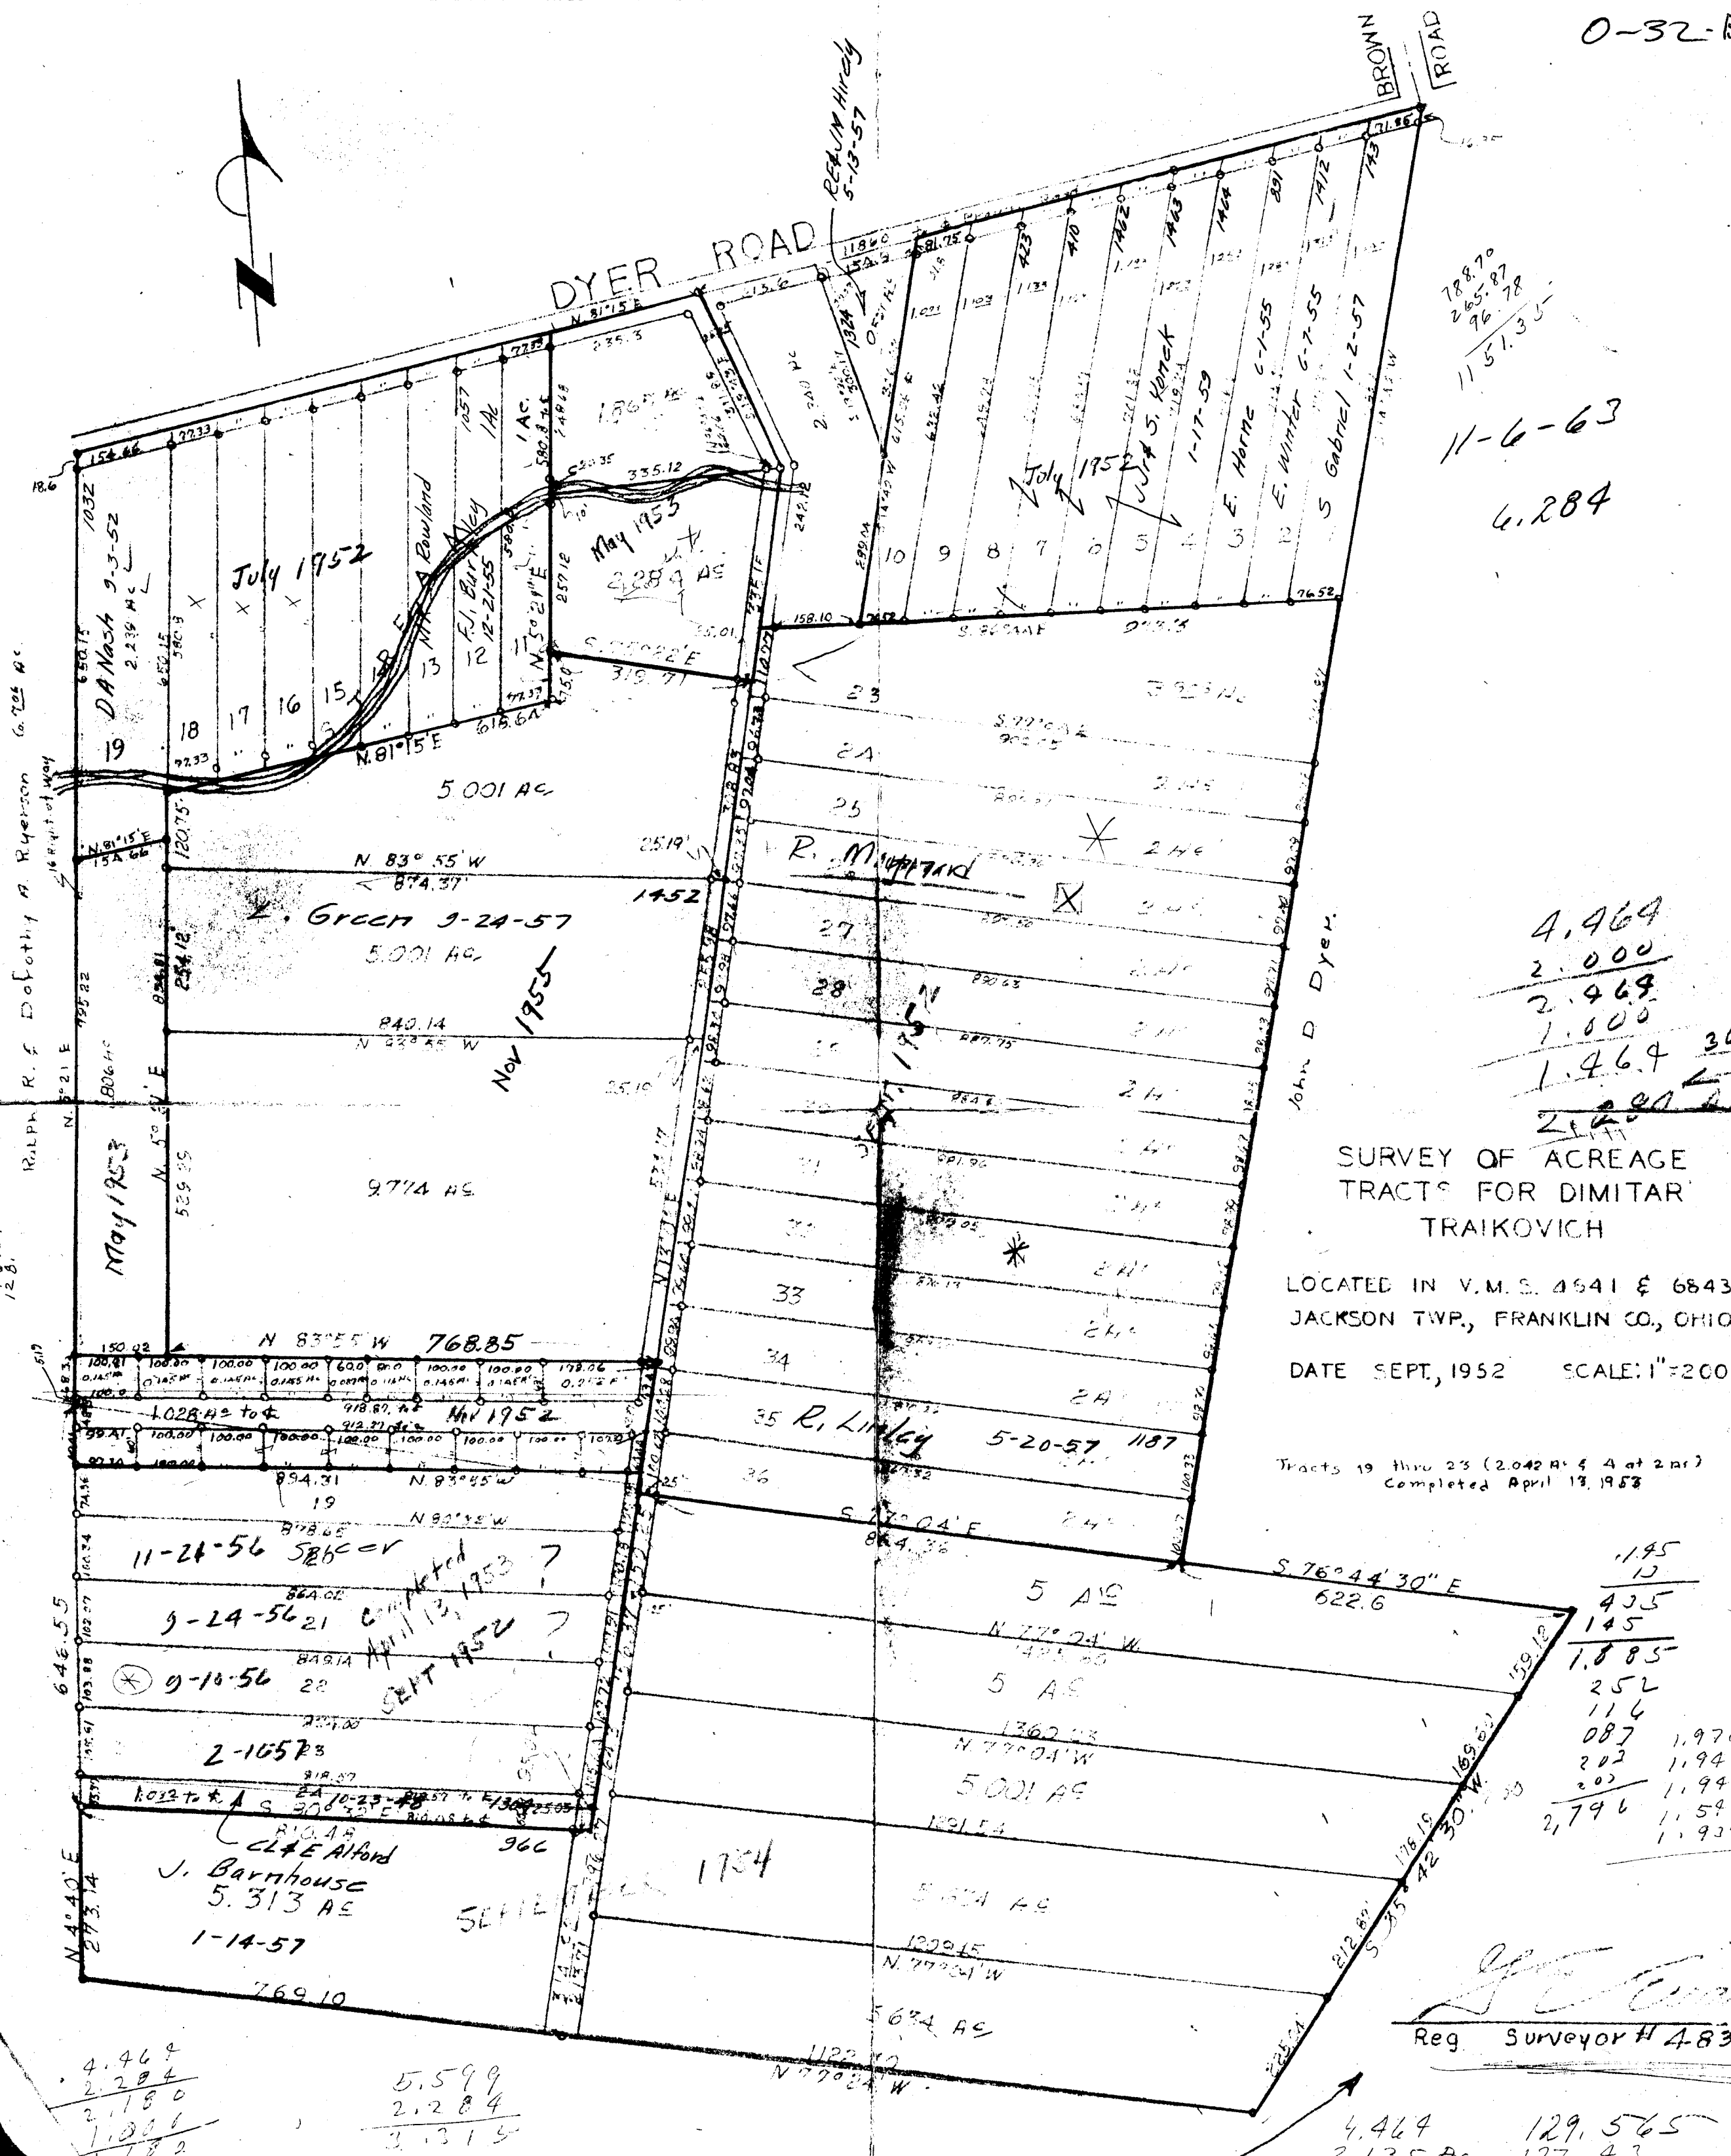

4.464
2.000
2.464
1.000
1.464 361
2.000

SURVEY OF ACREAGE TRACTS FOR DIMITAR TRAIKOVICH

LOCATED IN V.M.S. 4641 & 6843 JACKSON TWP., FRANKLIN CO., OHIO

DATE SEPT, 1952 SCALE: 1"=200'

Tracts 19 thru 23 (2.042 AC & 4 at 2 AC) Completed April 13, 1953

1.95
13
435
145
1.885
252
116
087 1.970
202 1.943
202 1.942
2,796 11,546
11,939

J. E. Baird
Reg. Surveyor # 483

4.464 129.565
2,135 AC 127.43
6.599 2,135

68.3
40.01
48.3
12.851
17.651
12.851
5
50
50
48.3
25.00
19.71
5.19

1350 120 0870 012 S DYER RD & LAZAR RD 1952 0322 0357