


SUBDIVISION OF
JACOB SHOAF PROPERTY
JACKSON TWP. FRANKLIN CO., OHIO

SCALE 1" = 20'
 DEC. 2, 19...

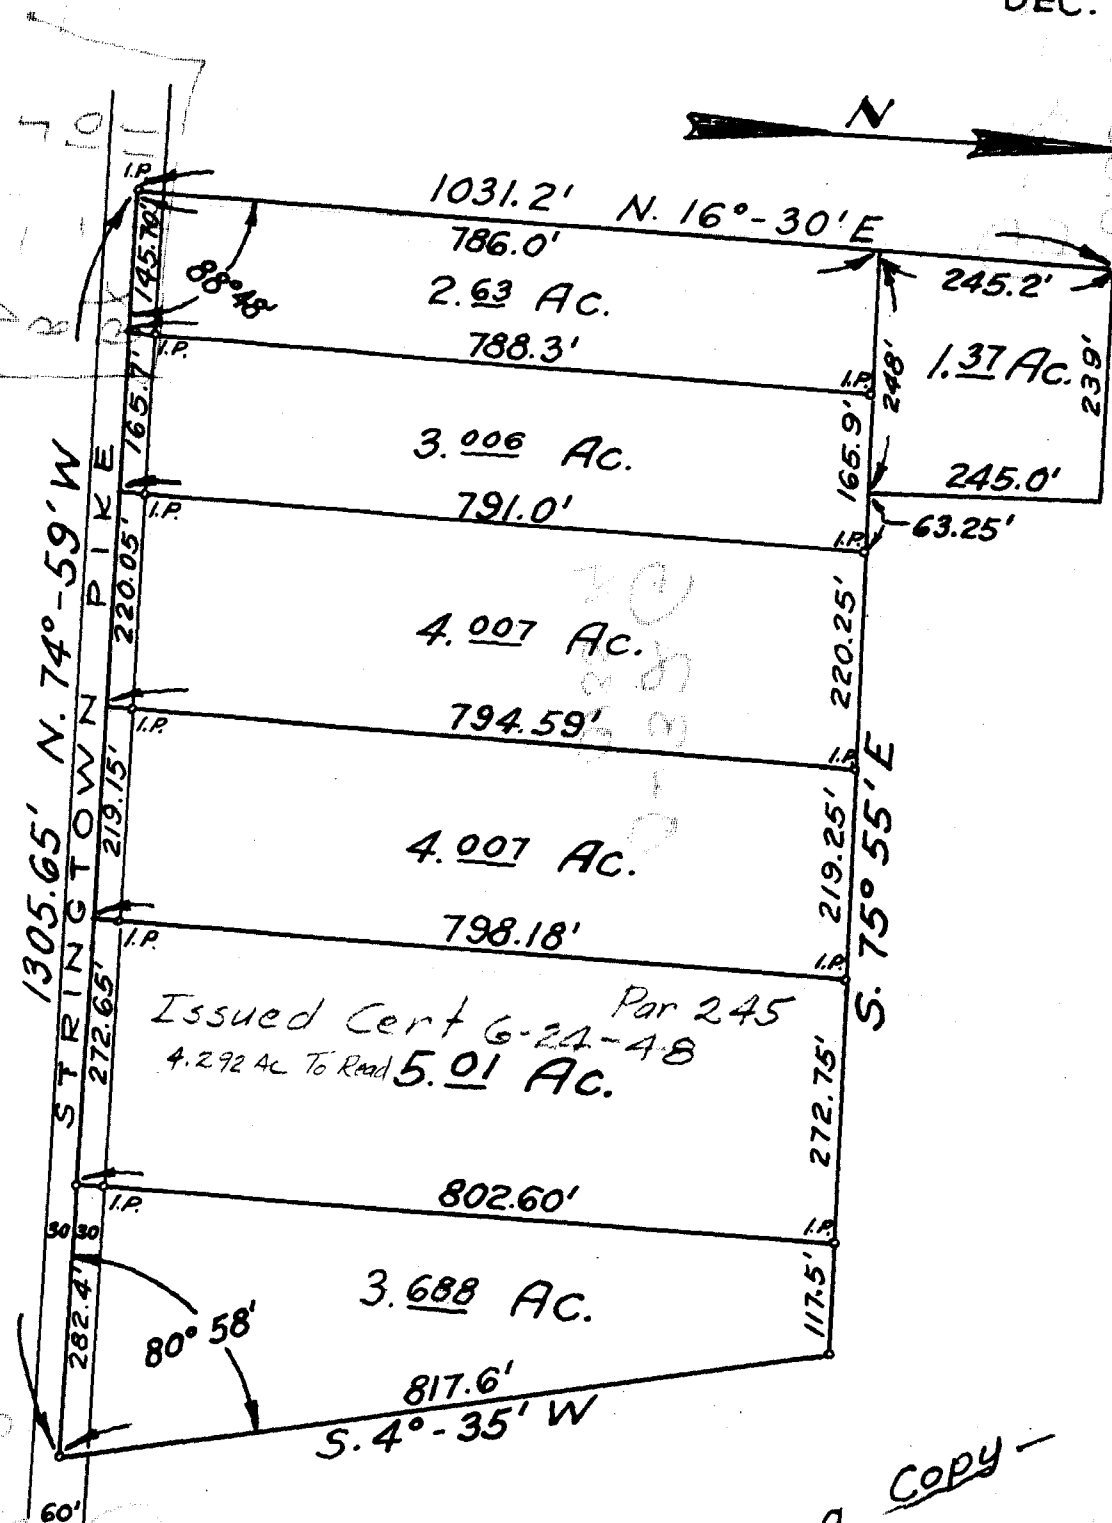

81606850
 81606825
 81606825

This is a Copy -

We hereby certify that the foregoing drawing was prepared from an actual survey of the premises and correctly shows the location of the boundaries, improvements and joint...

THE JENNINGS-LAWRENCE CO.
 By *C. A. Lawrence*
 REGISTERED SURVEYOR

013210
 0-35-0
 4360 1120 007 057 N STRINGTOWN PIKE