


MAHAN C J CONSTRUCTION
T.D. 9/30/81
D.R. 1242 G.17

(A) 204.94' LT ☒ STA. 45+63.00
(B) 60.00' LT ☒ STA. 44+17.00
(C) 100.00' LT ☒ STA. 41+38.90
(D) 44.66' LT ☒ STA. 35+90.00

S.R. 104 PLANS
STA. 35+00 TO STA. 50+00
FRANKLIN COUNTY
200-8.04 326
333
DATE: 4-26-62

NOTE:
THRAILKILL RD.
50' WIDE
REDIDECATED 12/4/63

CROWN ENTERPRISES INC.
T.D. 3/28/72
VOL. 3223 PG. 41

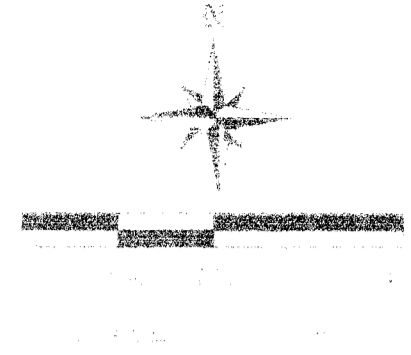

MARGRET LUCE
T.D. 9/28/63
DB. 2511 PG. 505

19.913 ACRES

JUDITH A. POENISCH
T.D. 4/14/82
VOL. 1669 F18

75.023 ACRES
TOTAL

55.110 ACRES

MANHEM SERVICES CORP.
T.D. 4/9/96
INST# 199604090096698
31643 1-16

4.699 ACRES

111.11' 1.039 ACRES
ROBERT E. TROUT
T.D. 3/16/78
DB. 3641 PG. 9

TRIDENT INVEST. CO., INC.
T.D. 9/28/63
INST# 199807070169927

REFERENCE POINT
R/R SPIKE FOUND

BASELINE FOR BEARING
STATE ROAD #104

R/R SPIKE FOUND

- ☐ CONC. R/W MARKER
 - △ R/R SPIKE FOUND
 - ▲ R/R SPIKE SET
 - 1" IRON PIN FOUND
 - 5/8" REBAR & YELLOW PLASTIC CAP STAMPED "XYZ 7408" (SET)
 - P K NAIL
- ALL MONUMENTS FOUND OR SET ARE IN GOOD CONDITION UNLESS OTHERWISE NOTED.

LAND SURVEY

MADE FOR:

**JUDITH POENISCH
& EILEEN O. BARBEE**

SHOWING A LARGE TRACT OF LAND LYING IN
JACKSON TOWNSHIP, FRANKLIN COUNTY, OHIO.
AND BEING PART OF VIRGINIA MILITARY SURVEY
469 LYING WEST OF OHIO STATE ROUTE 104
AND SOUTH OF THRAILKILL ROAD.

SURVEY MADE DURING MAR. 2001

by David E. Slagle 4-24-01
David E. Slagle P.S. #7408 Date



MADE FOR: JUDITH POENISCH	
DATE: 7/6/2000	JOB# 21-041
SCALE: 1" = 200'	F.B# 109
REVISED: 3/22/2001	MAP# 20-099
DRAWN BY: M.P.G.	
CHECKED BY: D.E.S.	
CAD FILE: 20-099	

XYZ
SURVEY SERVICE INC.
3958 La ROSA CT
GROVE CITY OH 43123
FAX: 614-875-7862 PH: 614-871-4980