

TA: 204.94 L.S. STA 45+63.00
 B: 50.00 "77.44+17.11"
 C: 100.00 "77.44+35.56"
 D: 44.66 "77.44+90.00"

C.S. 104 PLAN
 STA. 25+00 TO STA. 50+00
 FRANKLIN COUNTY
 2011-5.04 222
 333
 DATE 4-26-62

NOTE
 THRILLKILL RD
 50' WIDE
 REDDEDICATED 12/4/63

CROWN ENTERPRISES INC.
 T.B. 3/28/72
 VOL. 3223 PG 41

19.91 ACRES
 19.91 ACRES
 19.91 ACRES

TOTAL REMAINING PROPERTY
 60.248 ACRES

55.110 ACRES

MANHON SEP VICE CORP
 T.D. 4/9/76
 INST# 19961405096698
 31842-1-11

4.695 ACRES

TRIDENT INVEST. CO. INC.
 T.D. 9/28/63
 INST# 19960707016992

5.138 ACRES TRACT #1

EILEEN BARBEE
 VOL. 312 P. 202

EILEEN BARBEE
 VOL. 323 P. 38

JUDITH POENISCH
 VOL. 376 P. 57

EILEEN O. BARBEE
 VOL. 312 P. 202

CANTON LAND CORPORATION
 VOL. 2821 P. 25

EILEEN BARBEE & JUDITH POENISCH
 VOL. 1665 P. 116

26.215 ACRES TRACT #2

RICH JONES
 VOL. 3000 P. 673


- CONC. R/W MARKER
 - △ R/W SPIKE FOUND
 - ▲ R/W SPIKE SET
 - 1" IRON PIN FOUND
 - 5/8" RED BAR & YELLOW PLASTIC CAP STAMPED "XYZ 7406" (SET)
 - P.K. NAIL
- ALL MONUMENTS FOUND OF SET ARE IN GOOD CONDITION UNLESS OTHERWISE NOTED.

LAND SURVEY

MADE FOR:
**JUDITH A. POENISCH, EILEEN O. BARBEE,
 ROBERT E. TROUT & RALPH H. BARBEE**

SHOWING 4, LARGE TRACT OF LAND LYING IN
 JACKSON TOWNSHIP, FRANKLIN COUNTY, OHIO,
 AND BEING PART OF VIRGINIA MILITARY SURVEY
 # 485 LYING WEST OF OHIO STATE ROUTE 104
 AND SOUTH OF THRILLKILL ROAD.

SURVEY MADE DURING MAR. 2001

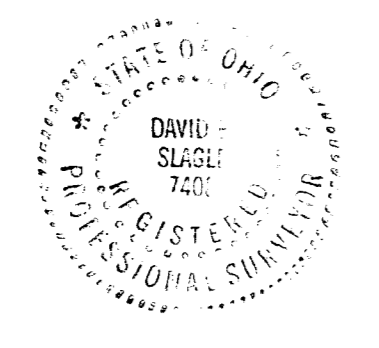

BY David E. Sieple Date 02/28/12
 David E. Sieple P.S. #7406 Date

MADE FOR:	ROBERT E. TROUT
DATE:	2/8/2001
SCALE:	1" = 200'
REVISED:	MAP# 22-023
DRAWN BY:	M.P.G.
CHECKED BY:	D.E.S.
DATE:	02/28/12
FILE:	22-023