10.607 Acres and 1.000 Acre, part of the 15.291 Acre, 0.452 Acre and 0.875 Acre tracts conveyed to The Estate of Max Hoffman, Deceased, Robert M. Hoffman, Executor, in Official Record Volume 34942, Page J-13, in Section 10, Township 4, Range 22, Mathews' Survey of Congress Lands, in the City of Columbus, County of Franklin, State of Ohio…

For

The Revocable Trust of Max Hoffman, June 1990
And Or
Haithan Masri

And Or
Mohammad I. Saqfelhait

Scale 1" = 60'
October 25, 2000

REVISIONS:			
No.	Date	Description	By

NOTES
1. The improvements on the 1.000 Acre parcel have not been located.
2. The fences along the east line of the 10.607 Acre & 1.000 Acre parcels and along the south line of the 10.607 Acre parcel have not been located.

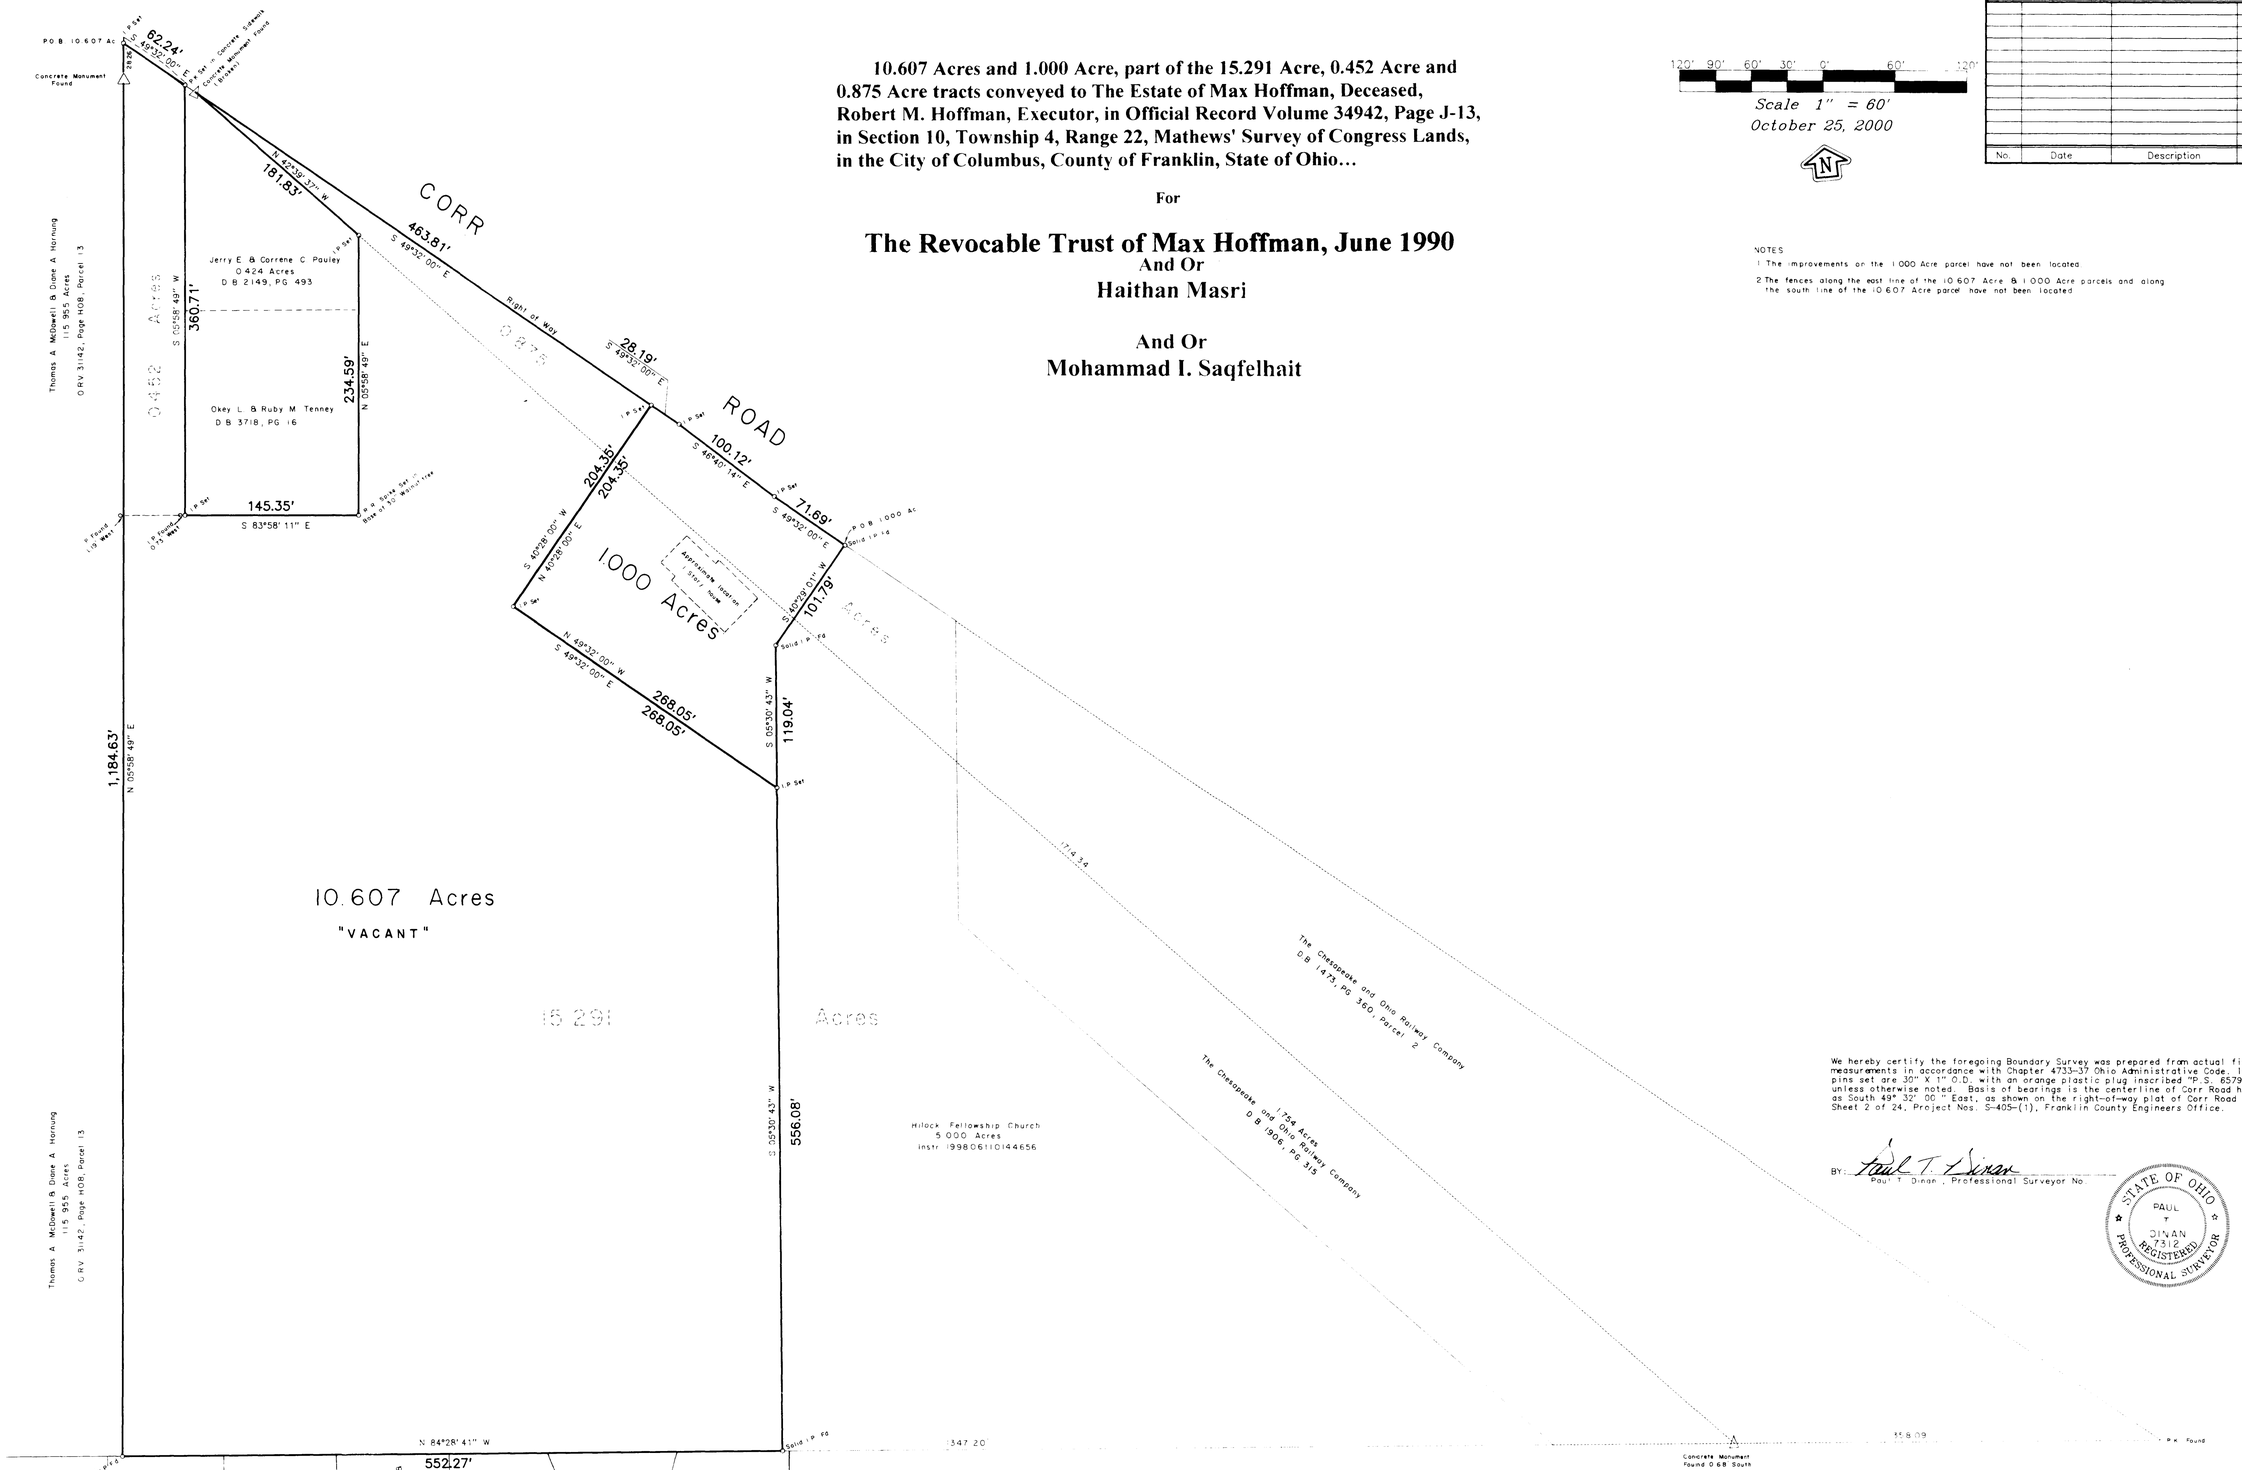

We hereby certify the foregoing Boundary Survey was prepared from actual field measurements in accordance with Chapter 4733-37 Ohio Administrative Code. Iron pins set are 30" X 1" O.D. with an orange plastic plug inscribed "P.S. 6579", unless otherwise noted. Basis of bearings is the centerline of Corr Road held as South 49° 32' 00" East, as shown on the right-of-way plat of Corr Road Sheet 2 of 24, Project Nos. S-405-(1), Franklin County Engineers Office.

BY: Paul T. Dinan
Paul T. Dinan, Professional Surveyor No.

STATE OF OHIO
PAUL T. DINAN
7312
REGISTERED
PROFESSIONAL SURVEYOR

MyersSurveying
2740 East Main Street
Bexley, Ohio 43209-2577
(614) - 235 - 8677

34-08-09-00 34080900.570 X- T -

Split (010) 880102 + (010) 114975
8335692.5