
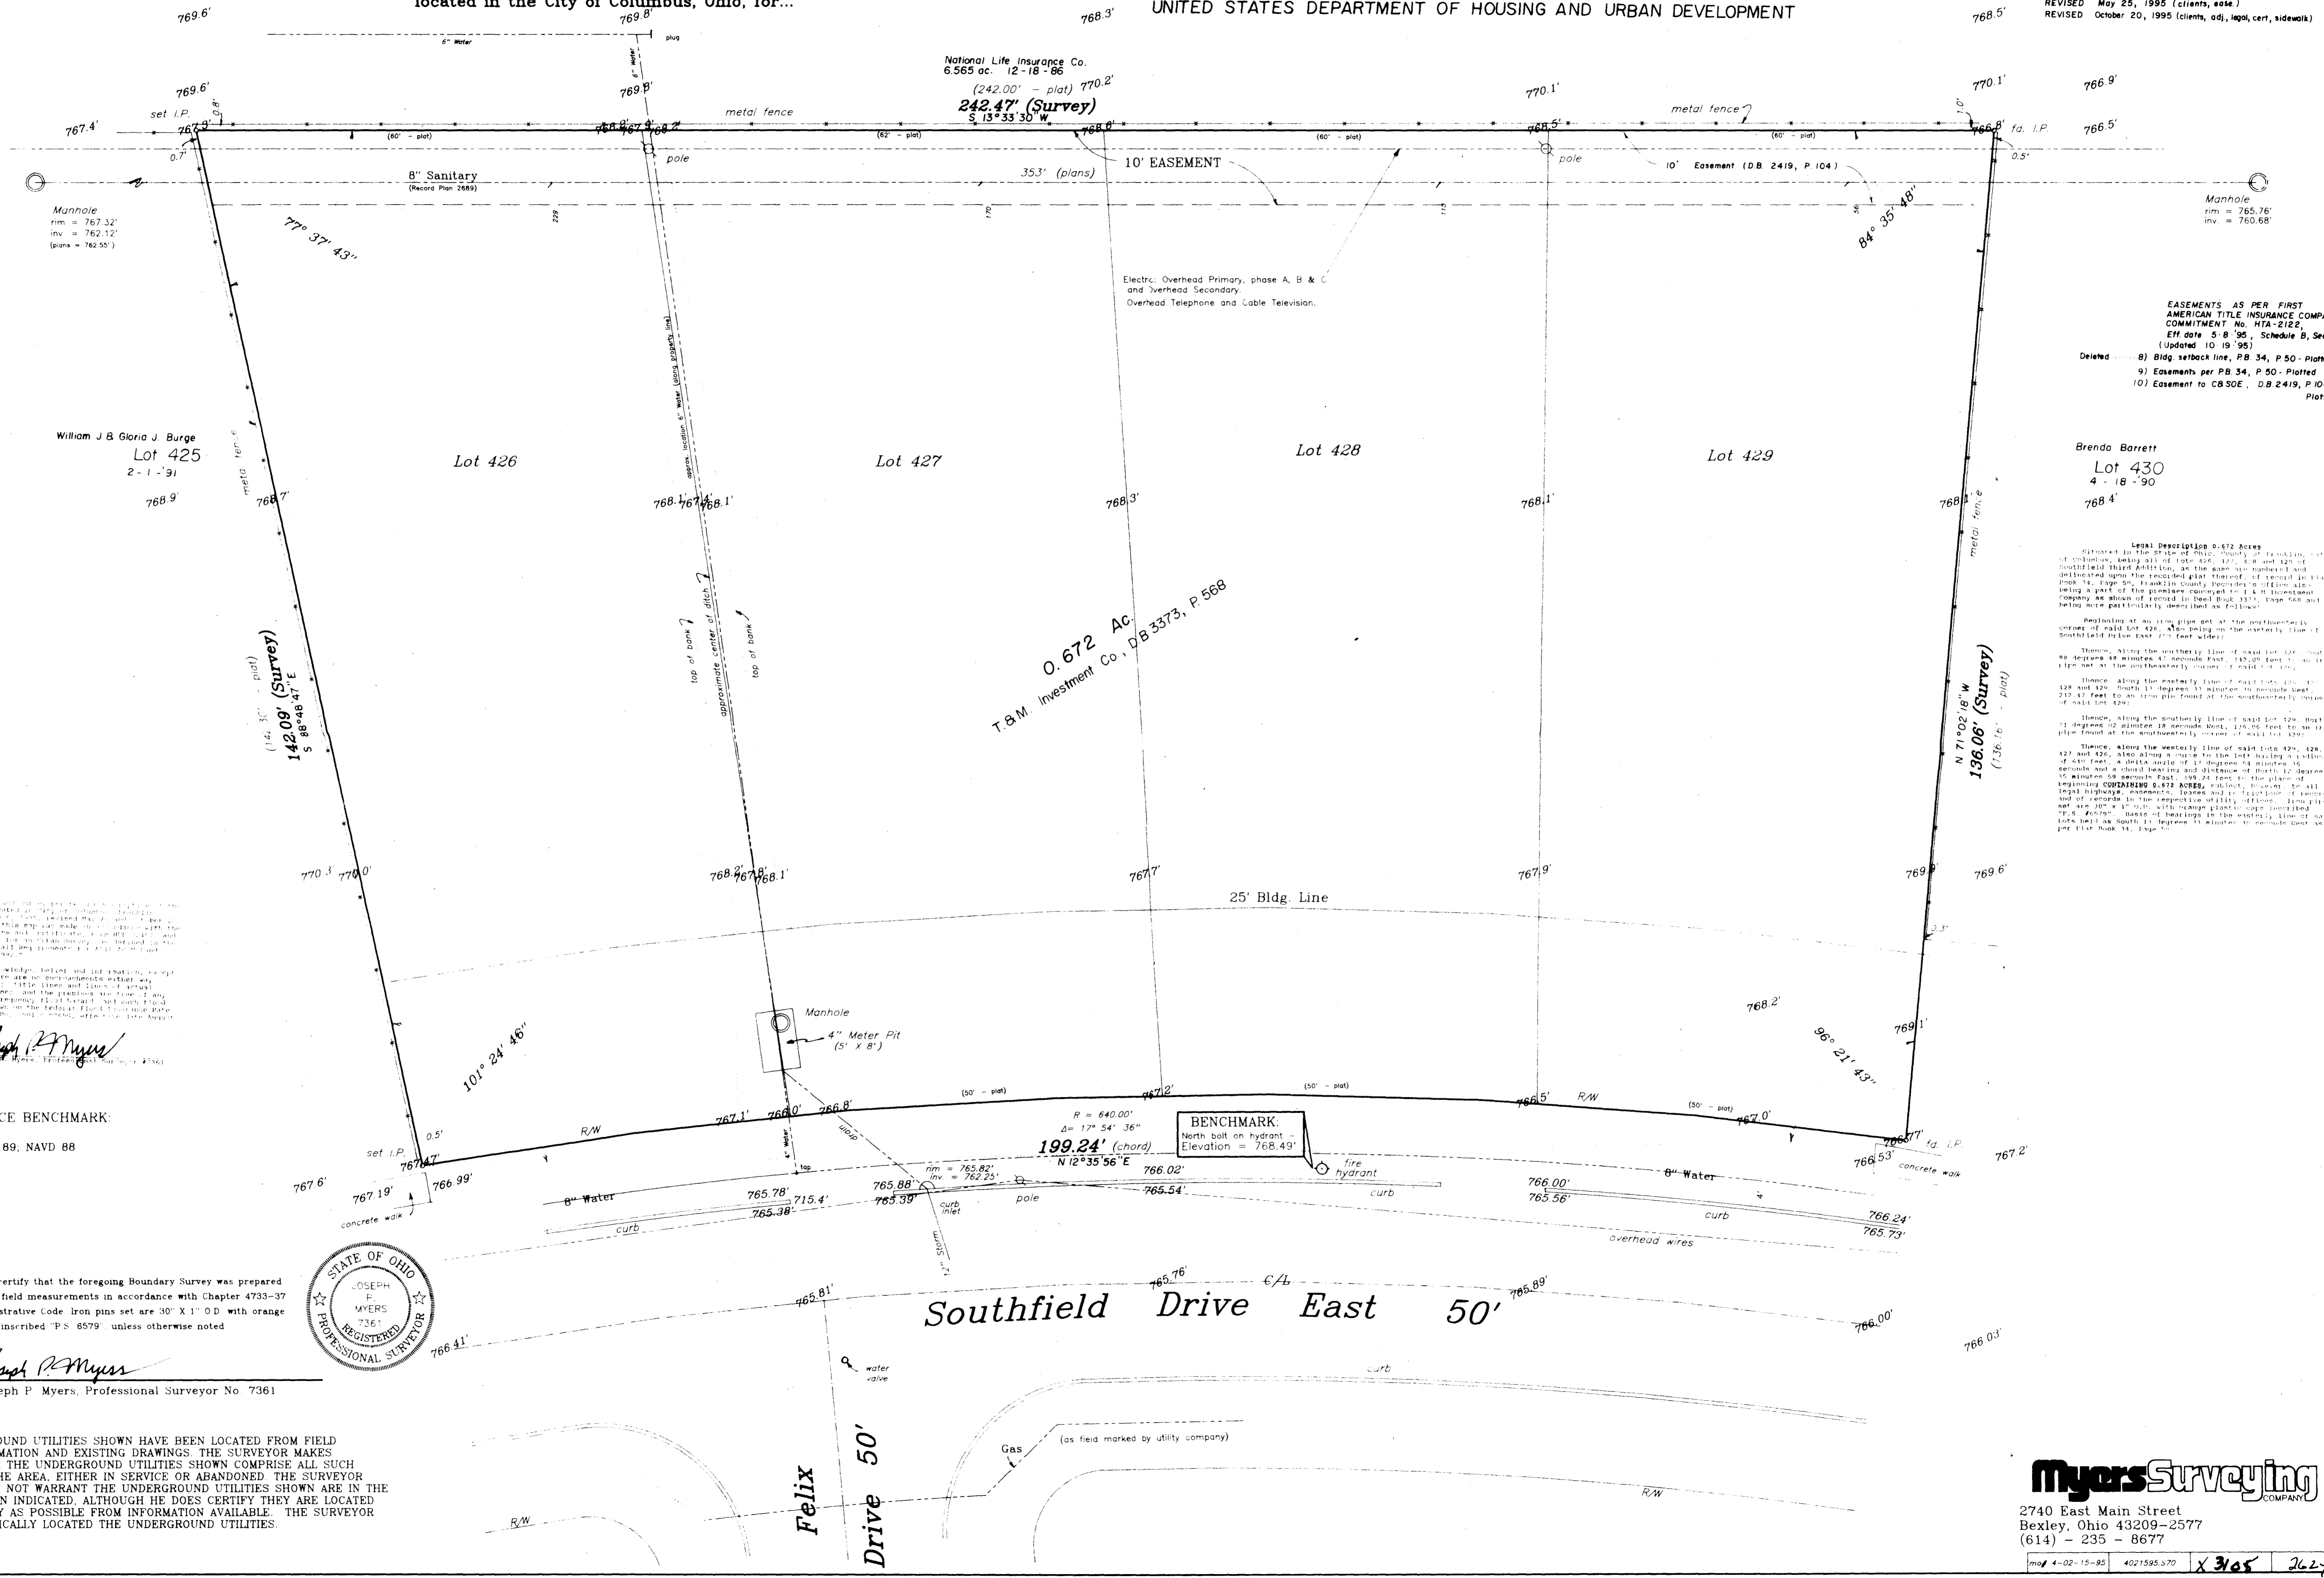


Boundary and Topographic Survey of Lots 426, 427, 428 and 429 of Southfield Third Addition, as same are numbered and delineated upon the recorded plat thereof, of record in Plat Book 34, Page 50, Recorder's Office, Franklin County, Ohio, located in the City of Columbus, Ohio, for...

FIRST AMERICAN TITLE INSURANCE COMPANY
HILL MANOR I, INC.
HUMMEL TITLE AGENCY, INC.
UNITED STATES DEPARTMENT OF HOUSING AND URBAN DEVELOPMENT

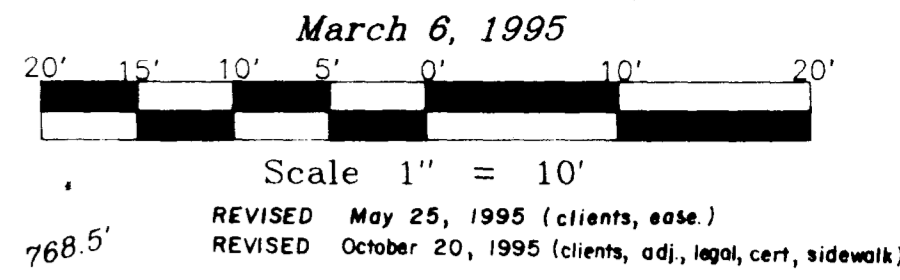

"I, the undersigned, a duly qualified and licensed Professional Surveyor of the State of Ohio, do hereby certify that the foregoing Boundary Survey was prepared from actual field measurements in accordance with Chapter 4733-37, Ohio Administrative Code. Iron pins set are 30" X 1" O.D. with orange plastic caps inscribed 'P.S. 8579', unless otherwise noted.



REFERENCE BENCHMARK:
FCE - T 189, NAVD 88

BY Joseph P. Myers
Joseph P. Myers, Professional Surveyor No. 7361



THE UNDERGROUND UTILITIES SHOWN HAVE BEEN LOCATED FROM FIELD SURVEY INFORMATION AND EXISTING DRAWINGS. THE SURVEYOR MAKES NO GUARANTEE THE UNDERGROUND UTILITIES SHOWN COMPRISE ALL SUCH UTILITIES IN THE AREA, EITHER IN SERVICE OR ABANDONED. THE SURVEYOR FURTHER DOES NOT WARRANT THE UNDERGROUND UTILITIES SHOWN ARE IN THE EXACT LOCATION INDICATED, ALTHOUGH HE DOES CERTIFY THEY ARE LOCATED AS ACCURATELY AS POSSIBLE FROM INFORMATION AVAILABLE. THE SURVEYOR HAS NOT PHYSICALLY LOCATED THE UNDERGROUND UTILITIES.

EASEMENTS AS PER FIRST AMERICAN TITLE INSURANCE COMPANY COMMITMENT No. WA-2122, Eff. date 5-8-95, Schedule B, Section 11 (Updated 10-19-95)

- 8) Bldg setback line, PB 34, P. 50 - Plotted
- 9) Easements per PB 34, P. 50 - Plotted
- 10) Easement to CBSOE, D.B. 2419, P. 104 - Plotted

Legal Description 0.672 Acres


Myers Surveying
2740 East Main Street
Bexley, Ohio 43209-2577
(614) - 235 - 8677
map 4-02-15-95 4021595.570 x 3105 2624