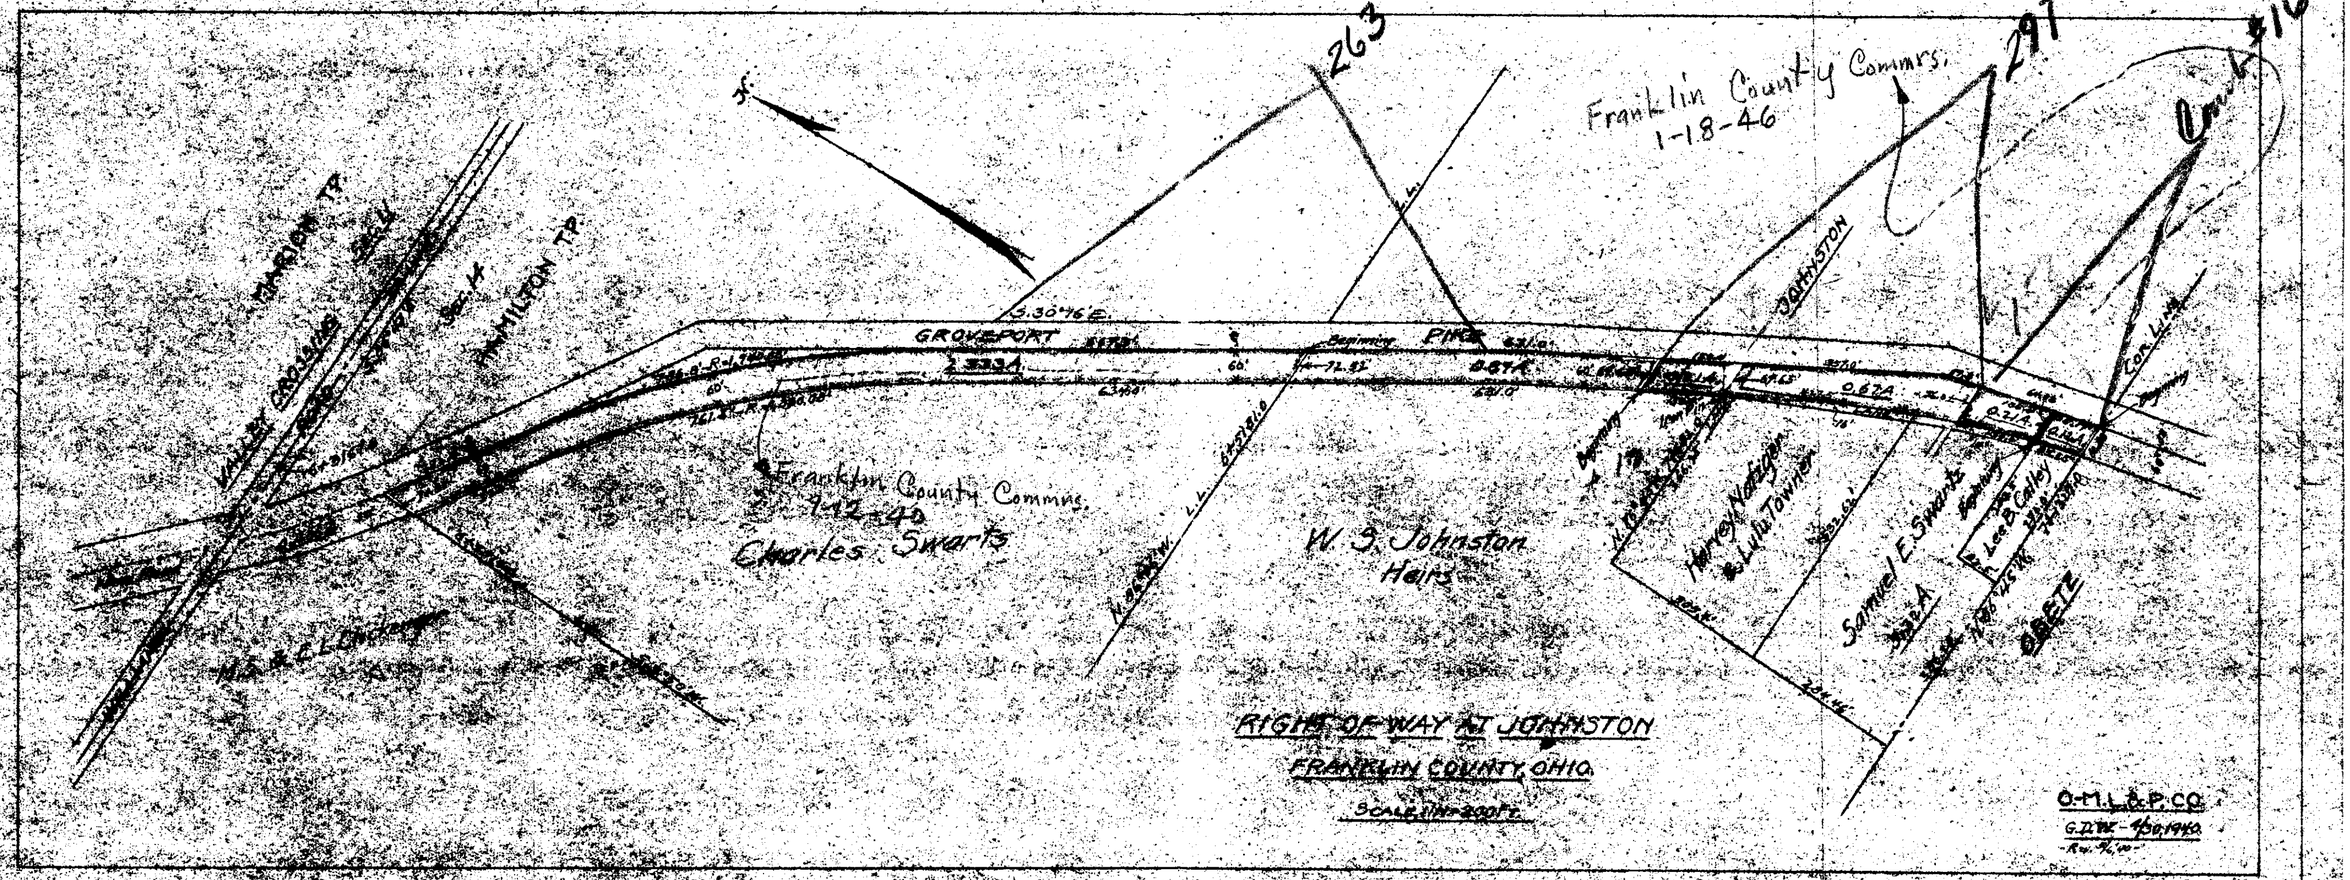
263
297
#16
Franklin County Commrs.
1-18-46
JOHNSTON TP.
HAMILTON TP.
VALLEY CROSSING
S.30°46'E.
GROVEPORT
PIKE
Beginning
0.67A
0.62A
Franklin County Commrs.
9-12-40
Charles Swartz
W. S. Johnston
Heirs
Harvey Nardigan
& Lulu Towner
Samuel E. Swartz
Lee B. Calley
OBETZ
RIGHT OF WAY AT JOHNSTON
FRANKLIN COUNTY, OHIO.
SCALE 1"=200 ft.
O-M.L.&P.CO.
G.D.W. - 4/30/1940