

ANGELA DRIVE


HAUGHN ROAD

Mamie E. Kropp


Donna Kropp

Haughn Road I.S.A. Foodliner Inc.  
Orig. 0.810 Ac.  
D.B. 2372, Pg. 569

Margaret A. Putt  
Orig. 0.336 Ac.  
D.B. 2157, Pg. 349

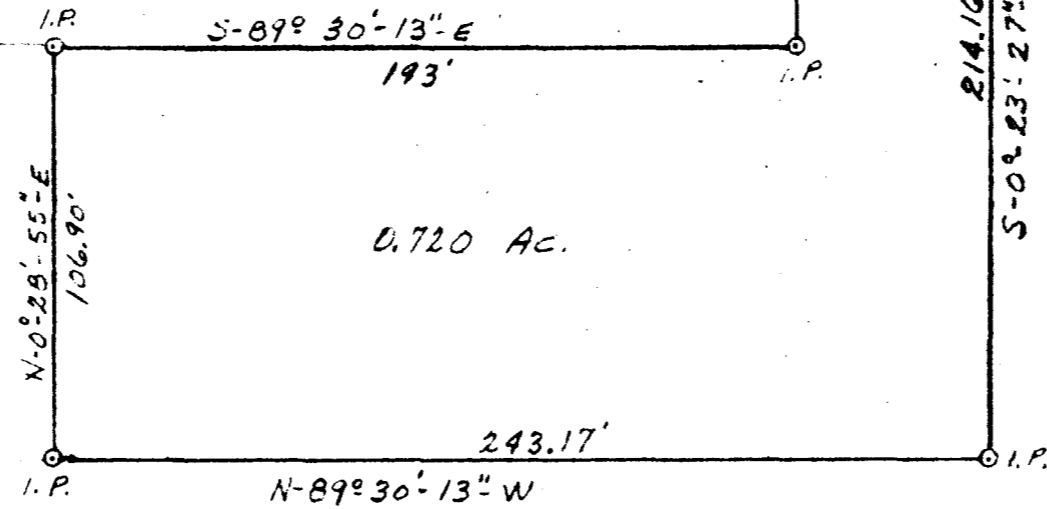

Allan C. & Anna K. Keil  
Orig. 8.512 Ac.  
D.B. 3206, Pg. 448

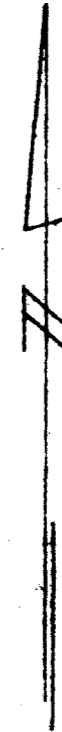

O-31-F

SURVEY OF 0.720 ACRE TRACT  
PART OF SURVEY No. 1383, VIRGINIA MILITARY LANDS  
GROVE CITY, FRANKLIN COUNTY, OHIO

For

ALLAN C. & ANNA K. KEIL

Scale 1" = 50'

June 20, 1974

R.L. Edwards & Associates  
Engineers and Surveyors  
Grove City, Ohio

*Roland Edwards*  
Registered Surveyor No. 4224

2060 120 030 042 5 KINGSTON AVE 1974 0316 030