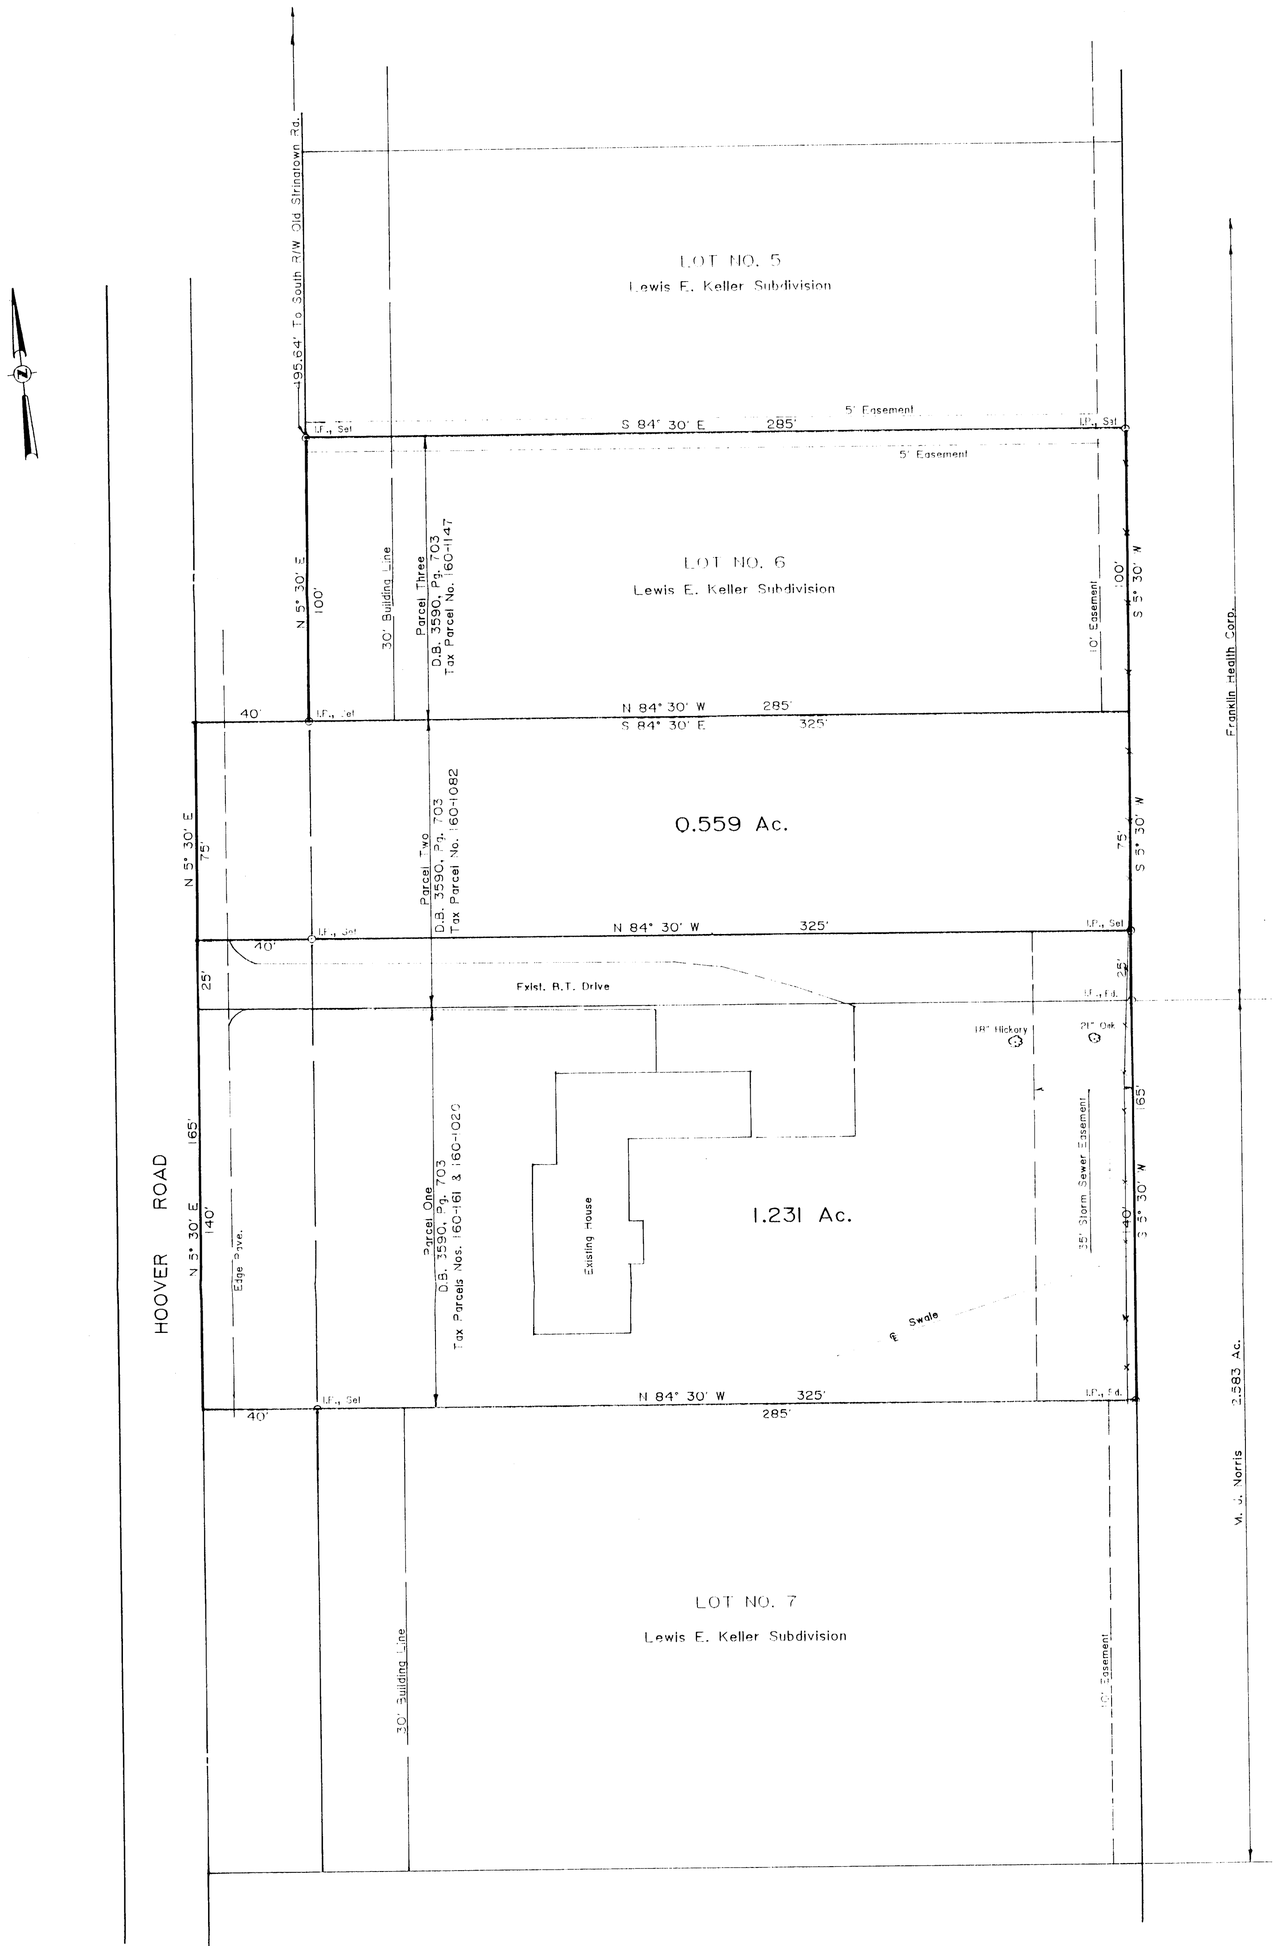

BASIS OF BEARINGS -

The bearings shown on this survey are consistent with those shown on the plat of the Lewis E. Keller Subdivision of record in Plat Book 23, Page 46, Recorder's Office, Franklin County, Ohio.

SURVEY FOR

REYNOLD A. MOLINO

&

MARY ALYCE SOMMER

OF

LOT NO. 6

LEWIS E. KELLER SUBDIVISION

&

0.559 AND 1.231 ACRE TRACTS

PART OF VIRGINIA MILITARY SURVEY NO. 8231

JACKSON TOWNSHIP, FRANKLIN COUNTY, OHIO

Scale 1" = 30'

September 1993

R. L. EDWARDS & ASSOCIATES
Engineers and Surveyors
Grove City, Ohio

Roland L. Edwards
Registered Surveyor No. 4224