


MARA ENTERPRISES, INC.
 D.B. 3587 PG. 530

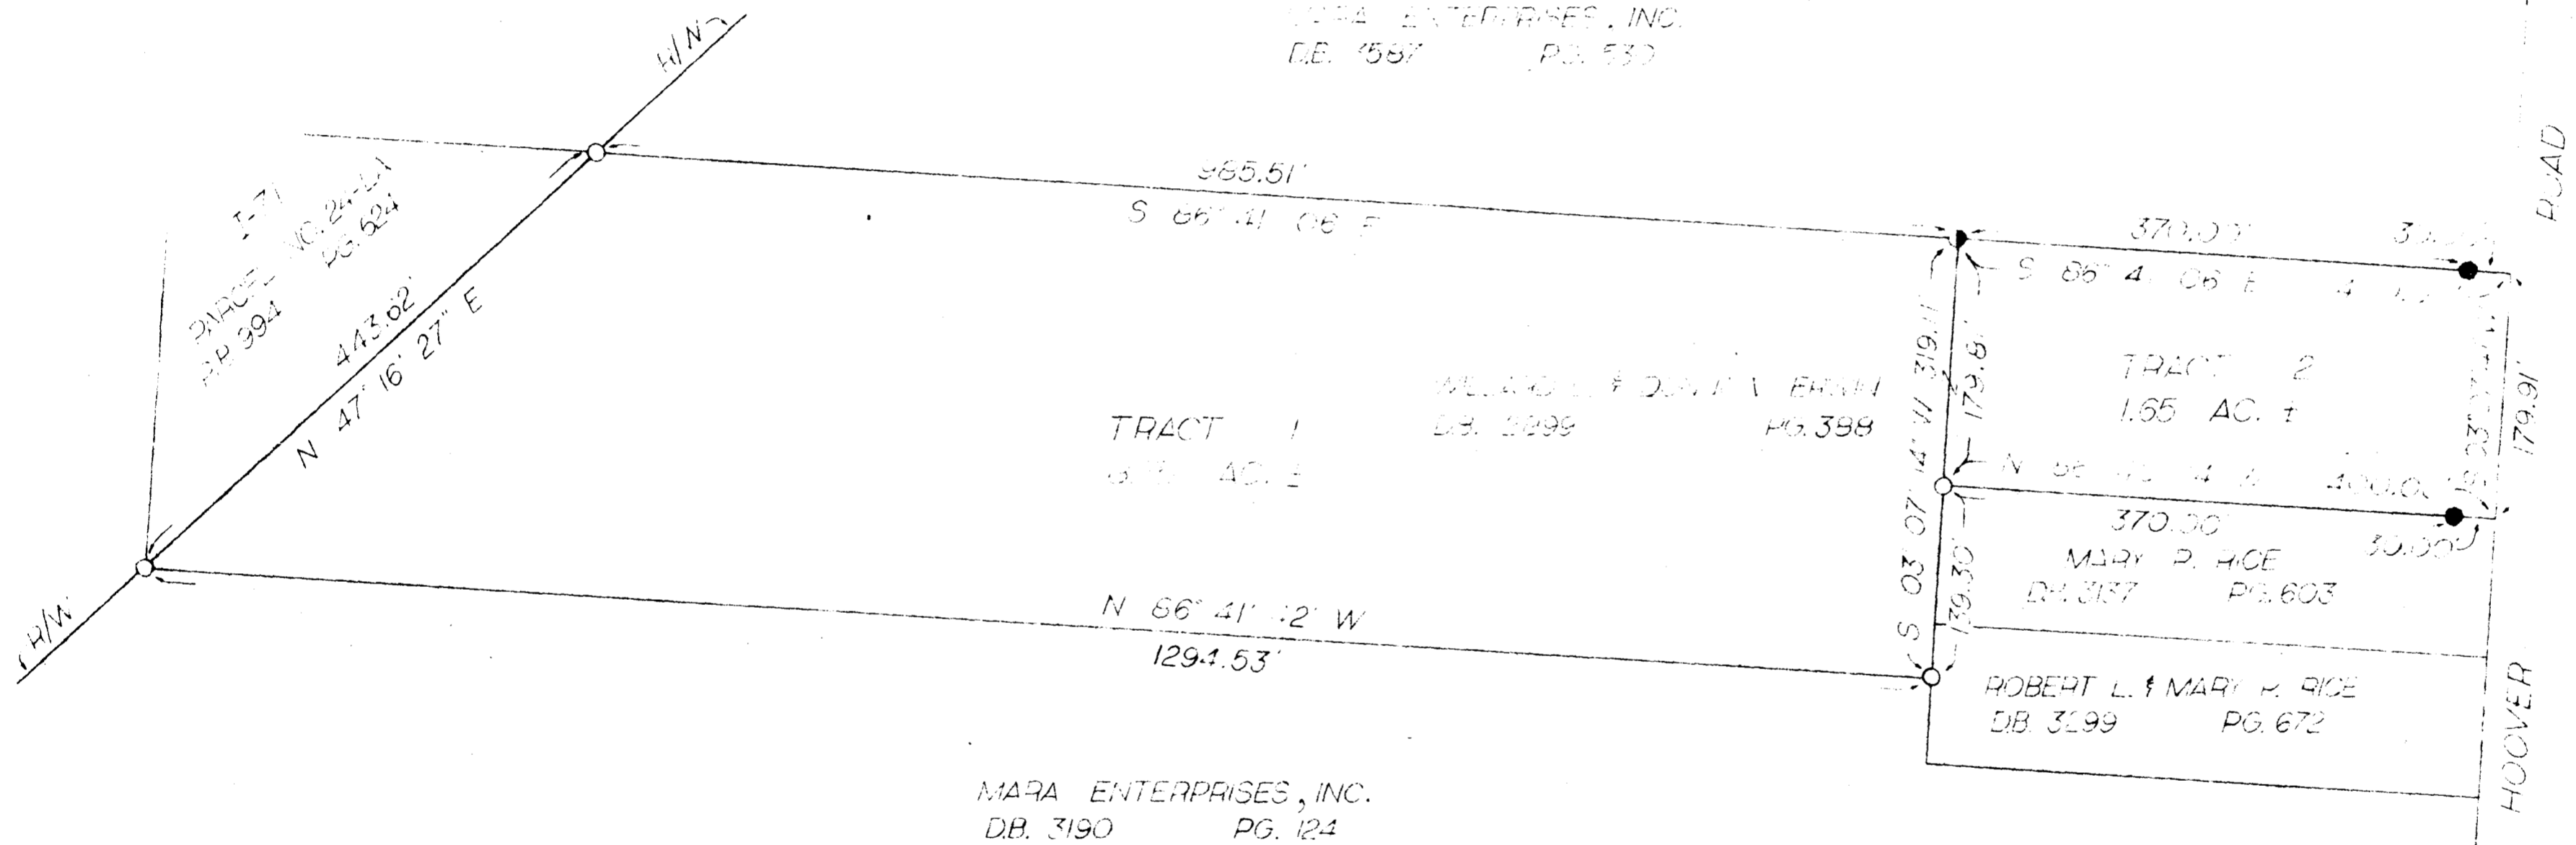

MARA ENTERPRISES, INC.
 D.B. 3190 PG. 124

MELINDA L. & DONALD A. ERWIN
 D.B. 3299 PG. 398

TRACT 2
 1.65 AC. ±
 370.00
 MARY P. RICE
 D.B. 3157 PG. 603


ROBERT L. & MARY P. RICE
 D.B. 3199 PG. 672

BEARINGS BASED ON NORTH
 LINE OF PRIDE PLAT BY
 JOHN APPEL LICENSE #5502

LEGEND

- 3/4" IRON PIPE FOUND
- 1" IRON PIPE & CAP SET
- 1/2" REBAR FOUND

SITUATED IN THE STATE OF OHIO,
 COUNTY OF FRANKLIN, TOWNSHIP
 OF JACKSON, AND BEING A PART
 OF VIRGINIA MILITARY SURVEY NO. 1434

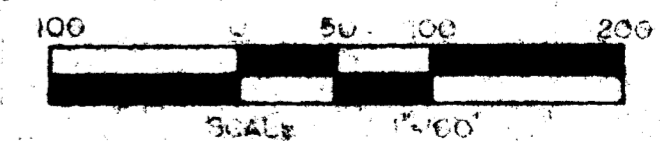

Oscar L. Hillis
 PROFESSIONAL SURVEYOR #5097

REVISIONS			FOR MARA ENTERPRISES, INC.		
NO.	DATE	BY	GROVE CITY GOLF COURSE		
1			DATE	SCALE	DRAWING NO.
