

SURVEY OF 82.3186 ACRES for RON SLOTER

CATHERINE M. BURGSTALLER + ELIZABETH T. MORBITZER
D.B. 3703 PG. 150 31.616 AC.

TERESA ENDRES
O.B. 1383 PG. 282
PARCEL 1
ORIGINALLY 28.617 AC.

V. M. S. 469

S. 74° 50' 57" E. 2771.47'

V. M. S. 478

P.O.B.

SPIKE SET DURING SURVEY OF 56.9498 AC. EAST OF S.E. 104, 6-1-87, ORIGINALLY PART OF THIS TRACT.

43.7 ± ACRE TRACT

REMAINDER OF 88 1/2 ACRE TRACT

SCALE: 1"=100'

REPUBLICAN
JAMES M. + S. J. O'BRYAN
D.B. 1913 PG. 156
35.06 AC.

1306.26'

N. 02° 58' 30" E.

RUN

DITCH

FD FENCE POST SET I.P.

N. 73° 54' 42" W.

2751.00'

ROBERT + CLARA McCLISH
D.K. 03364 J-14
32.0 AC.

GORDEN W. + MARGUERITE E. ELY
D.B. 2509 PG. 650

JESSIE L. HALL
D.B. 3465 PG. 385
5.31 AC.

GEORGE + VIRGINIA A. MAURER
D.B. 2408 PG. 624
5.30 AC.

BETTY L. LEWIS
D.B. 3652 PG. 75
4.31 AC.

CLEMENT V. + LAVANNE E. WOLFE
D.B. 2371 PG. 50
5.30 AC.


CARL L. MERLER
5.0 AC.

CHARLES A. + LULA THOMAS
6.474 AC.

JANE ESTATES
P.B. 32 PG. 1
LOT 10
LOT 11

HOLTON RD.

SITUATED IN JACKSON TOWNSHIP, FRANKLIN COUNTY, OHIO, AND BEING A PART OF VIRGINIA MILITARY SURVEY NO. 478, AND BEING ALSO A PART OF A 77.25 ACRE (88.5 ACRES, EXCEPTING 11.25 ACRES) TRACT OF LAND AND ALL OF A 43.7 ACRE TRACT OF LAND CONVEYED TO WILFORD W. SLOTER BY DEED OF RECORD IN DEED BOOK 2540, PAGE 574, FRANKLIN COUNTY RECORDER'S OFFICE.

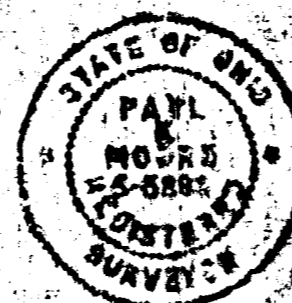

PAUL K. MOORE + ASSOC. 6316 ELLINGSTON AVE. SUITE 11 REYNOLDSBURG, OHIO 43068	
SCALE: 1"=100'	DATE: 8/10/88
BY: P.K.M.	CHECKED: P.K.M.
SURVEY OF 82.3186 AC. FOR RON SLOTER	
870	150