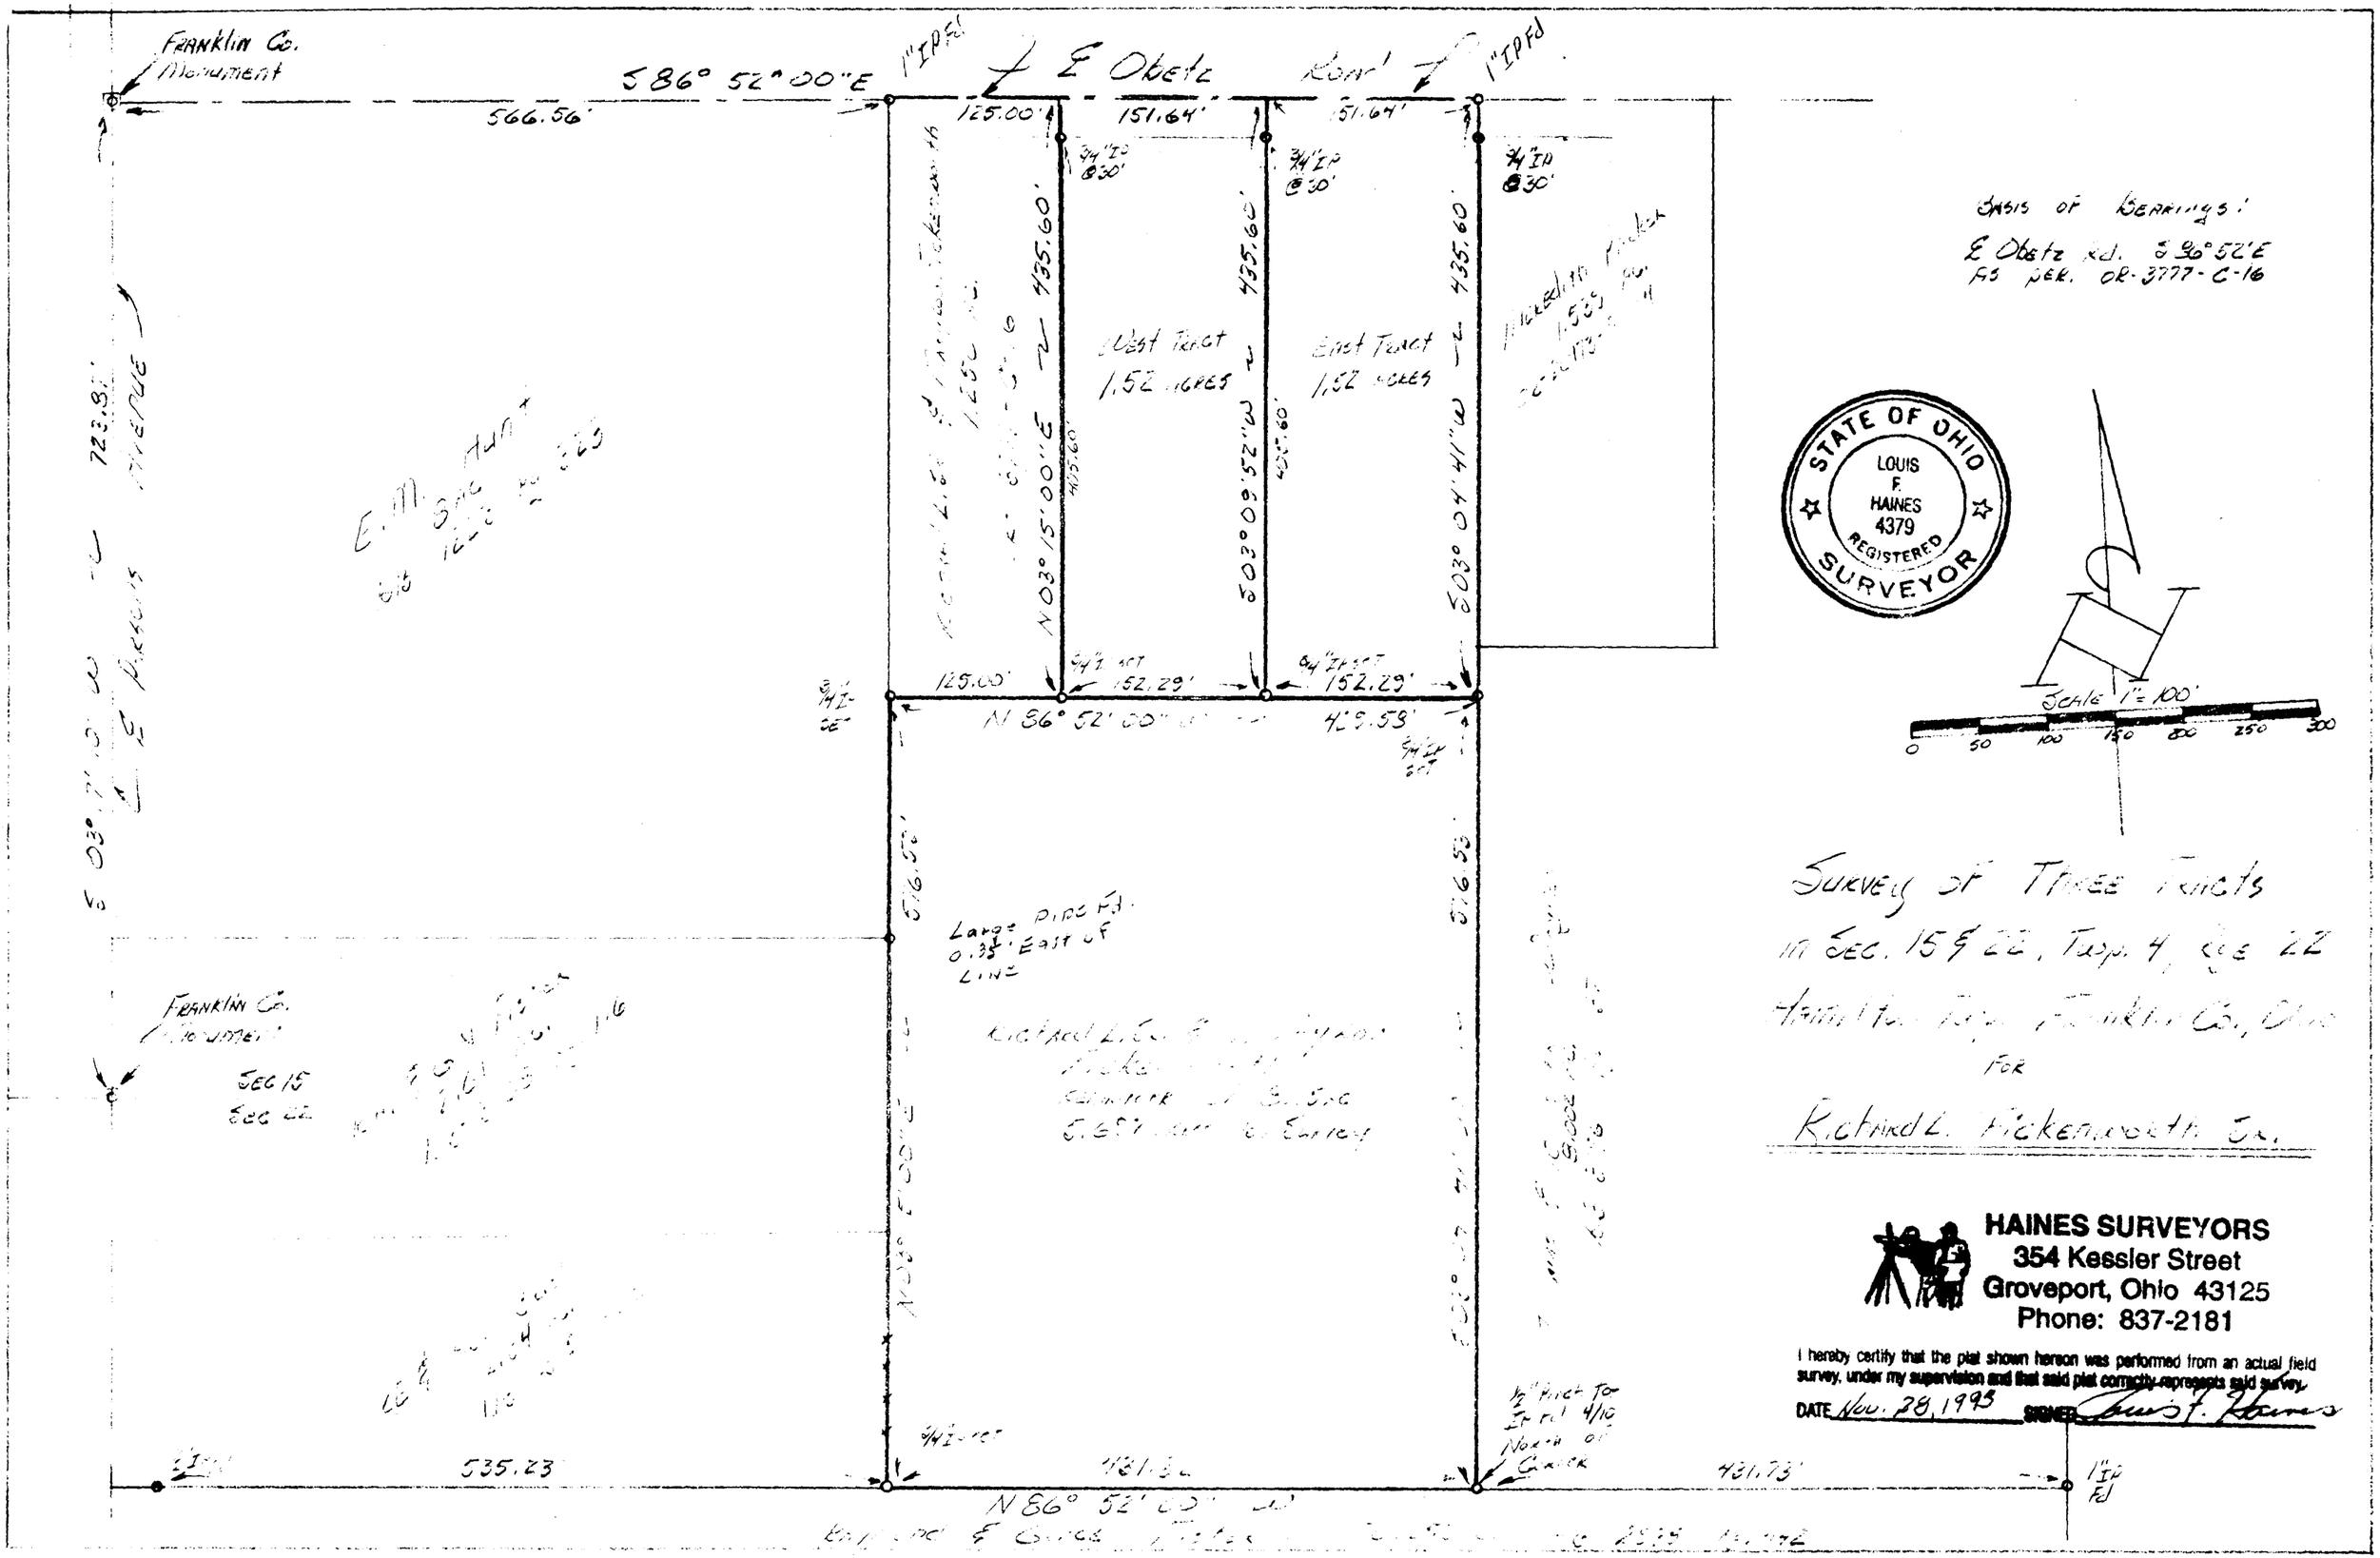
Franklin Co. Monument
S 86° 52' 00" E
E Obetz Road
1" IPFd
566.56'
125.00'
151.64'
151.64'
3/4" IP @ 30'
435.60'
N 03° 15' 00" E
S 03° 09' 52" W
S 03° 04' 41" W
West Tract 1.52 acres
East Tract 1.52 acres
3/4" IPF
152.29'
N 86° 52' 00" E
429.53'
516.53'
Large Pine Fd. 0.35' East of Line
535.23
431.73'
1" IP Fd
Basis of Bearings:
E Obetz Rd. S 86° 52' E
As per OR-3777-C-16
STATE OF OHIO
LOUIS F. HAINES
4379
REGISTERED
SURVEYOR
Scale 1" = 100'
0 50 100 150 200 250 300
Survey of Three Tracts
in Sec. 15 & 22, Twp. 4, Rge 22
Hamilton Twp., Franklin Co., Ohio
For
Richard L. Hickenbotham Jr.
HAINES SURVEYORS
354 Kessler Street
Groveport, Ohio 43125
Phone: 837-2181
I hereby certify that the plat shown hereon was performed from an actual field survey, under my supervision and that said plat correctly represents said survey.
DATE Nov. 28, 1995 SIGNED Louis F. Haines