


Being all of a 2.00 acre tract, all of a 3.00 acre tract, all of a 1.443 acre tract conveyed to The Trustees of The Walnut Hill M.E. Church shown of record in Will Record "C", Page 319, Probate Court, Deed Book 108, Page 22, Deed Book 2621, Page 303, Recorder's Office, Franklin County, Ohio, and all of a 5.1392 acre tract (by deed), and 5.198 acre tract (by survey) conveyed to Mary Lucille Fishburn shown of record in Deed Book 3778, Page 696, Recorder's Office, Franklin County, Ohio, and being a part of Section 27, Township 4, Range 22, Mathews Survey of Congress Lands, Hamilton Township, Franklin County, Ohio

I hereby certify that the foregoing plat represents a true return of survey made by me in May 1980.

Albert H. Andrews
 MYERS SURVEYING COMPANY
 Civil Engineers and Surveyors
 Bexley, Ohio

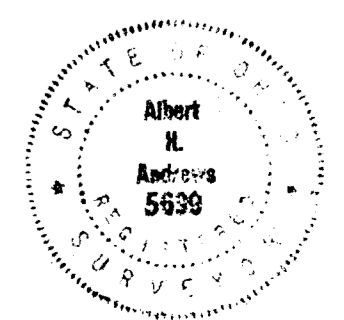

Scale 1" = 30'

May 23, 1980

WALNUT HILL UNITED METHODIST CHURCH