


0-36-B

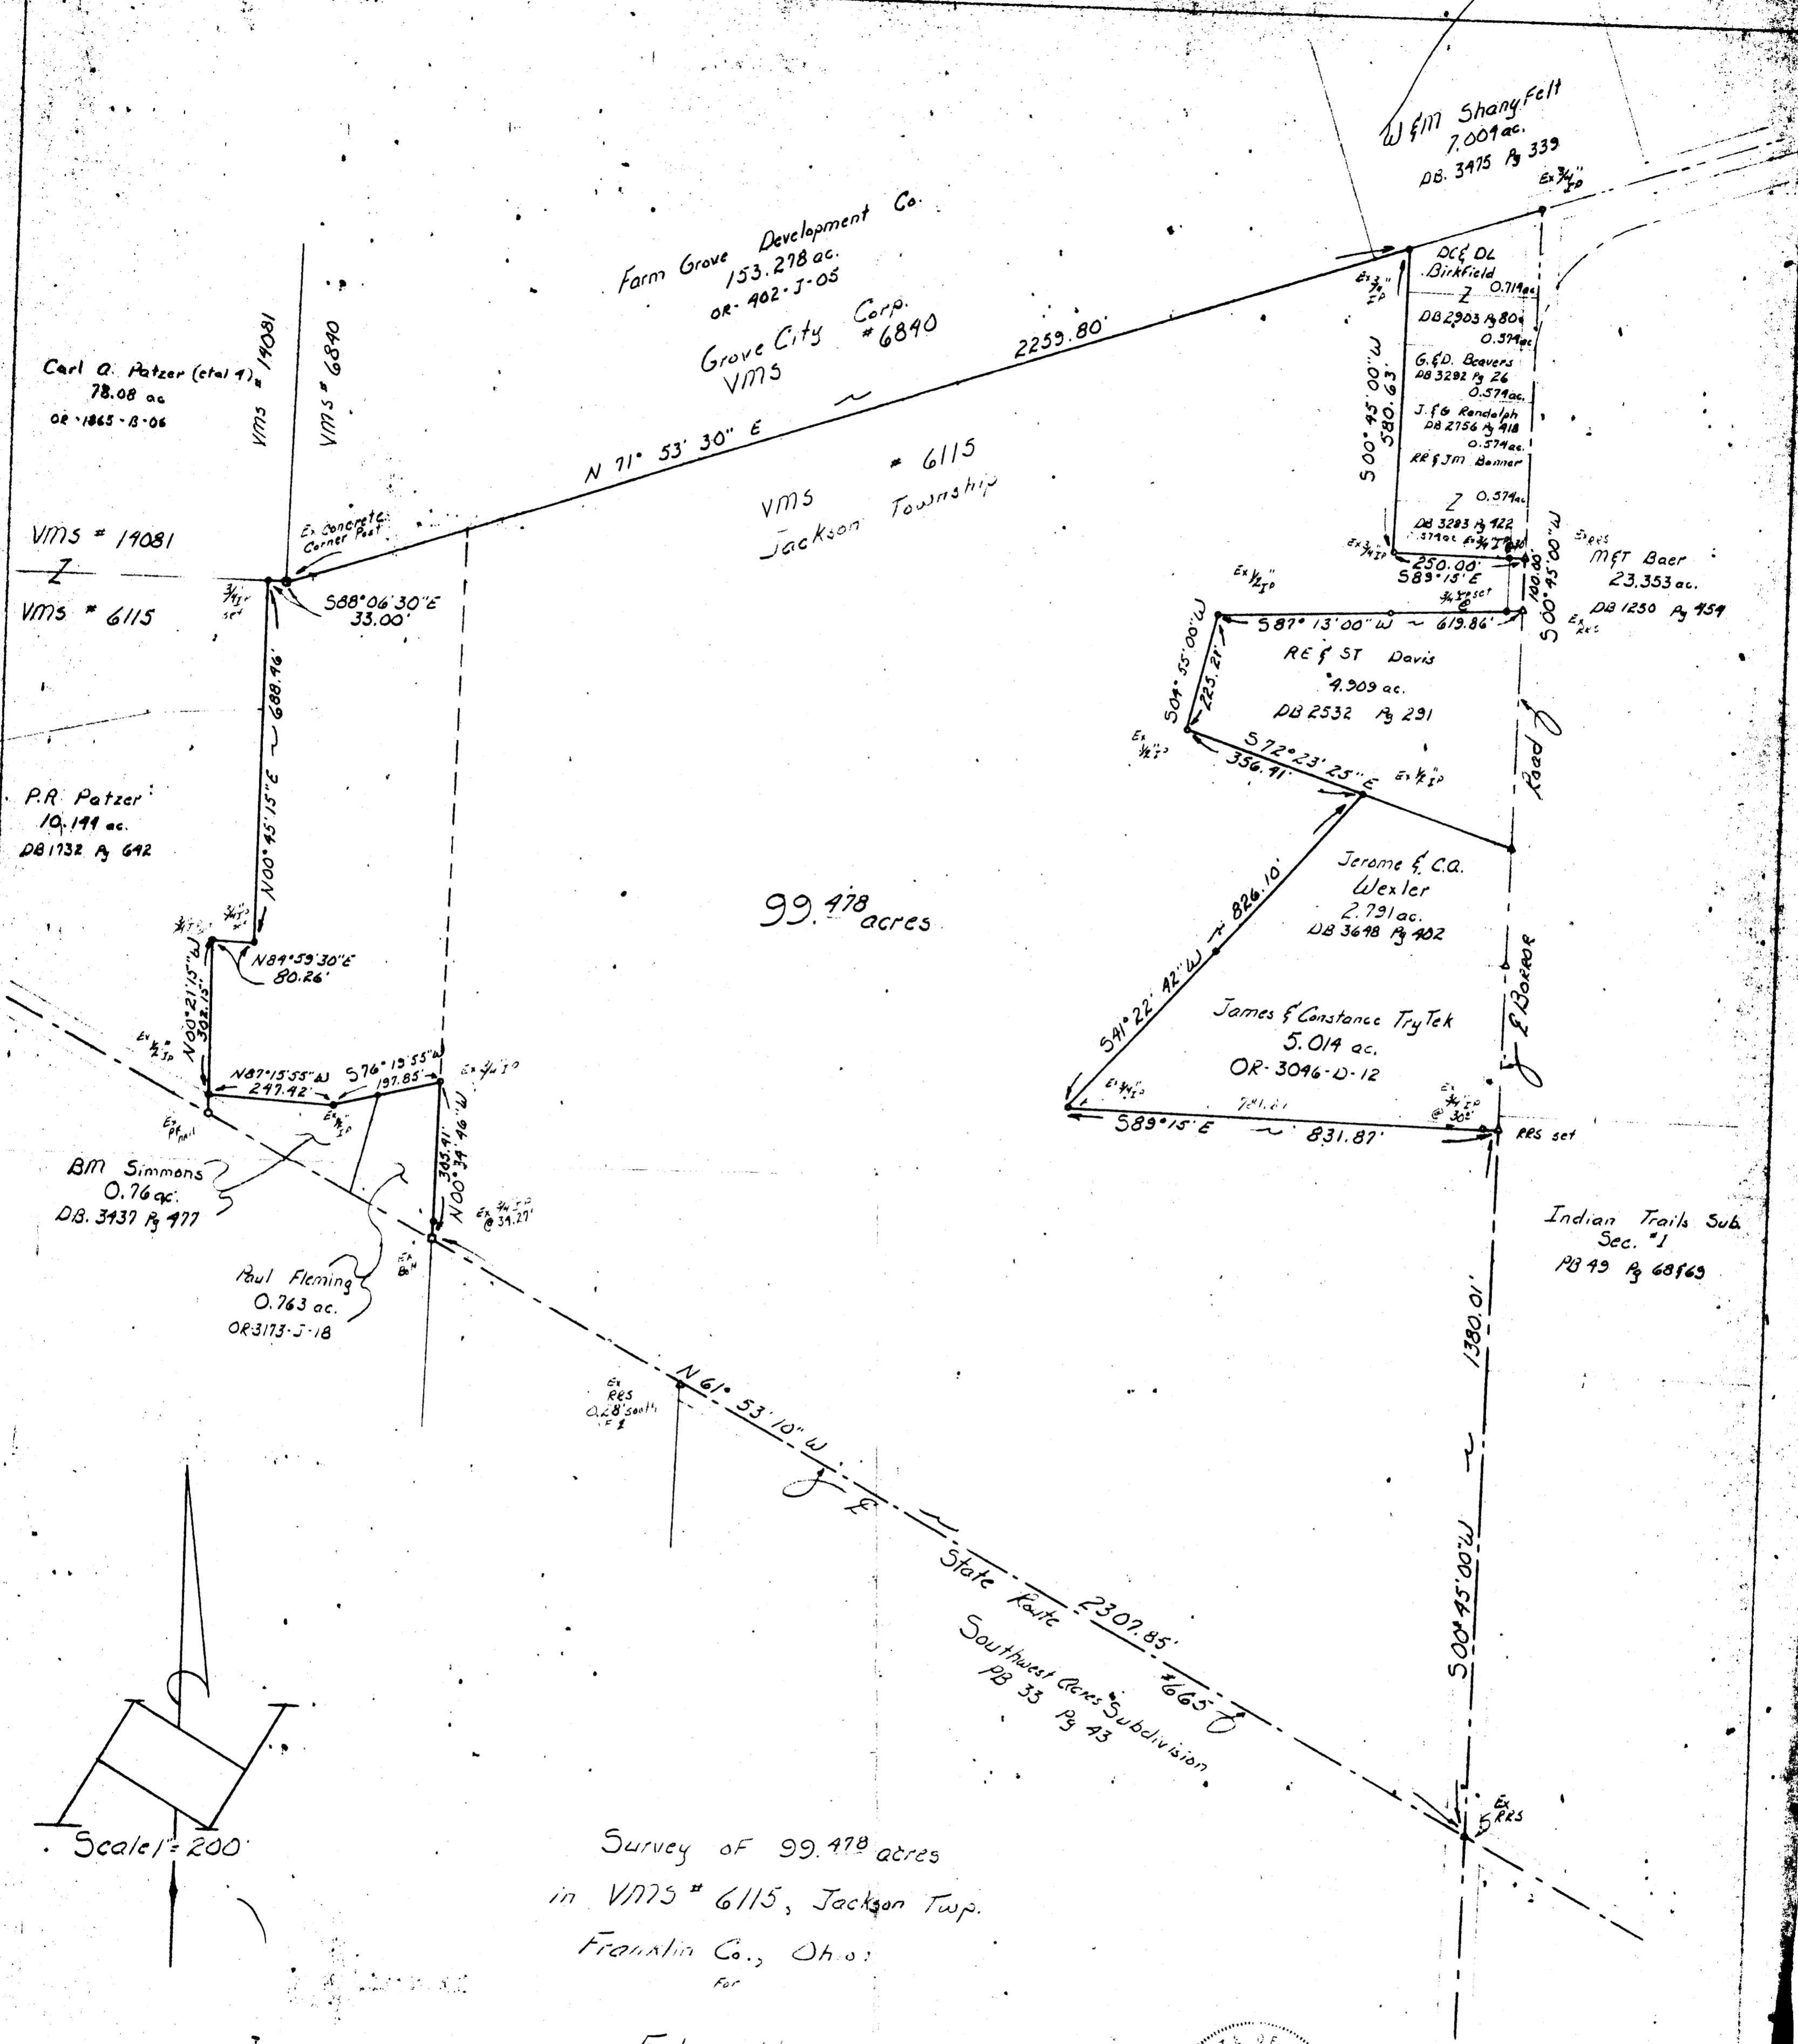


Scale 1" = 200'



Louis F Haines

354 Kessler Street
Groveport, Ohio 43125
Phone 837-2181

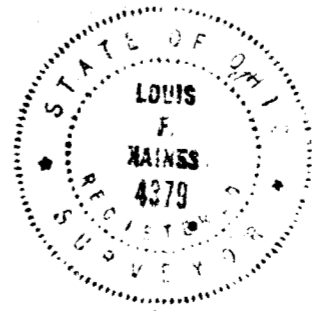

I HEREBY CERTIFY THE PLAT SHOWN HEREON
IS CORRECT AS SURVEYED BY US.
DATE: October 12, 1964
SIGNED: Louis F. Haines