


DONALD M. MYERS
7-19-73 46.837 AC. D.B. 3352, P.133

J.H. & L.L.
HANCOCK
7-9-53
1.613 AC.
D.B. 1755, P.250

O-36-C

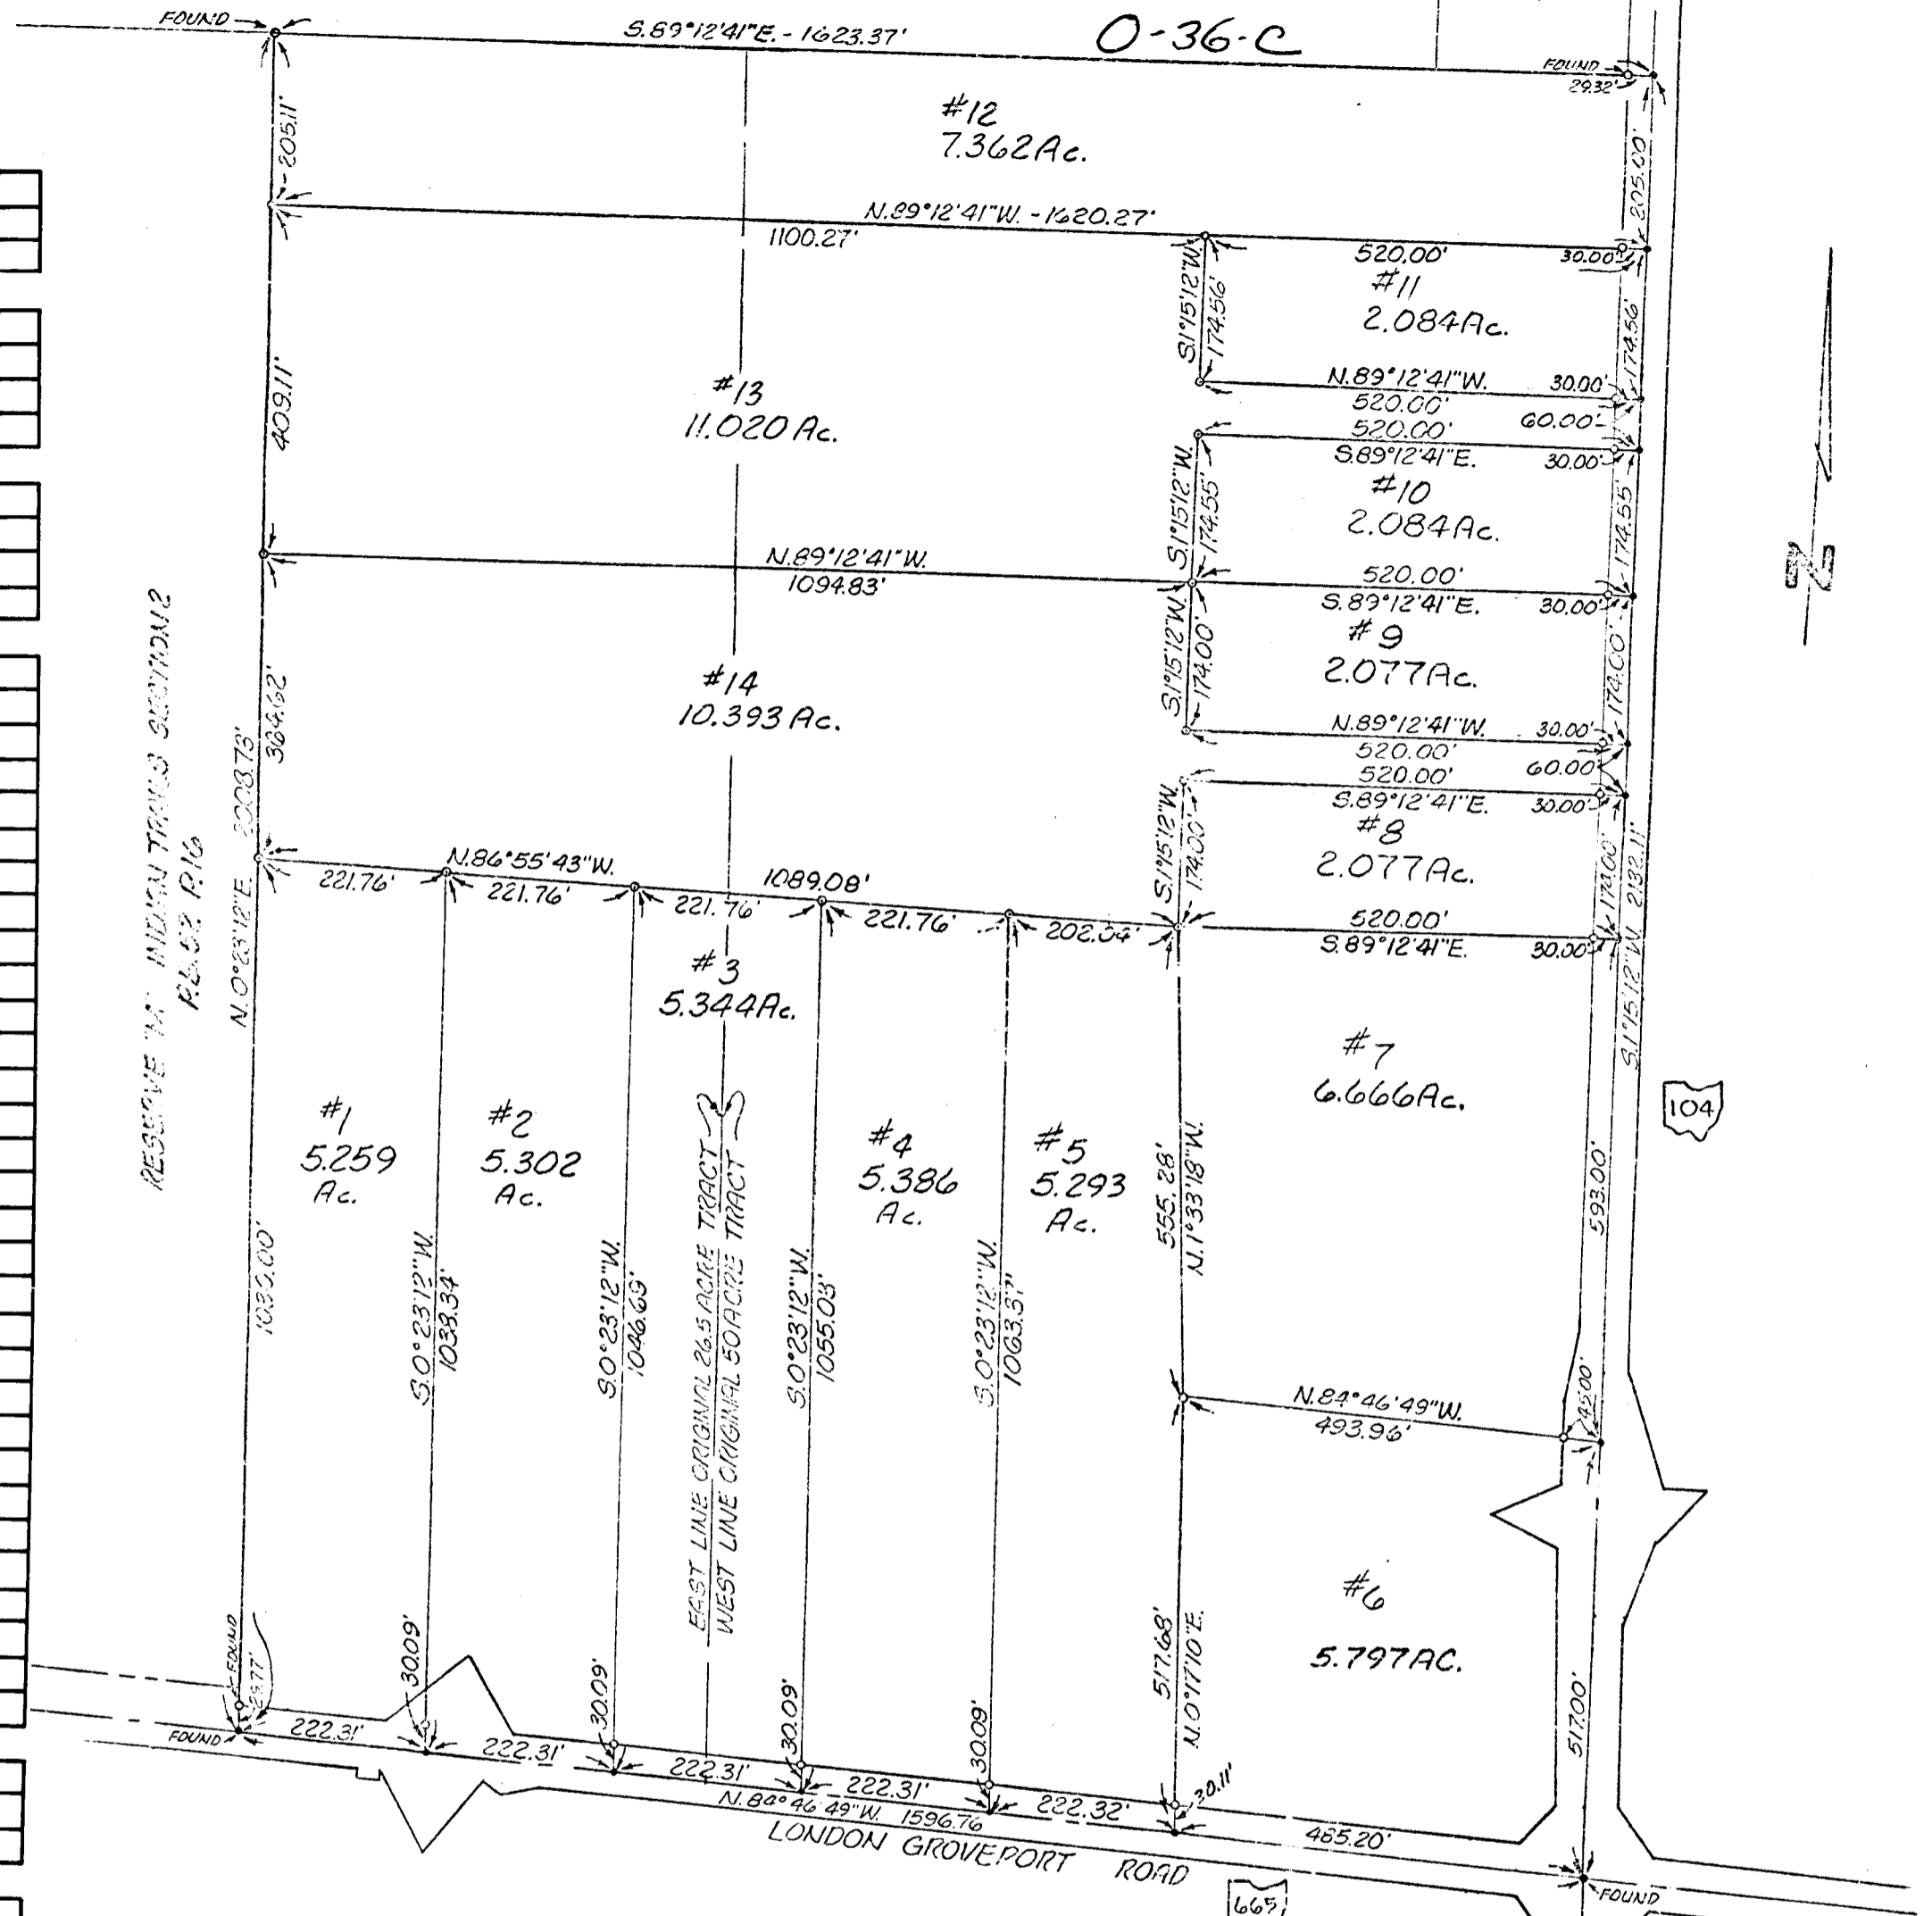

PLAT SHOWING
 SUBDIVISION OF A 26.5 ACRE TRACT & A
 50 ACRE TRACT RECORDED IN DEED BOOK 3584, P.152
 FOR
 ALAN W UTZINGER
 JACKSON TWP. FRANKLIN CO. OHIO
 SCALE: 1"=200' 4-27-78

Harry L. Lewick
 REGISTERED SURVEYOR # 6395

EXCEPT AS NOTED:
 IRON PIPE SET = o
 RR SPIKE SET = •

REVISED 10-25-78
 REVISED 6-19-78