

GERTRUDE SHOAF ET AL (1)
 D.B. 2739 PAGE 243

Situated in Virginia Military
 Survey No. 1108, Jackson Twp
 Franklin County, Ohio


Survey of Acreage Parcels
 For
 Shoaf Realty
 By
 P.E. MARTIN & ASSOCIATES
 Engineers, Land Planners, Surveyors
 Columbus, Ohio

June, 1968 Scale: 1" = 100'

By P.E. Martin
 Registered Surveyor #4928

CLARA KRUEGER

HINER ROAD N 6° 04' 15" W

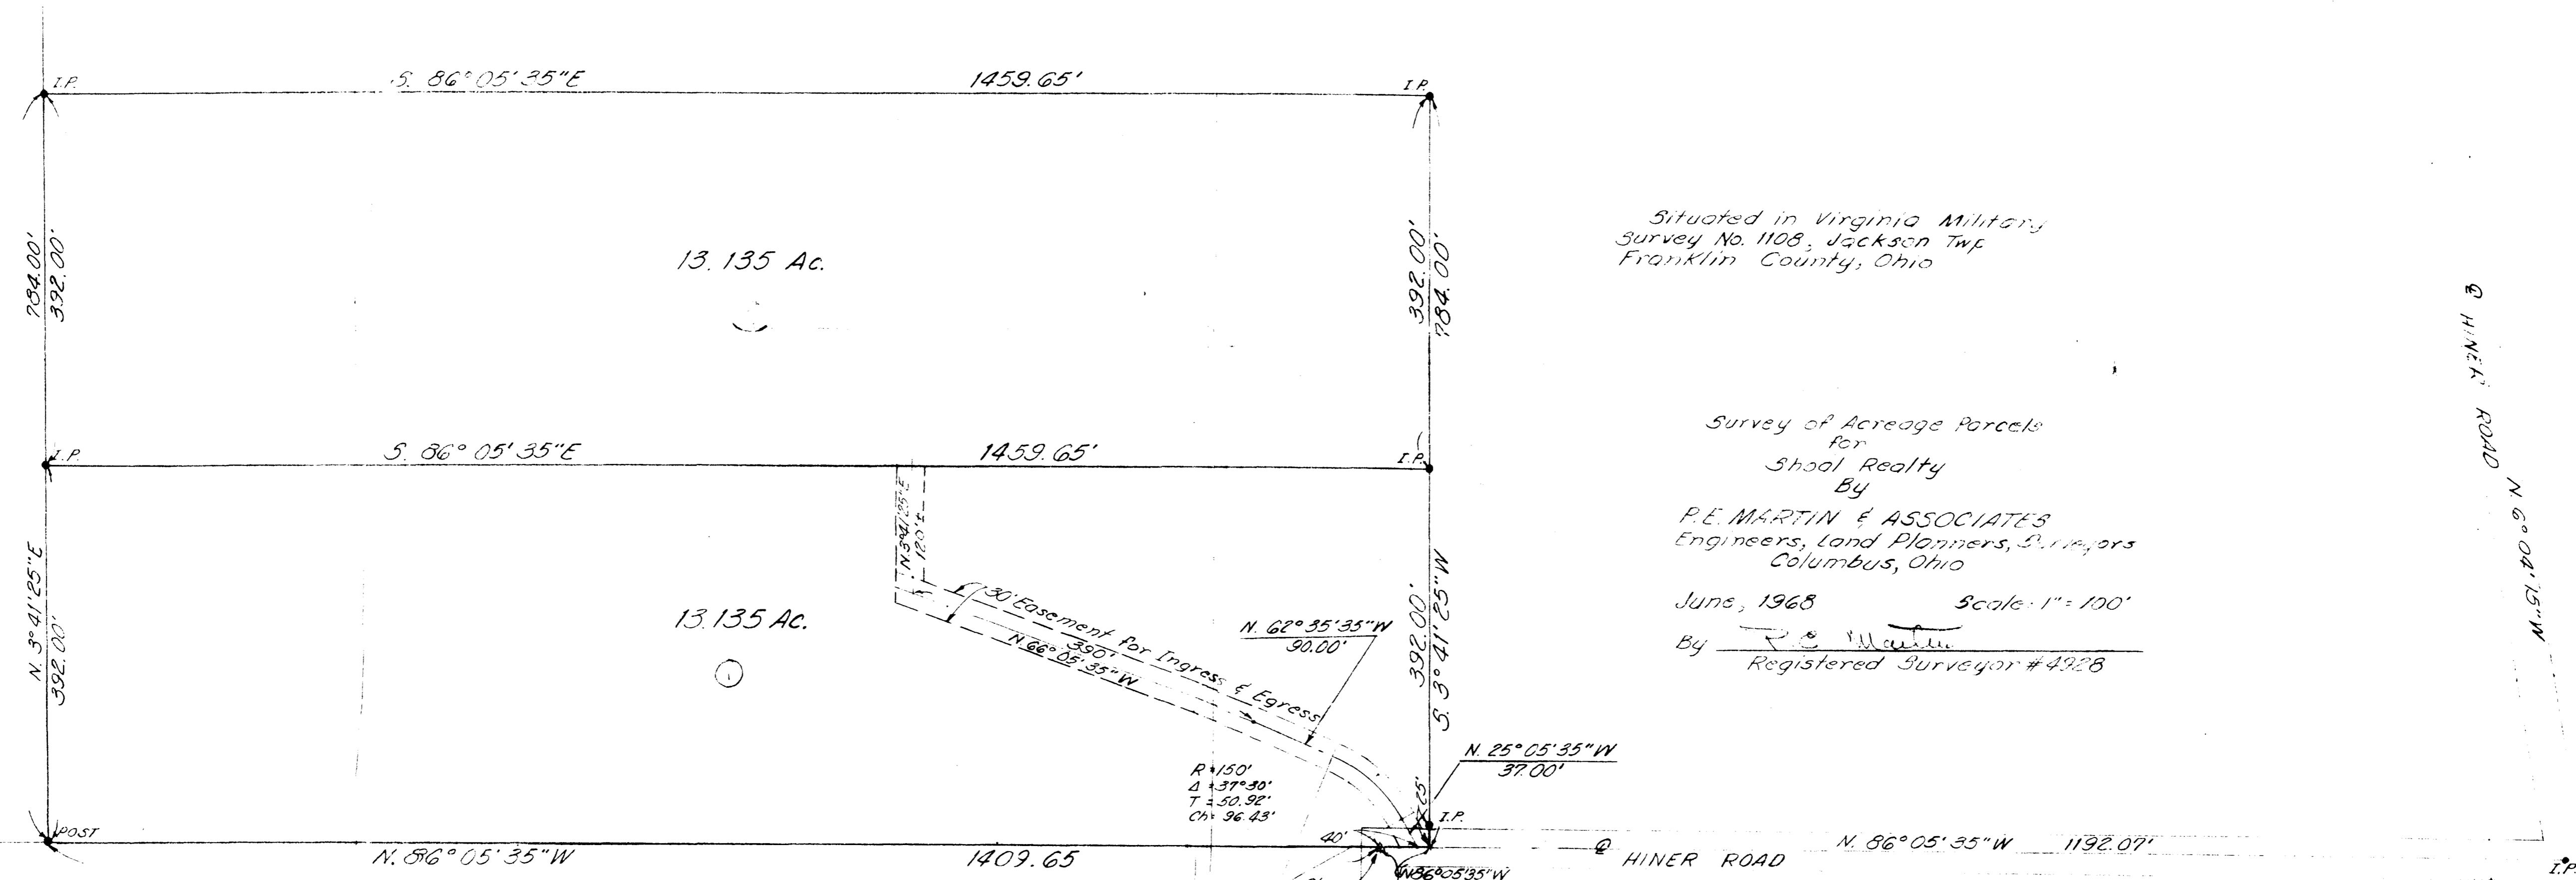

JOHN H. GOEBEL

R 150'
 Ch 96.43'



2240 120 094 038 W HINER 1968 0367 03