




NORTH  
SCALE: 1"=50'

SITUATED IN THE STATE OF OHIO,  
COUNTY OF FRANKLIN, TOWNSHIP  
OF HAMILTON,  
FRANKLIN COUNTY ENGINEERS T&M MAP 028

THIS PLAT WAS BASED ON AN ACTUAL FIELD  
SURVEY BY THE JERRY A. MALOTT  
SURVEYING CO. IN FEBRUARY 1988  
BEARINGS FOR THIS PARCEL WERE BASED ON  
PREVIOUS RECORDS SHOWING THE EASTERLY  
LINE OF EAST ALLEY AS BEING N03°30' WEST

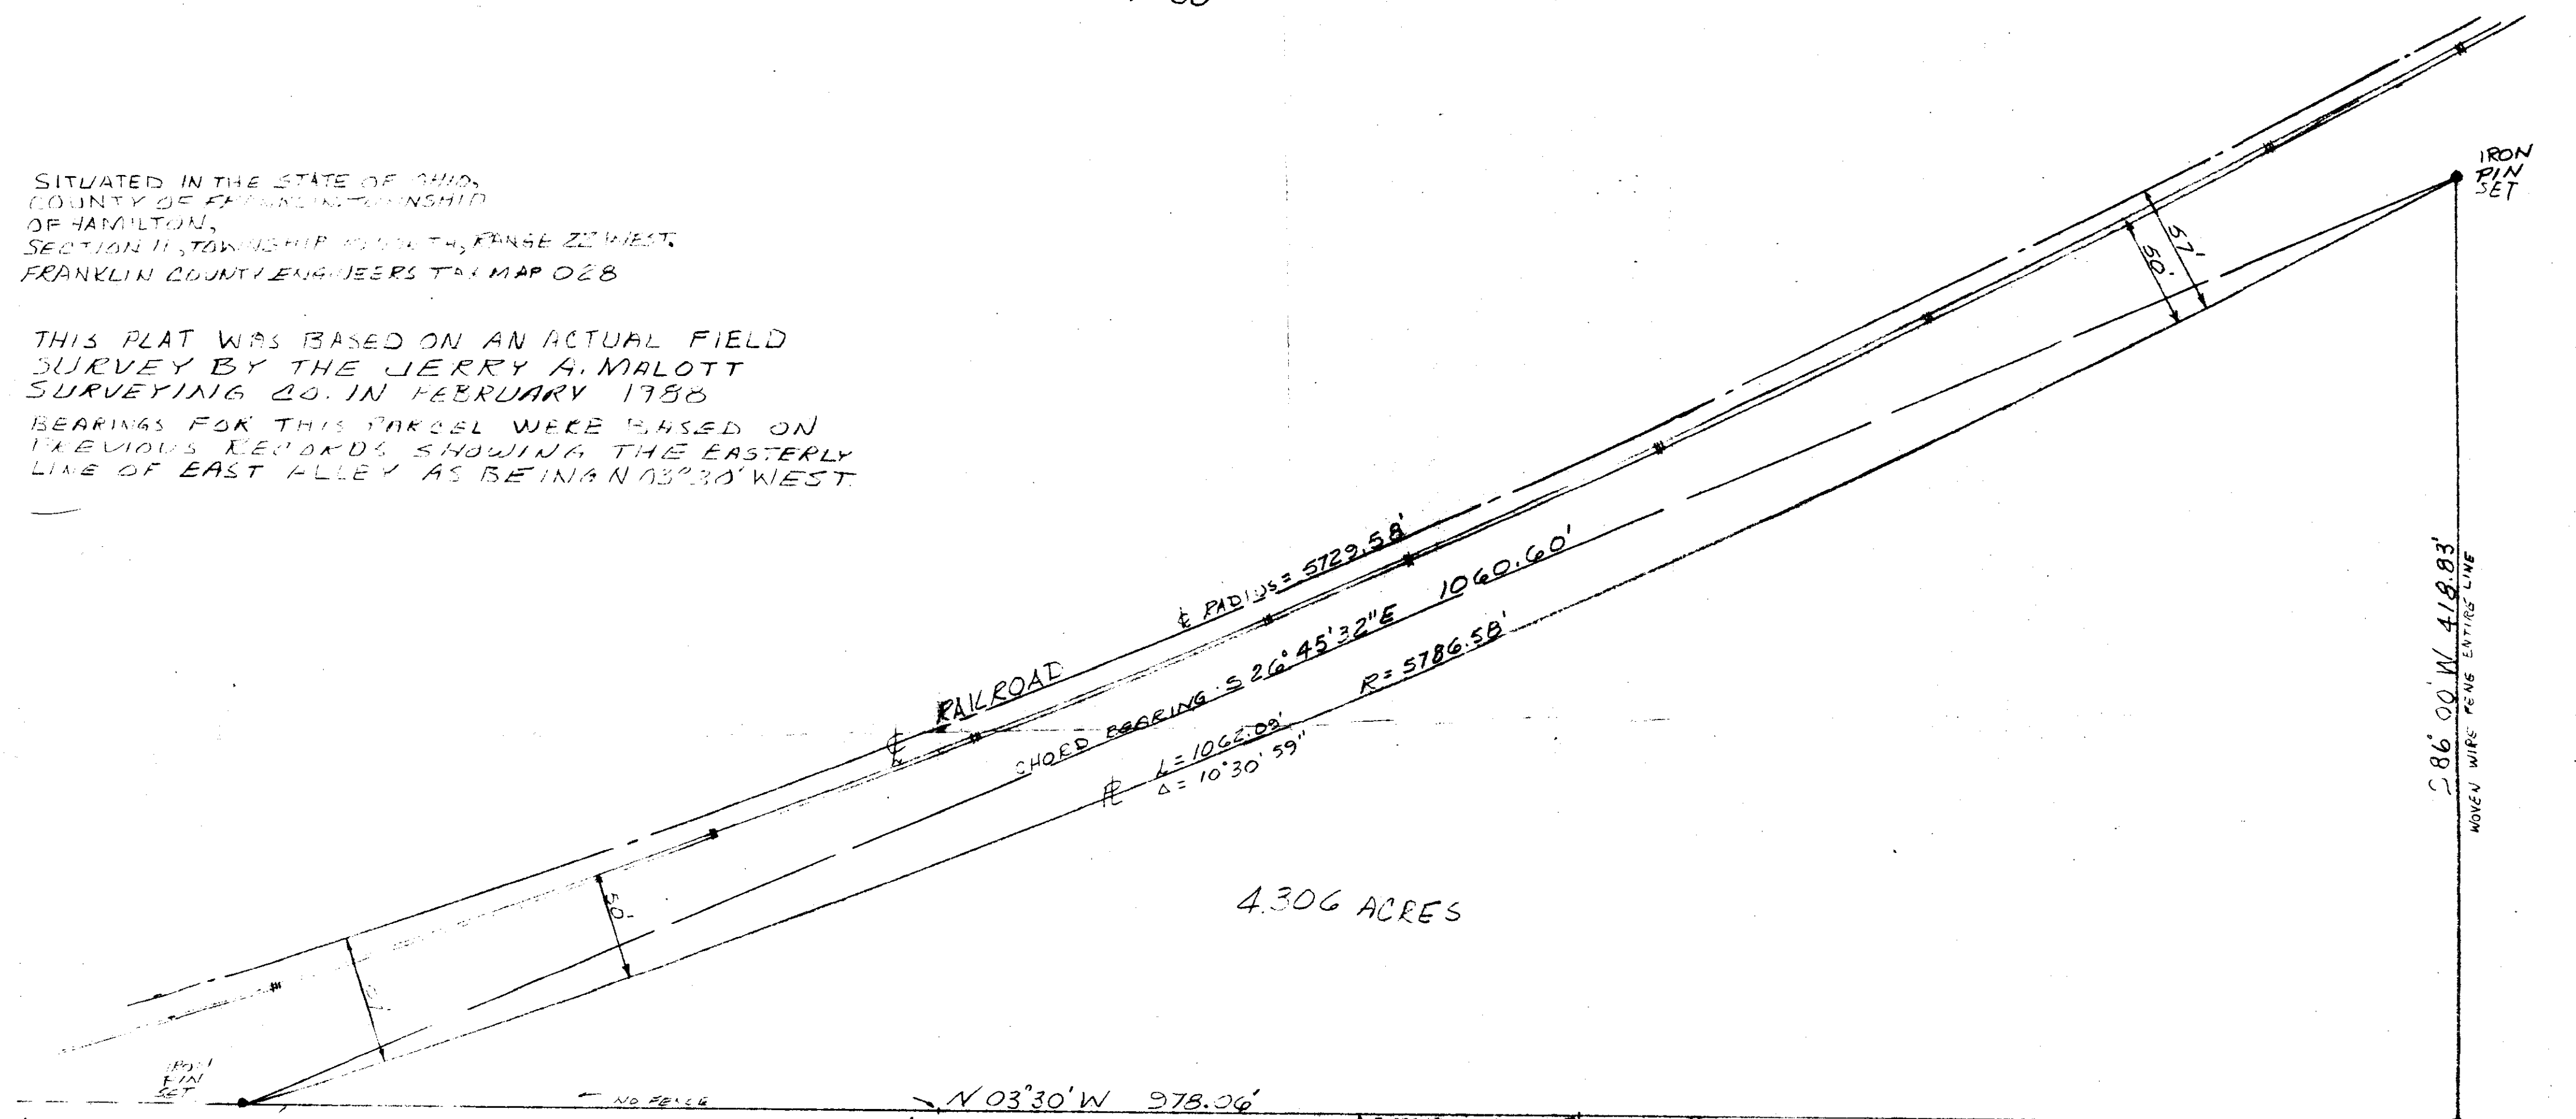

4.306 ACRES

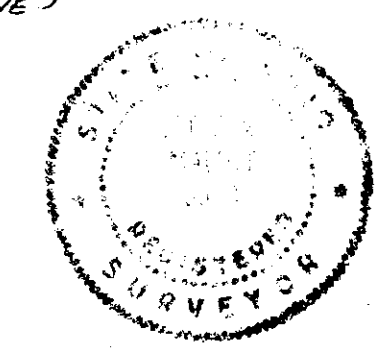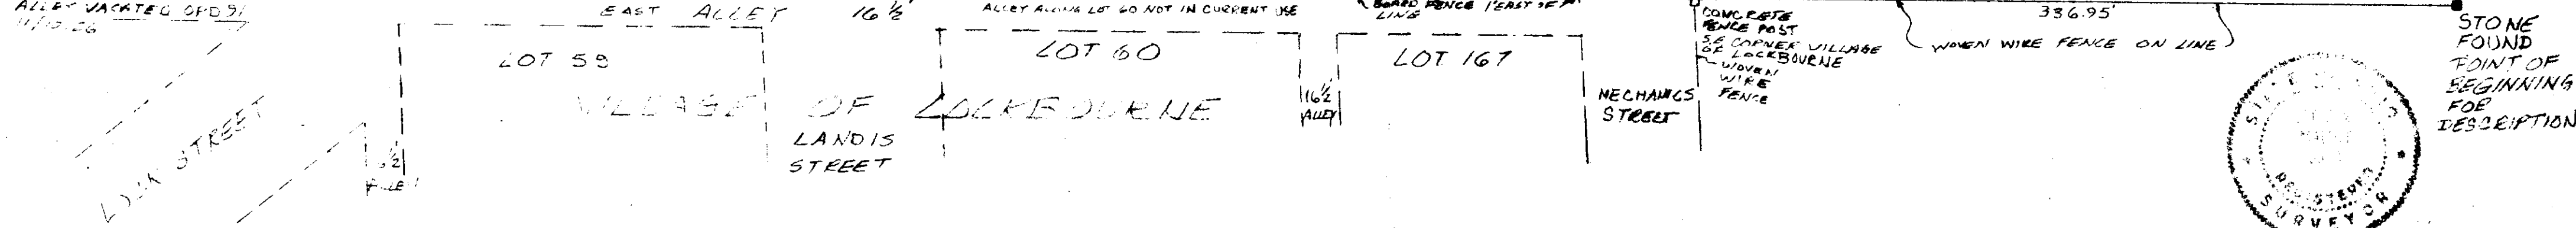

THE  
JERRY A. MALOTT SURVEYING CO.  
3394 PARKRIDGE DRIVE  
GROVE CITY, OHIO 43123

SURVEY PLAT FOR  
RAY MILLS AND CSX TRANSPORTATION

NO.	DATE	BY	REVISIONS	NO.	DATE	BY	REVISIONS
1	2/27/88	JAM	NEW PLW LOCATIONS FOR NEW TRACKS				
2	2/26/88	JAM	ADDED BASIS OF SURVEY				

DETAIL:	DRAWN BY: JAM	DATE: 12/07/87
PLAN:	CHECKED BY:	SCALE: AS NOTED
JOB NO.:	APPROVED BY:	

*Jerry A. Malott*  
REGISTERED SURVEYOR NO. 5365

SHEET NO.  
1 of 1