


BROWN TWP
0-8-E

0-8-E

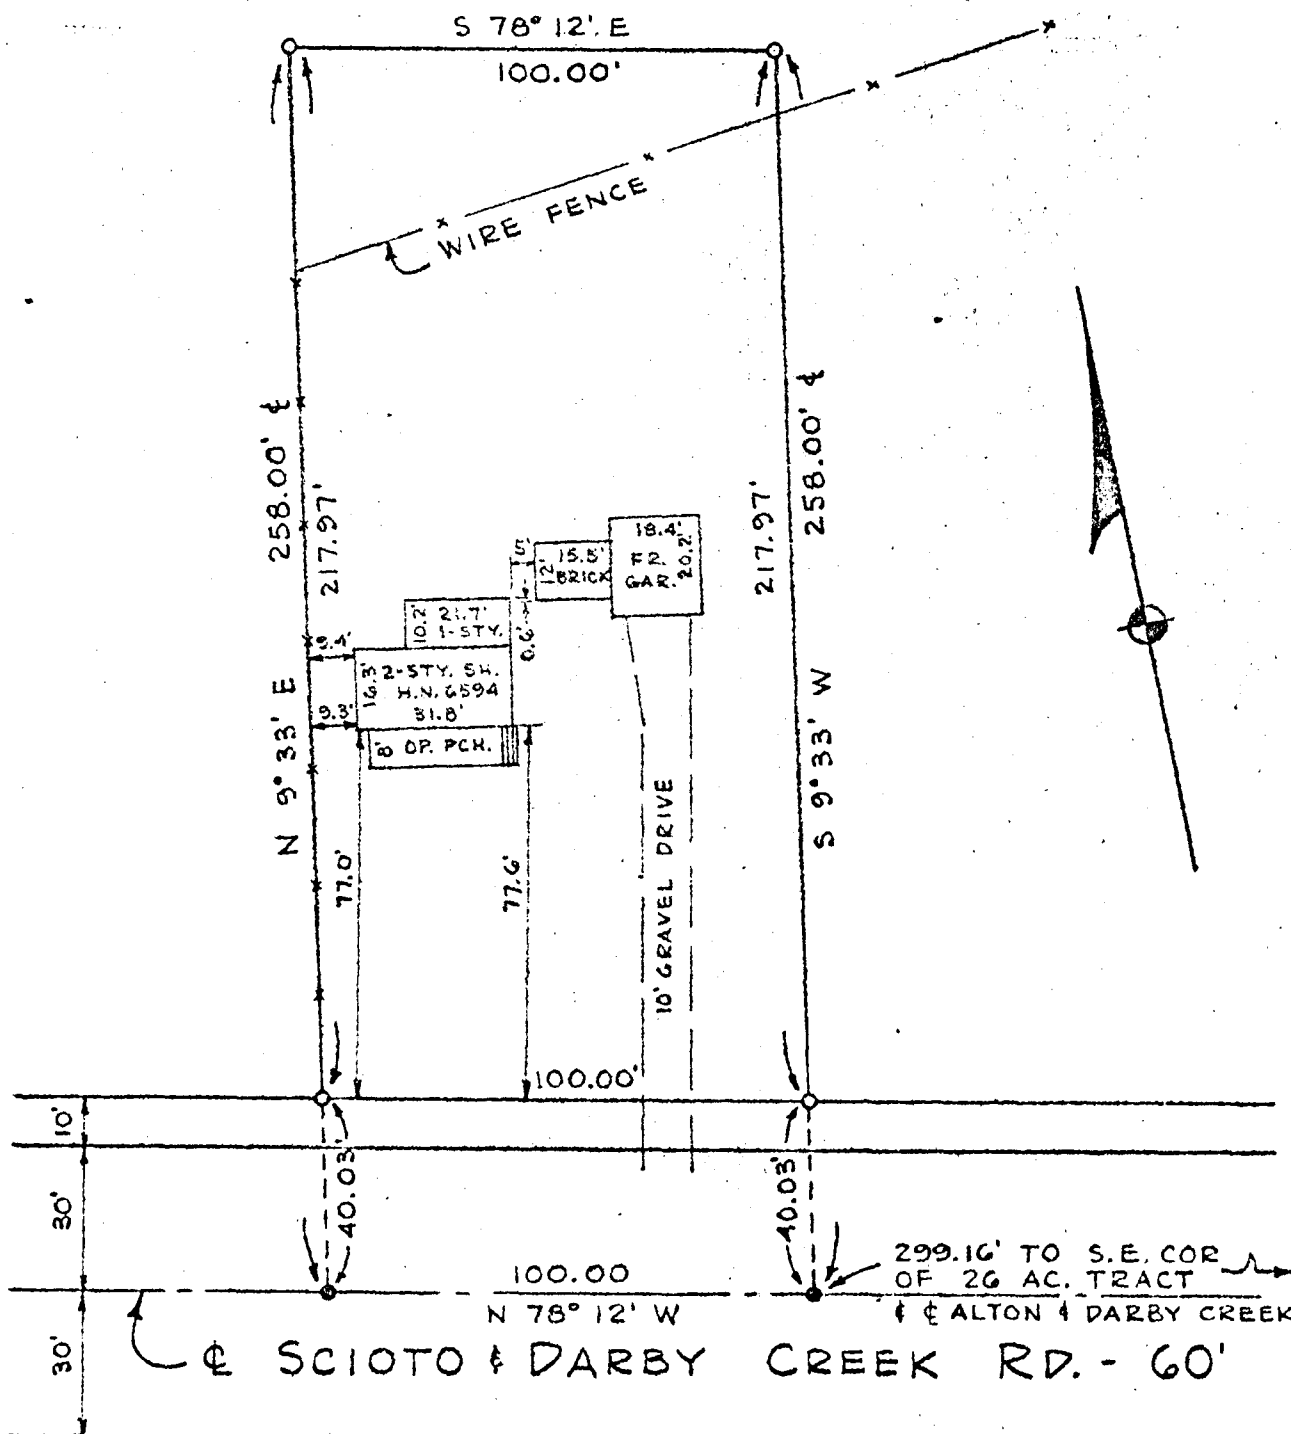

SURVEYING & LOCATING HOUSE ON 0. AC. IN
V.M.S. 6640, BROWN TWP, FRANKLIN CO., OHIO
FOR DR. CLARENCE L. MAXWELL
SCALE: 1" = 40' JAN. 12, 1971

C.F. BIRD & R.J. BULL, LTD.
6113 LINWORTH RD.
WORTHINGTON, OHIO

Richard J. Bull

○ - IRON PIN
● - RAILROAD SPIKE
SV-392

77357400
77607400

3-8-0

4030 120 030 059 N SCIOTO DARBY CREEK RD 119711 119711 119711 119711