MBJ-41-F

Louis F Haines & Associa...
354 Kessler Stre...
Groveport, Ohio
Phone 836-5531

0-41-F

SURVEY FOR

EMIL & GISELA HEURICH

Being 1.502 Acres in the
N.E.¼ Sec. 17, Twp. 11, R. 21, Village
of Groveport, Franklin County,
Ohio

P.B. Page Franklin Co. Rec. Office

Scale 1" = 60'

DATE Nov. 21, 1975

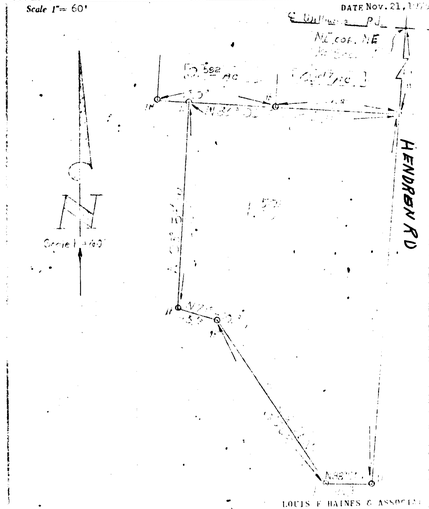

LOUIS F HAINES & ASSOC.

BY _____ Registered

I hereby certify that the foregoing plot was prepared from an actual survey of the premises. No side line of principal building is encroached thereon. Bldg. lines not shown unless indicated. Mortgage Loan & Title Insurance purposes only.

1975																			
1976																			
1980																			

856 0850