


PLAT OF SURVEY OF A 7.281 ACRE TRACT

SITUATED IN LOT 40 QTR. TWP. 4, TWP. 2, RANGE 16, UNITED STATES MILITARY LANDS
STATE OF OHIO, COUNTY OF FRANKLIN, VILLAGE OF NEW ALBANY
FOR

LAWYERS TITLE INSURANCE CORPORATION
and/or
THE NEW ALBANY COMPANY

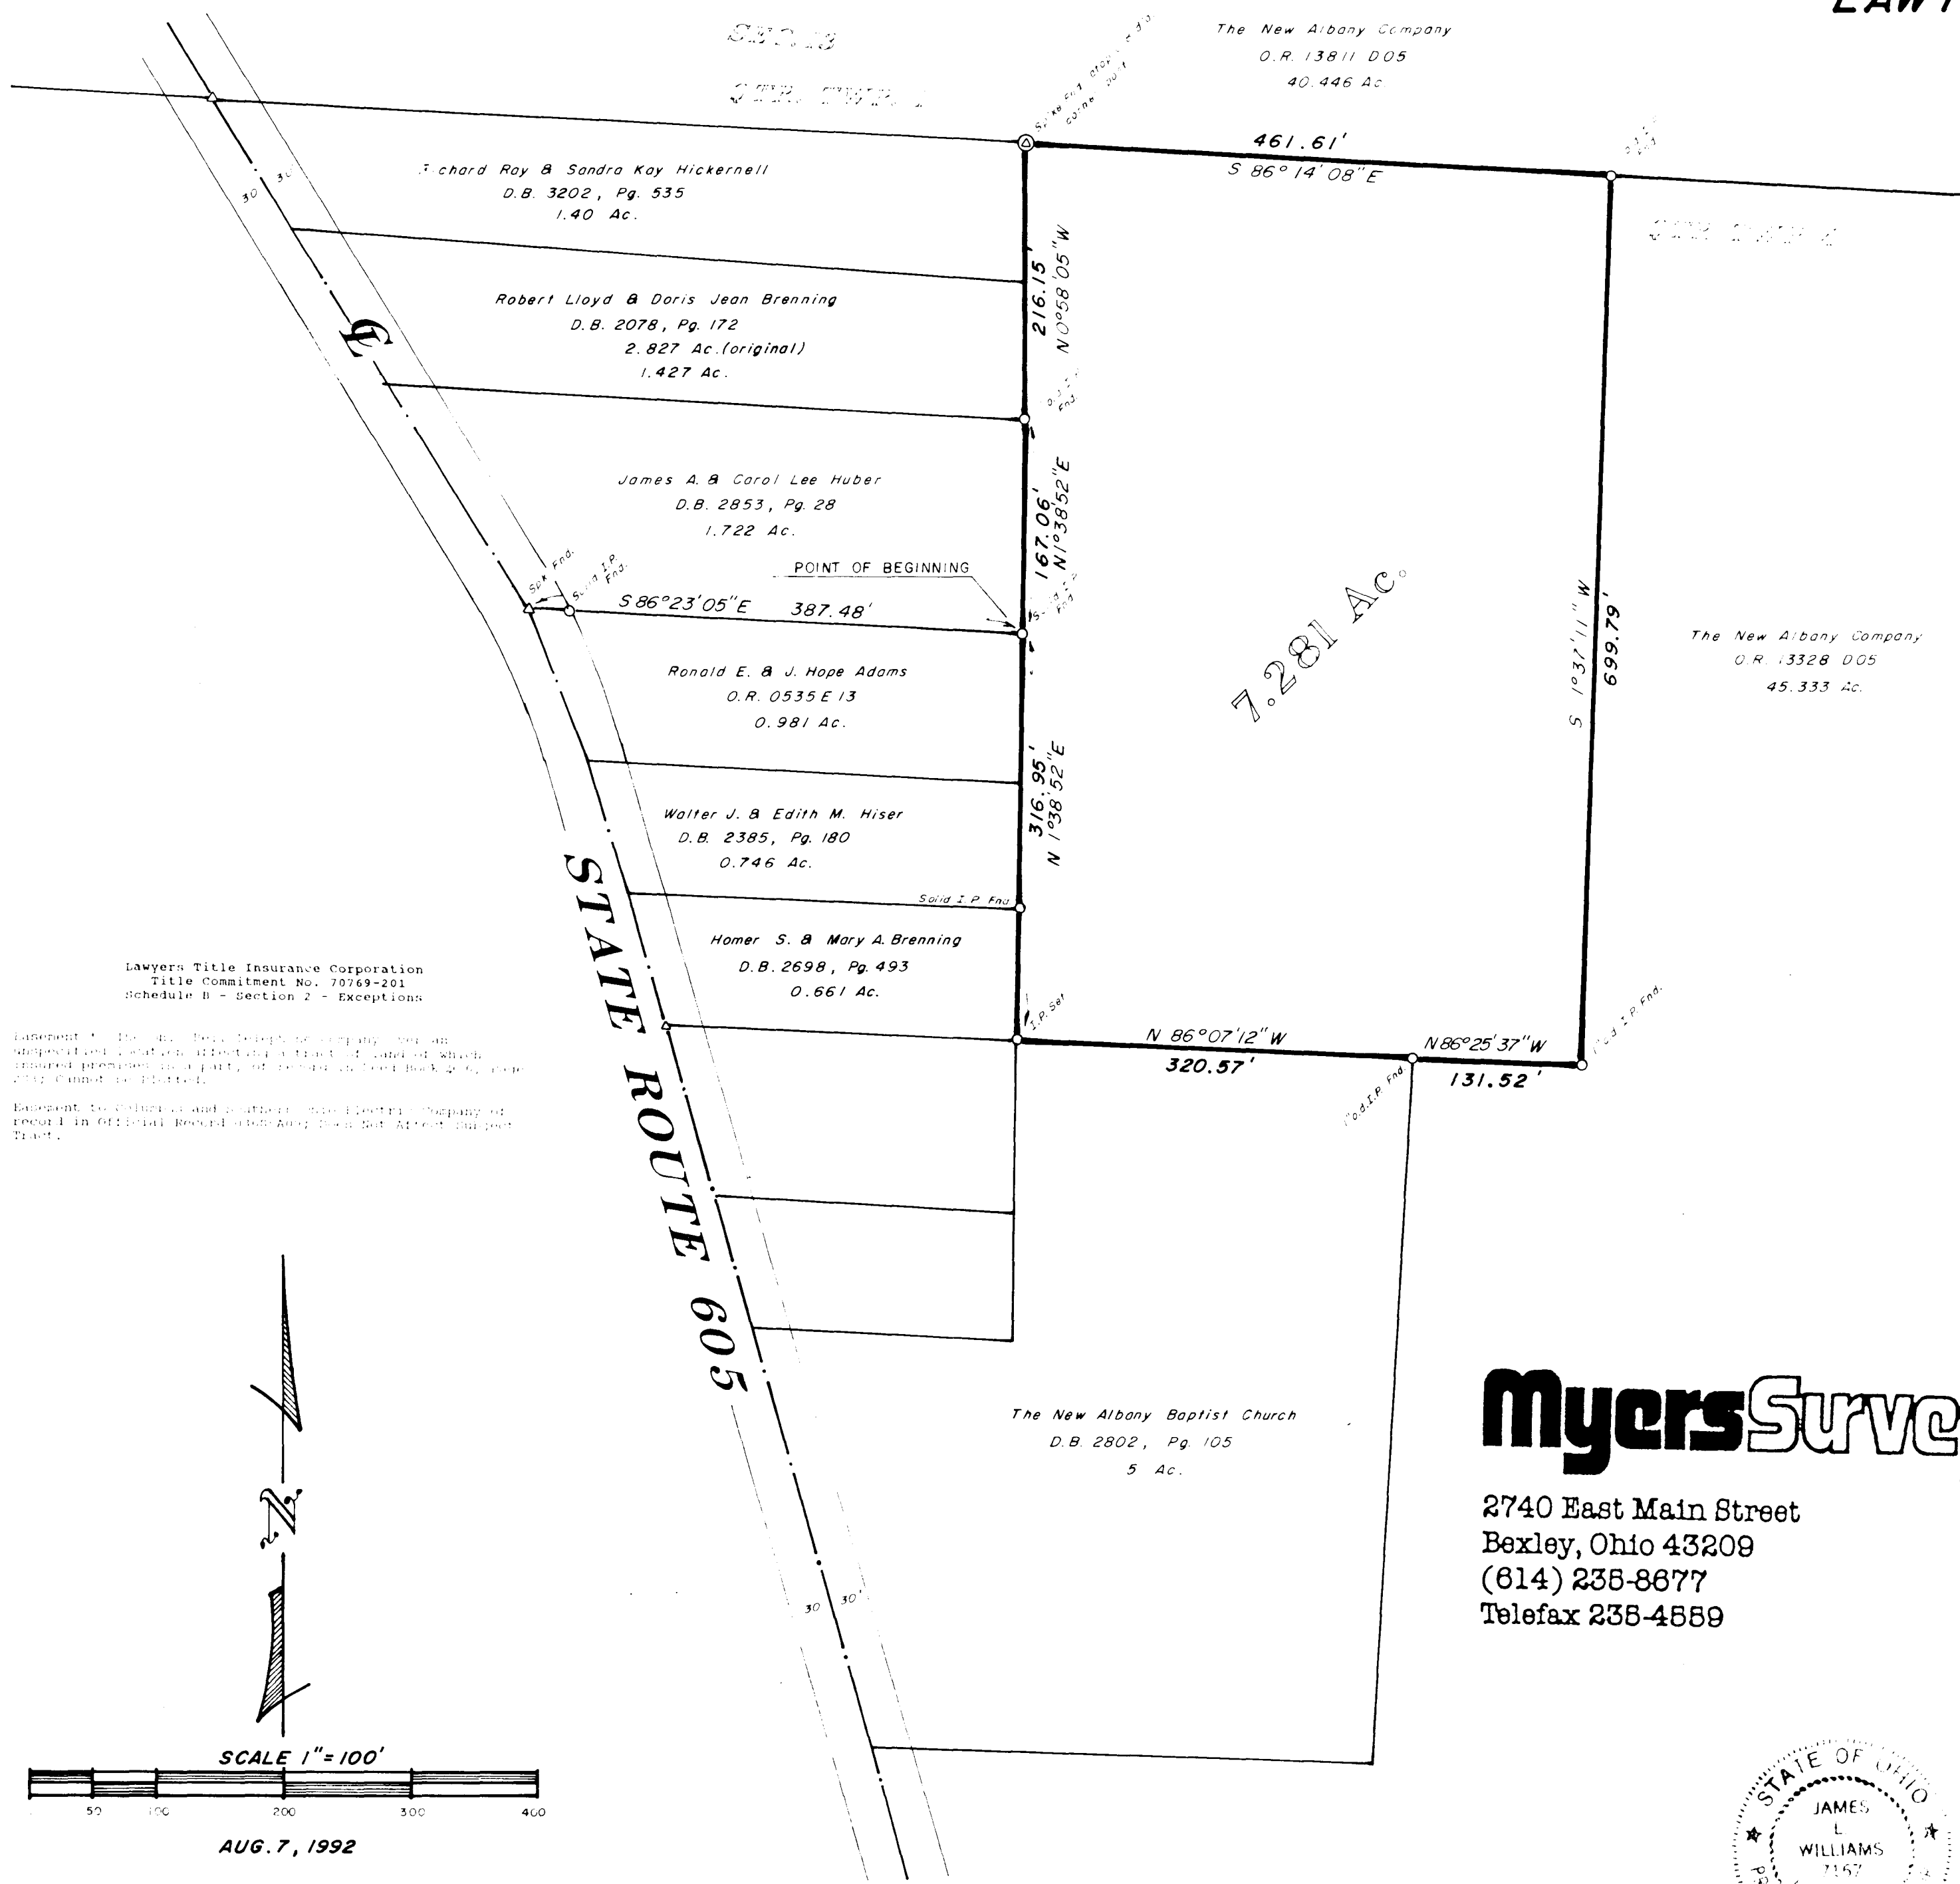















Myers Surveying
COMPANY

2740 East Main Street
Bexley, Ohio 43209

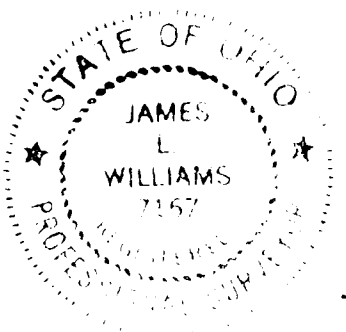

James L. Williams

We do hereby certify that the foregoing plat is a true return of an actual survey of the premises during Aug, 1992 and is correct to the best of our knowledge and belief. Iron pins set are 30"x 1" o.d. with orange plastic caps inscribed, "P.S. 6579". The basis of bearings for the foregoing plat is from coordinates of monuments established by the Franklin County Engineering Dept. using Global Positioning Systems and is based on the Ohio State Plane Coordinate System per NAD 83, south zone.

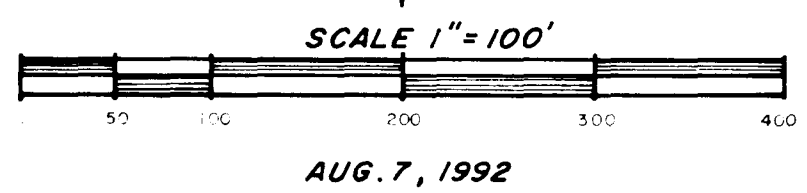

AUG. 7, 1992