SURVEY OF ACREAGE PARCELS

BEING PART OF LOTS 1-6-7 & 8 OF HUSTON HEIGHTS P.B. 25, Pg. 80
AND ALSO PART OF A 22.488 ACRE TRACT BELONGING TO KENNETH HOLTREY
RECORDED IN D.B. 2567, Pg. 557, RECORDERS OFFICE, FRANKLIN COUNTY, OHIO
NORTHWEST QUARTER SECTION 13, TOWNSHIP 2, RANGE 16,
UNITED STATES MILITARY LANDS, PLAIN TOWNSHIP,
FRANKLIN COUNTY, OHIO

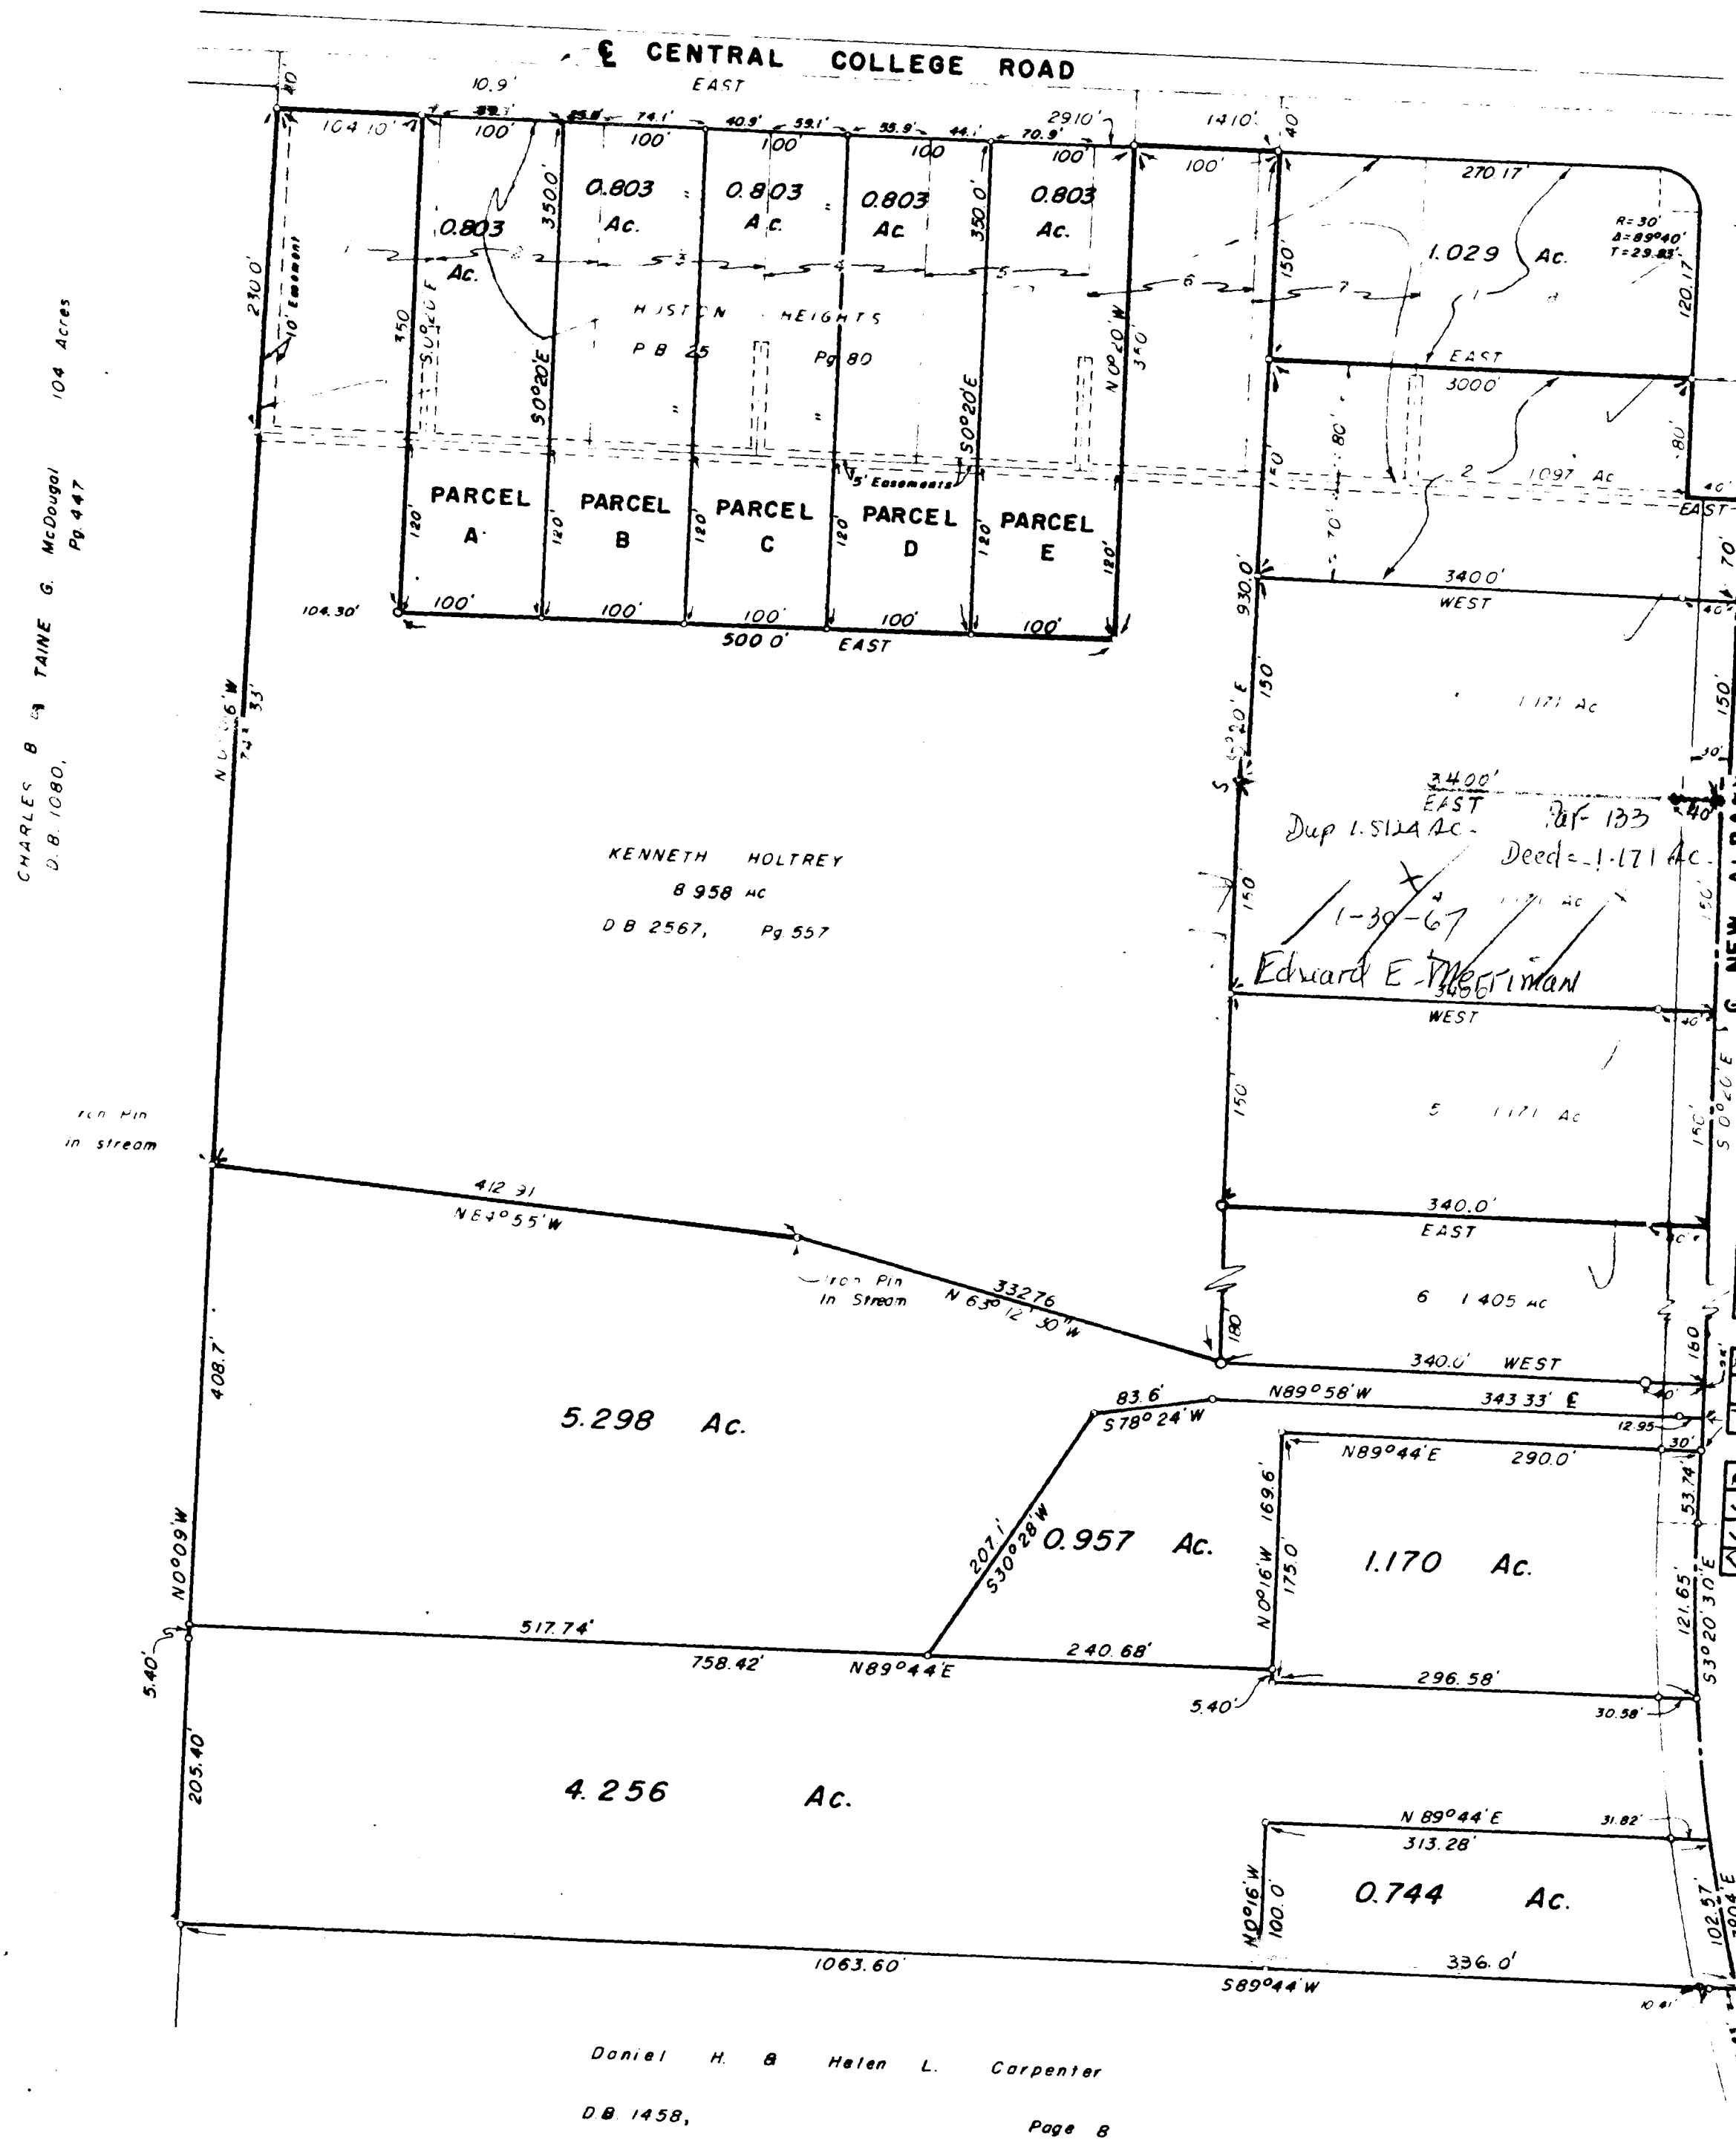

Surveyed & Platted

By

EVANS, MECHWART, HAMBLETON & TILTON, INC.

Consulting Engineers & Surveyors

Gahanna, Ohio

By G. E. Evans
Registered Surveyor No. 483

Scale: 1" = 100'

March 2, 1966