


**PLAT OF 50.661 ACRE TRACT
LOCATED IN
QUARTER SECTIONS 3 & 4, TOWNSHIP 2, RANGE 16
UNITED STATES MILITARY LANDS
PLAIN TOWNSHIP, VILLAGE OF NEW ALBANY
COUNTY OF FRANKLIN, STATE OF OHIO**

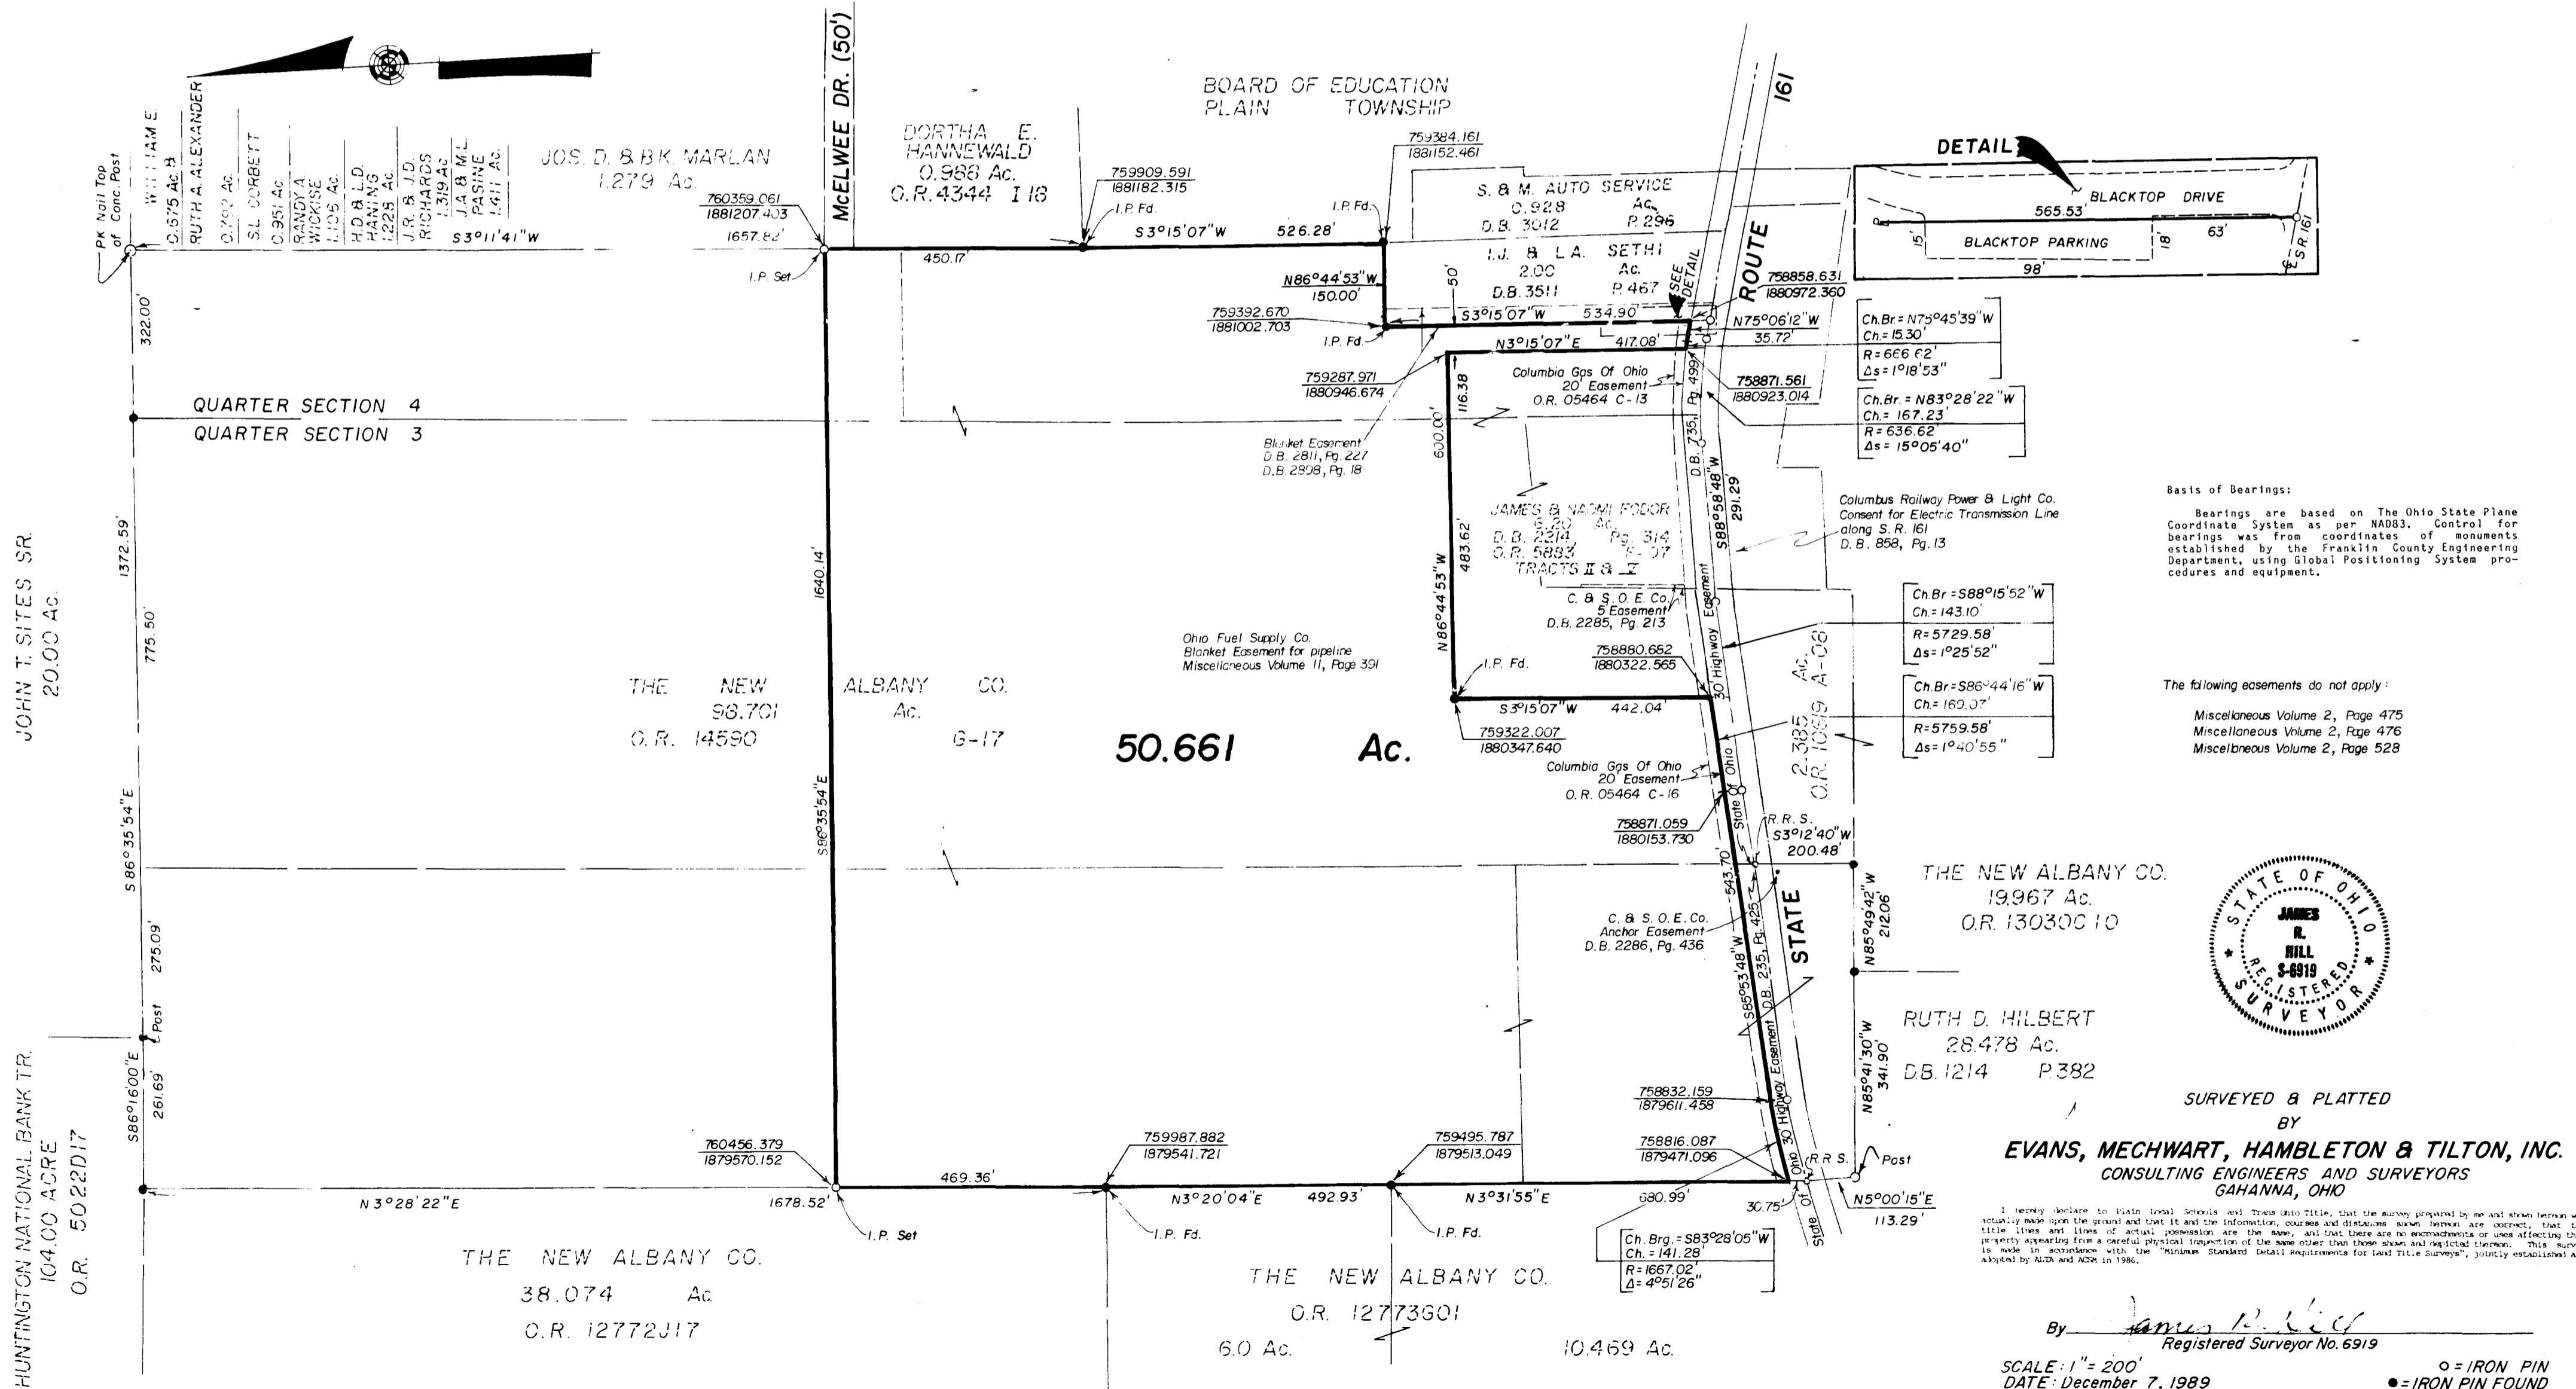

Basis of Bearings:
Bearings are based on The Ohio State Plane Coordinate System as per NA083. Control for bearings was from coordinates of monuments established by the Franklin County Engineering Department, using Global Positioning System procedures and equipment.

The following easements do not apply:
Miscellaneous Volume 2, Page 475
Miscellaneous Volume 2, Page 476
Miscellaneous Volume 2, Page 528



SURVEYED & PLATTED
BY
EVANS, MECHWART, HAMBLETON & TILTON, INC.
CONSULTING ENGINEERS AND SURVEYORS
GAHANNA, OHIO



By James R. Hill
Registered Surveyor No. 6919

SCALE: 1" = 200'
DATE: December 7, 1989

○ = IRON PIN
● = IRON PIN FOUND