

SURVEY OF ACREAGE PARCEL
LOCATED IN SOUTH HALF OF LOT 18, SOUTHEAST QUARTER OF SECTION 9,
QUARTER TOWNSHIP 1, TOWNSHIP 2, RANGE 16
UNITED STATES MILITARY LANDS
VILLAGE OF NEW ALBANY, FRANKLIN COUNTY, OHIO

SUGAR RUN DEVELOPMENT COMPANY, LTD.
 71.512 Ac.
 IN: 199803180062551

SUGAR RUN DEVELOPMENT COMPANY, LTD.
 40.772 Ac.
 IN: 199803090054206

WLBUR L. & BETTY J.
 KINDLER
 6.207 Ac.
 OR 17542118

V. EDWARD &
 BETTY B. DYBERT
 0.736 Ac.
 OR 14905A02

JERRY F. & PAMELA
 HAMPTON
 0.551 Ac.
 OR 33151111

ROBERT J. & MARY
 MADELEINE PETERS
 0.551 Ac.
 DB 2937, PG 19

HAROLD D. & FAYE
 COOPER 0.689 Ac.
 DB 2909, PG 241

JEAN M. KERR
 OR 30741A04




ROBERT C. &
 BEATRICE C. GEIGER
 0.551 Ac.
 DB 3026 PG 419

RODNEY W. & BETTY
 A. EMMONS
 0.551 Ac.
 DB 3187, PG 208

CHARLES & NORMA
 JEAN HOOVER
 0.551 Ac.
 DB 3209, PG 400

16.435 Ac. Tot.
 0.055 Ac. R/W
 16.380 Ac. Net.

PINE GROVE LTD.
 DB 3551 PG. 190
 85 Ac.

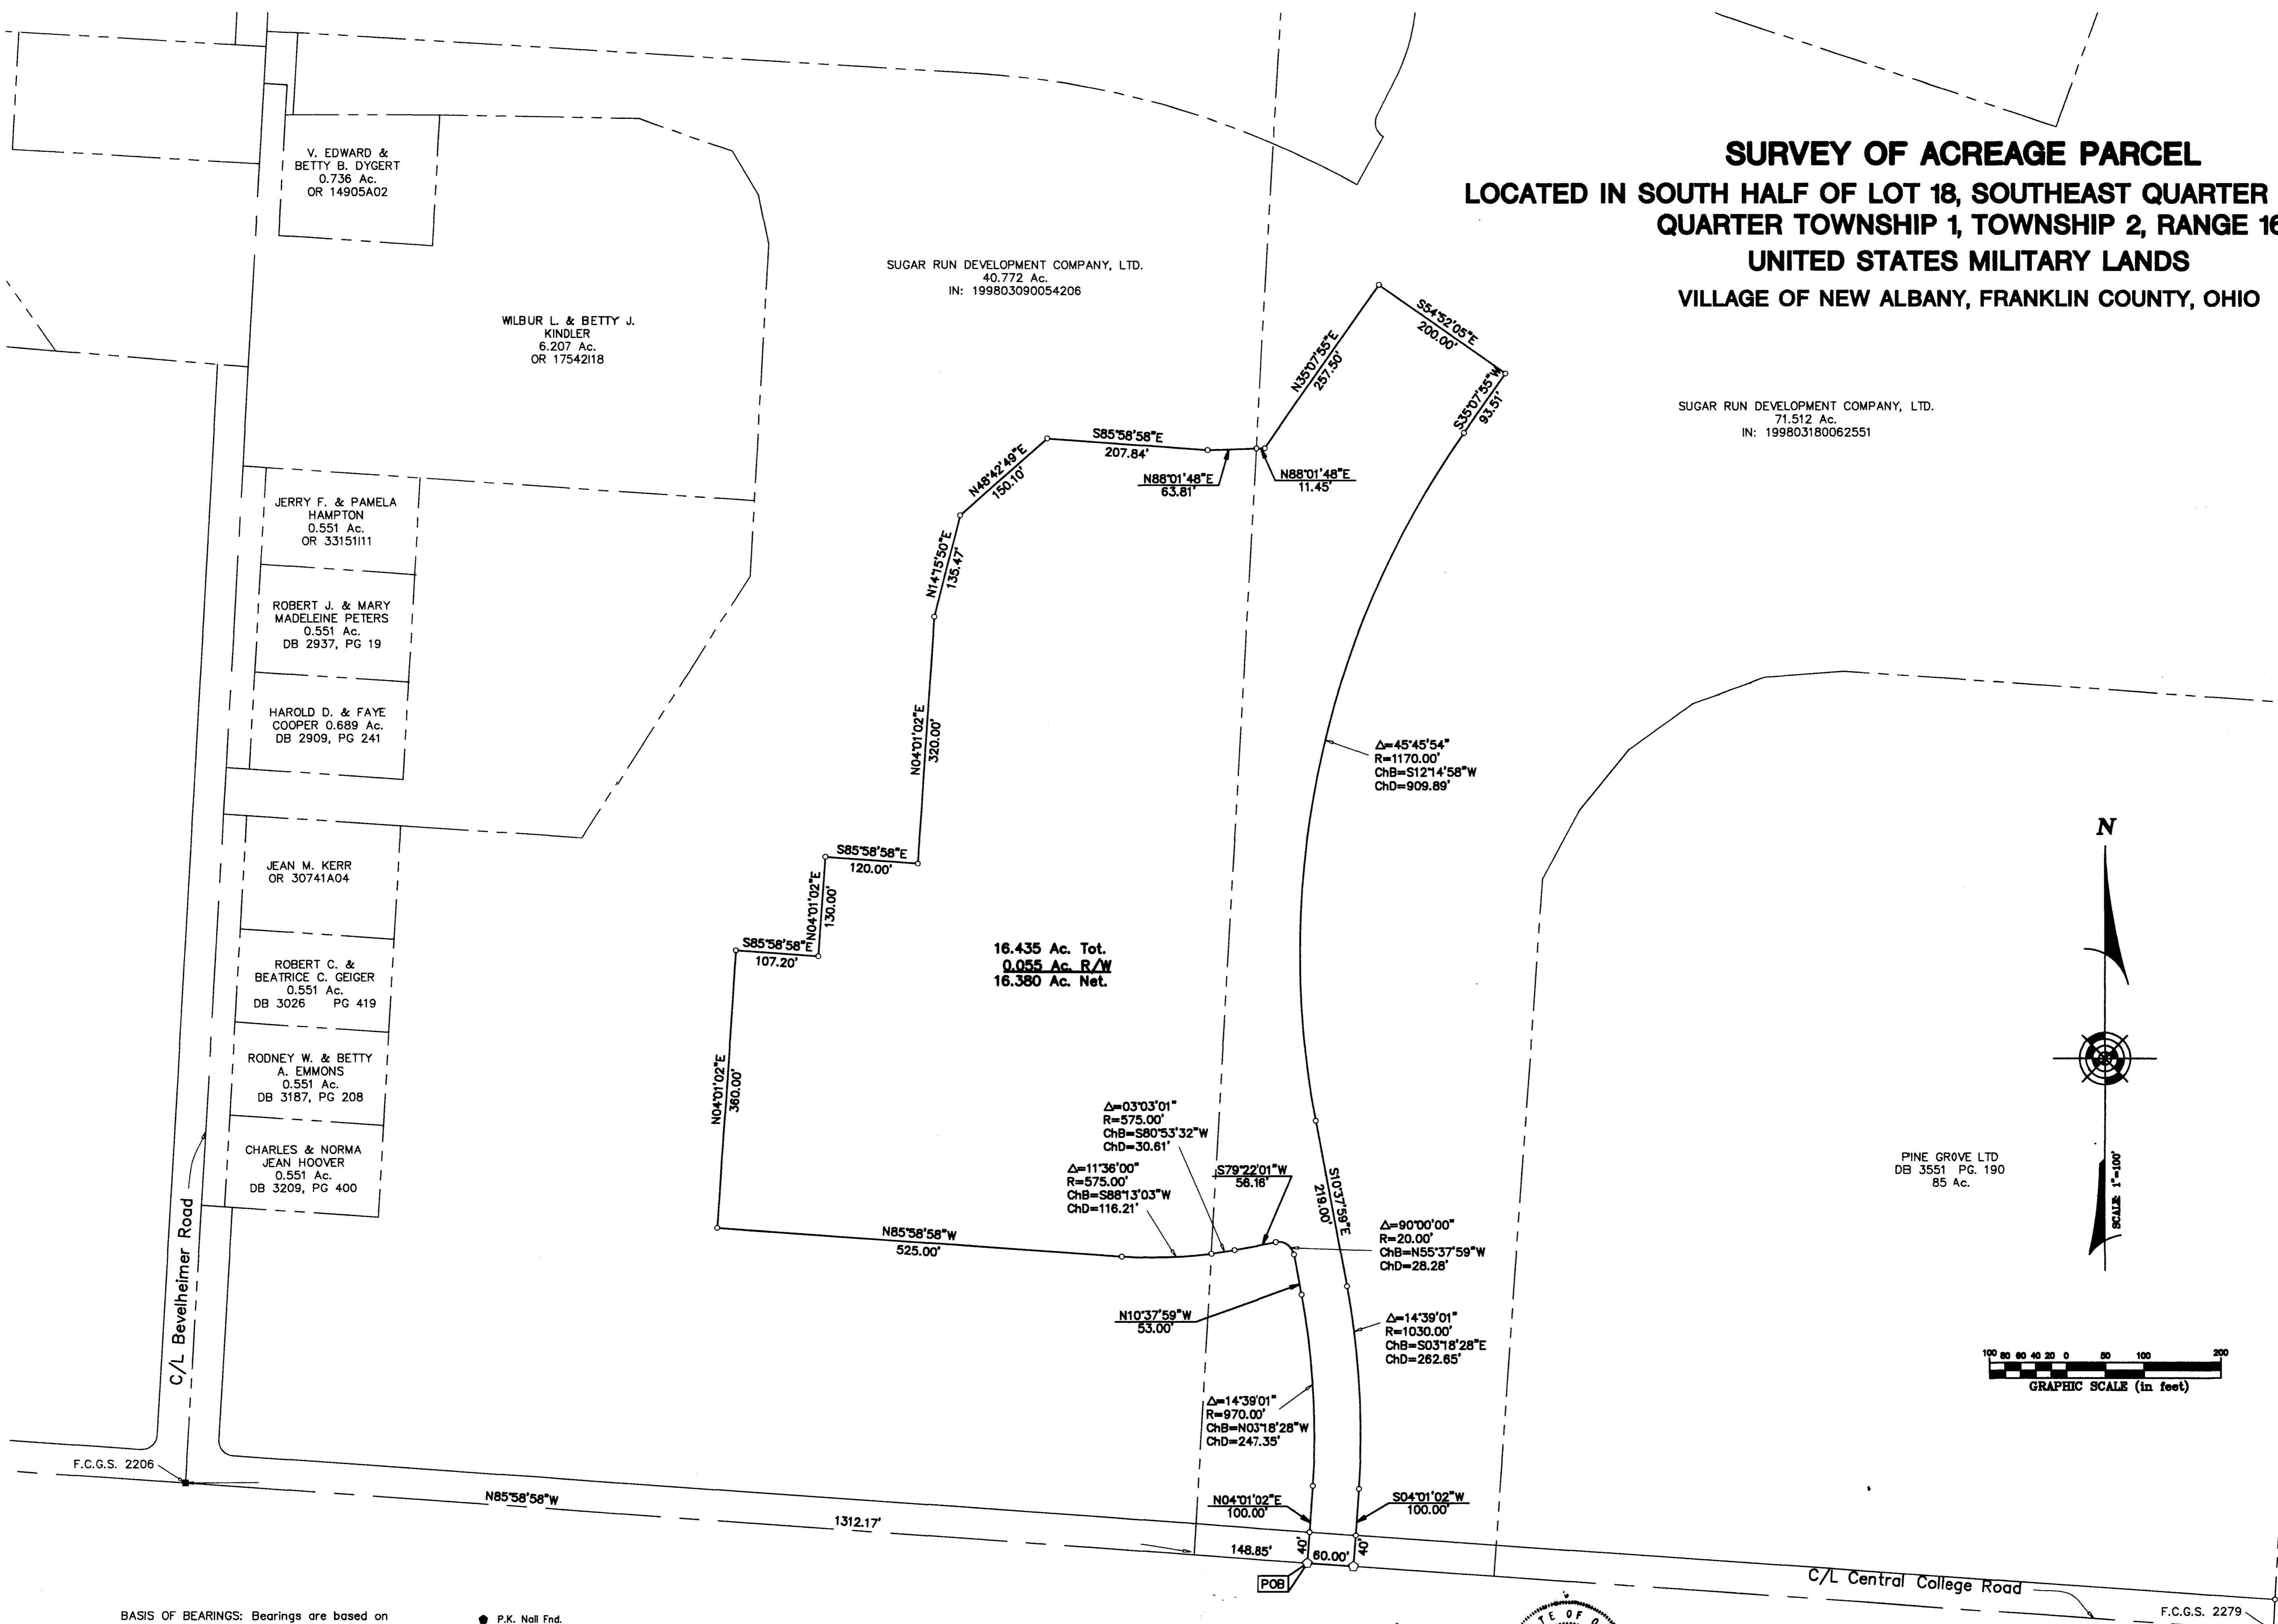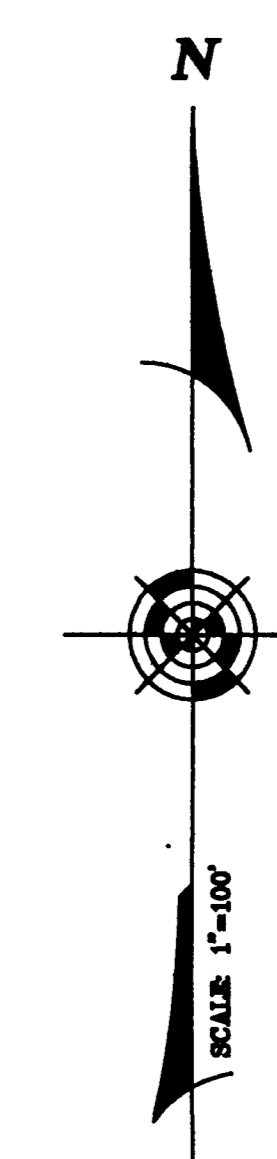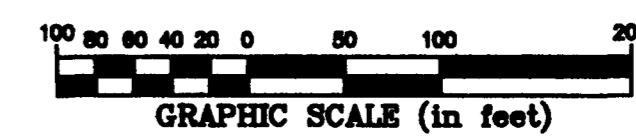

C/L Bevelheimer Road

C/L Central College Road


F.C.G.S. 2206

F.C.G.S. 2279

BASIS OF BEARINGS: Bearings are based on the Ohio State Plane Coordinate System as per NAD83. Control for bearings was from coordinates of monuments numbers, 2206 to 2207 having a bearing of N 3°23'06" E, established by the Franklin County Engineering Department, using Global Positioning System procedures and equipment.

- P.K. Nail Fnd.
 - P.K. Nail Set
 - ▲ R.R. Spk. Fnd.
 - △ R.R. Spk. Set
 - I.P. Fnd.
 - I.P. Set
- I.P. set are 3/4" O.D. Iron Pin
 30" long w/cap inscribed EMH&T.

E.M.H.&T. INC.
James R. Hill
 Professional Surveyor No. 6919
 1998

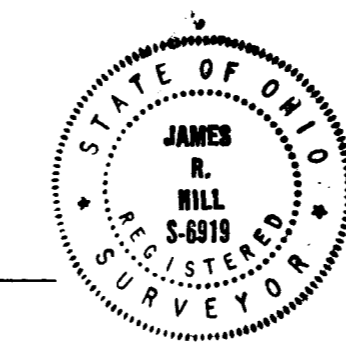

SCALE 1" = 100'

I:\SERIES-4\SURVEY\PROJECT\19971177\DWG\71177R05.DWG - 0 PREPES - PLOTTED BY ALONG - May 05, 1998 - 2:08 PM