



WITNESS TIES

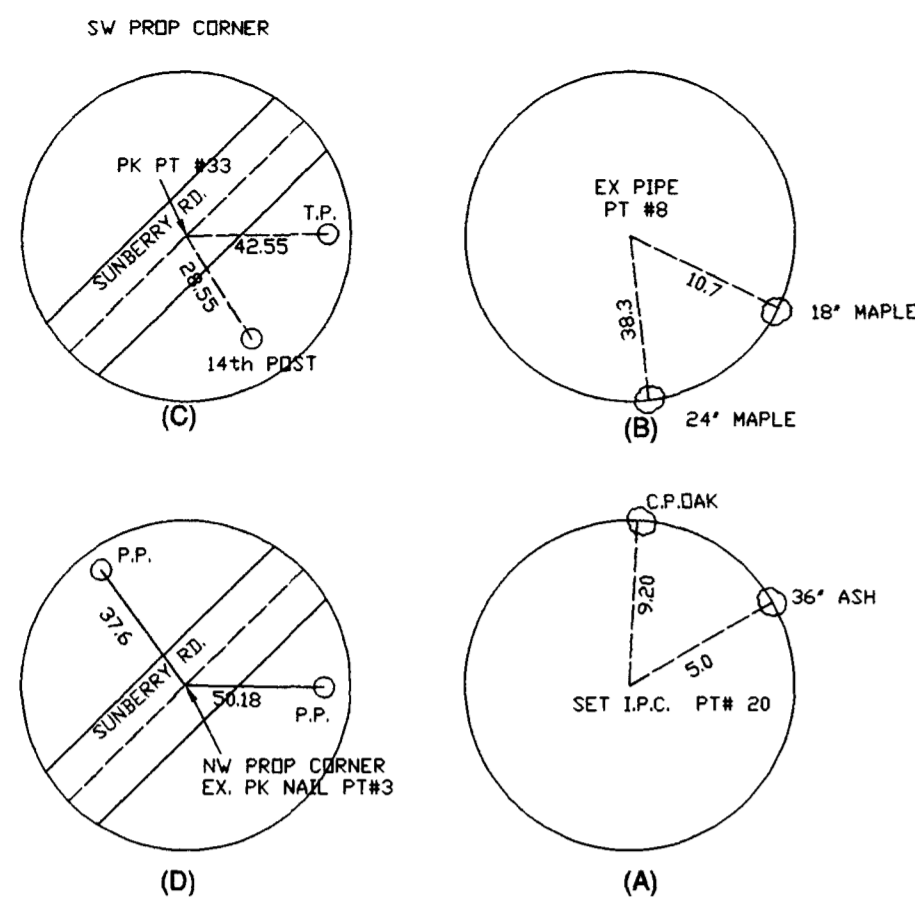

LAND SURVEY


PLAT OF SURVEY MADE FOR:
BONNE McDANNALD
 SHOWING A TRACT OF LAND LYING IN SECTION 4, TOWNSHIP 2,
 RANGE 17, U.S. MILITARY LANDS IN FRANKLIN, CO., OHIO
 SURVEY MADE DURING OCT. AND NOV. 2001

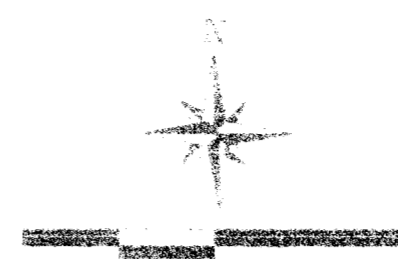

by David E. Slagle 02-20-02
 David E. Slagle P.S. #7408



- LEGEND:
 ○ I.P. FOUND
 △ PK FOUND
 ▲ PK SET

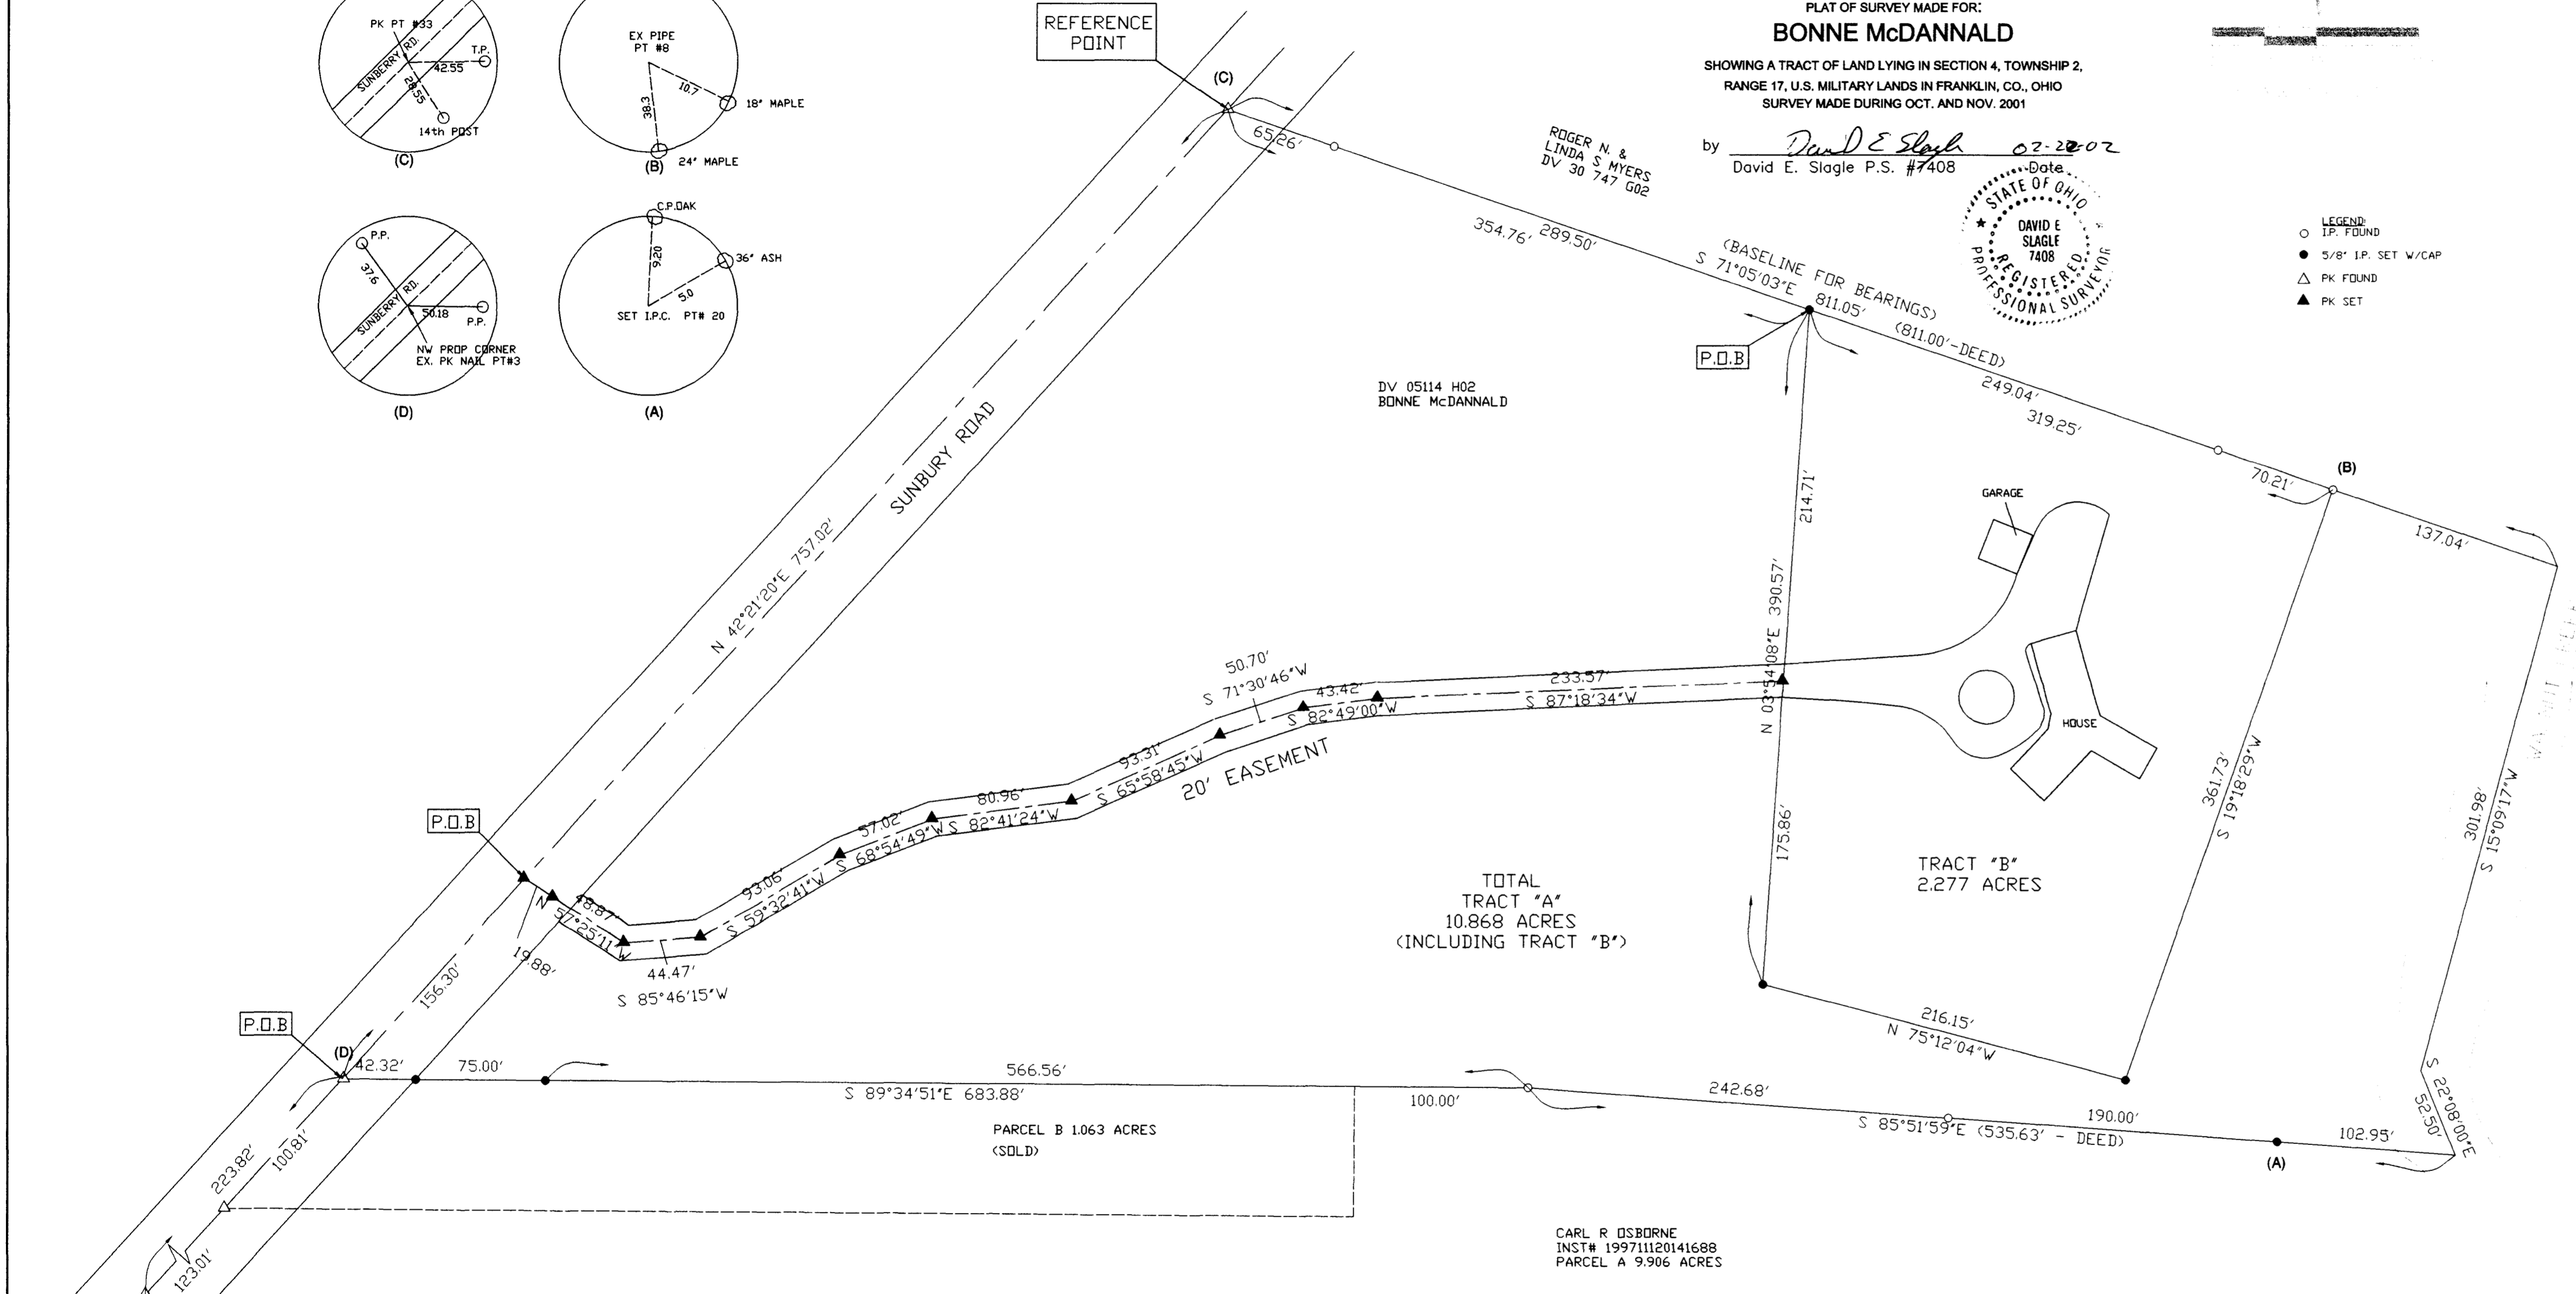

0.975 ACRES
 CHARLES E. SMITH
 D.V. 02100 DED

CARL R OSBORNE
 INST# 199711120141688
 PARCEL A 9.906 ACRES

MADE FOR:	BONNE McDANNALD
DATE:	11/12/2001
SCALE:	1" = 60'
REVISION:	2/22/2002
SURVEY SERVICE INC. 3011 COLUMBUS ST. #202 GROVE CITY OH 43123 FAX: 614-875-7862 PH: 614-539-9220	
JOB#	21-159
F.B.#	115
MAP#	21-159
DRAWN BY:	M.P.G.
CHECKED BY:	D.E.S.
CAD FILE	21-159