

SURVEY OF 23.6362 ACRES FOR RIDENOUR ROAD DEVELOPMENT CO.

LEGEND


POINT SYMBOLS

- INDICATES FOUND IRON PIN
- INDICATES SET IRON PIN
- △ INDICATES FOUND SPIKE
- ▲ INDICATES SET PONY SPIKE

LINE SYMBOLS

- CENTERLINE
- - - RIGHT-OF-WAY
- ADJOINER

SCALE: 1"=100'

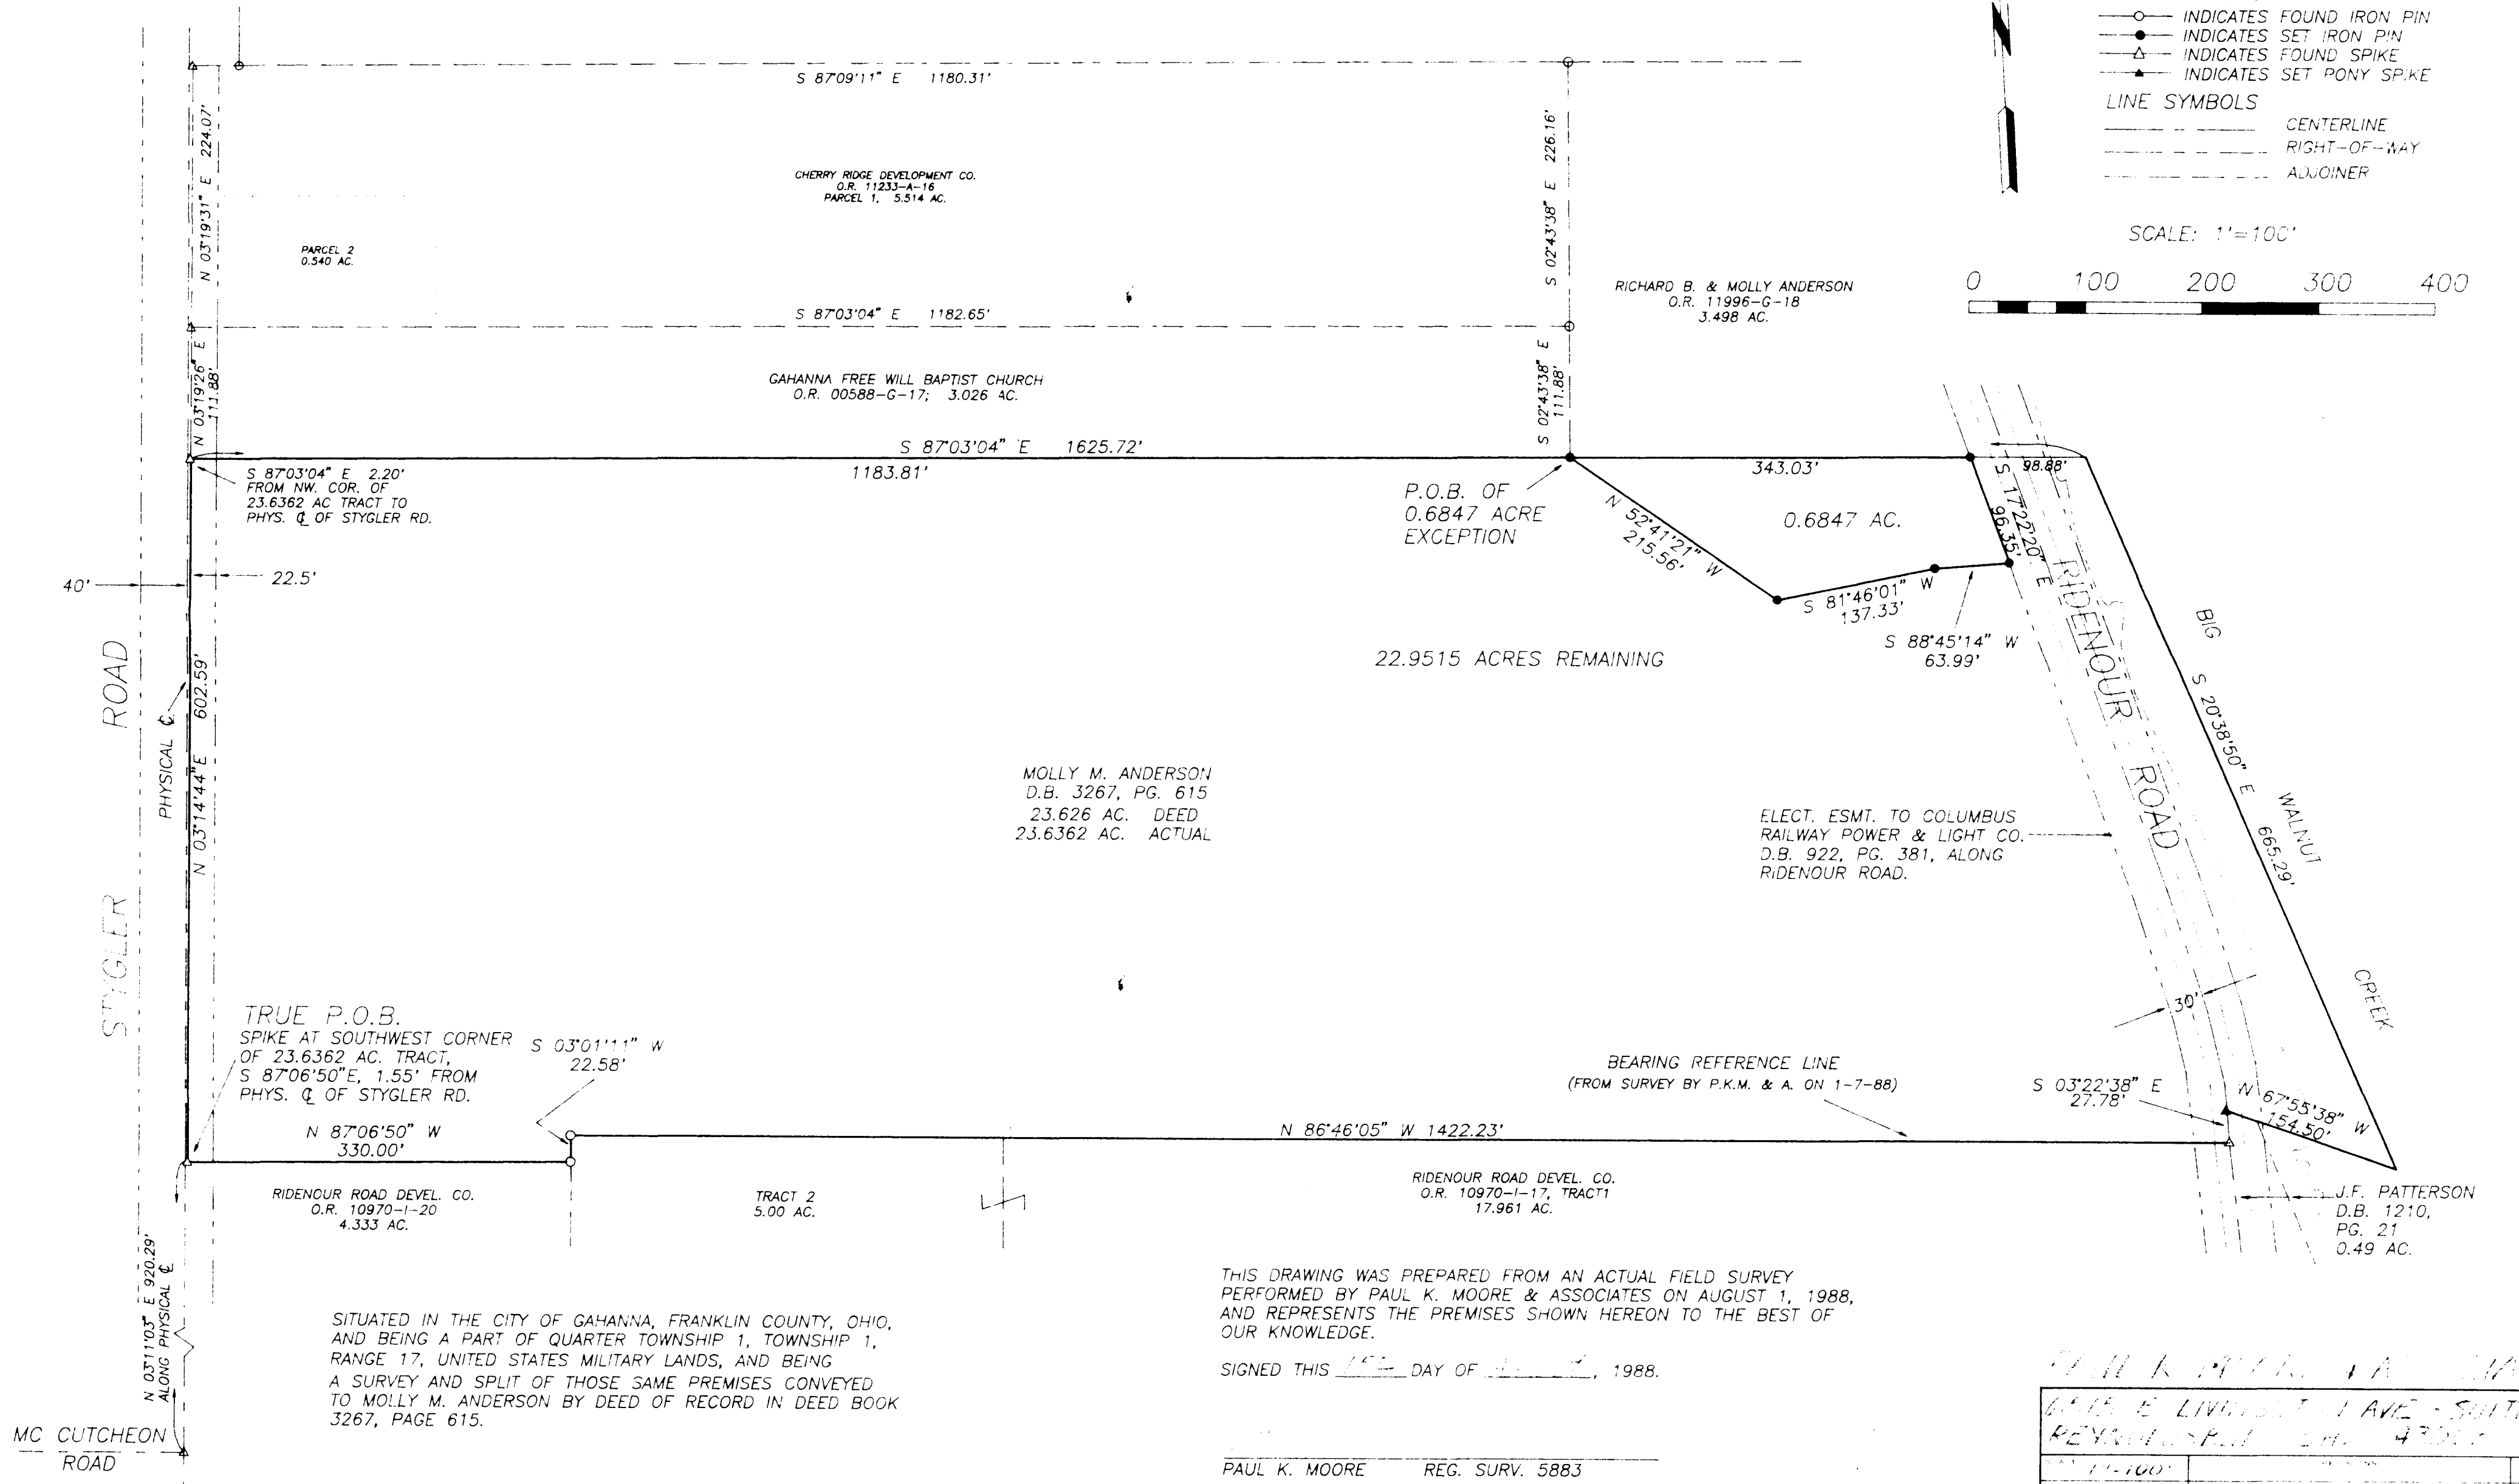

SITUATED IN THE CITY OF GAHANNA, FRANKLIN COUNTY, OHIO, AND BEING A PART OF QUARTER TOWNSHIP 1, TOWNSHIP 1, RANGE 17, UNITED STATES MILITARY LANDS, AND BEING A SURVEY AND SPLIT OF THOSE SAME PREMISES CONVEYED TO MOLLY M. ANDERSON BY DEED OF RECORD IN DEED BOOK 3267, PAGE 615.

THIS DRAWING WAS PREPARED FROM AN ACTUAL FIELD SURVEY PERFORMED BY PAUL K. MOORE & ASSOCIATES ON AUGUST 1, 1988, AND REPRESENTS THE PREMISES SHOWN HEREON TO THE BEST OF OUR KNOWLEDGE.

SIGNED THIS 1st DAY OF August, 1988.

PAUL K. MOORE REG. SURV. 5883

PAUL K. MOORE & ASSOCIATES
 6115 E. LIVINGSTON AVE. - SUITE 111

DATE	11-100	BY	DATE
REV	R-15-08		
REV	1/2	FROM	
REV			
TITLE	SURVEY OF 23.6362 AC. FOR RIDENOUR RD. DEVEL. CO.		NO. 8710-74-1