P
Auditors Survey Book 2 - Page 139

117 NOW 4297

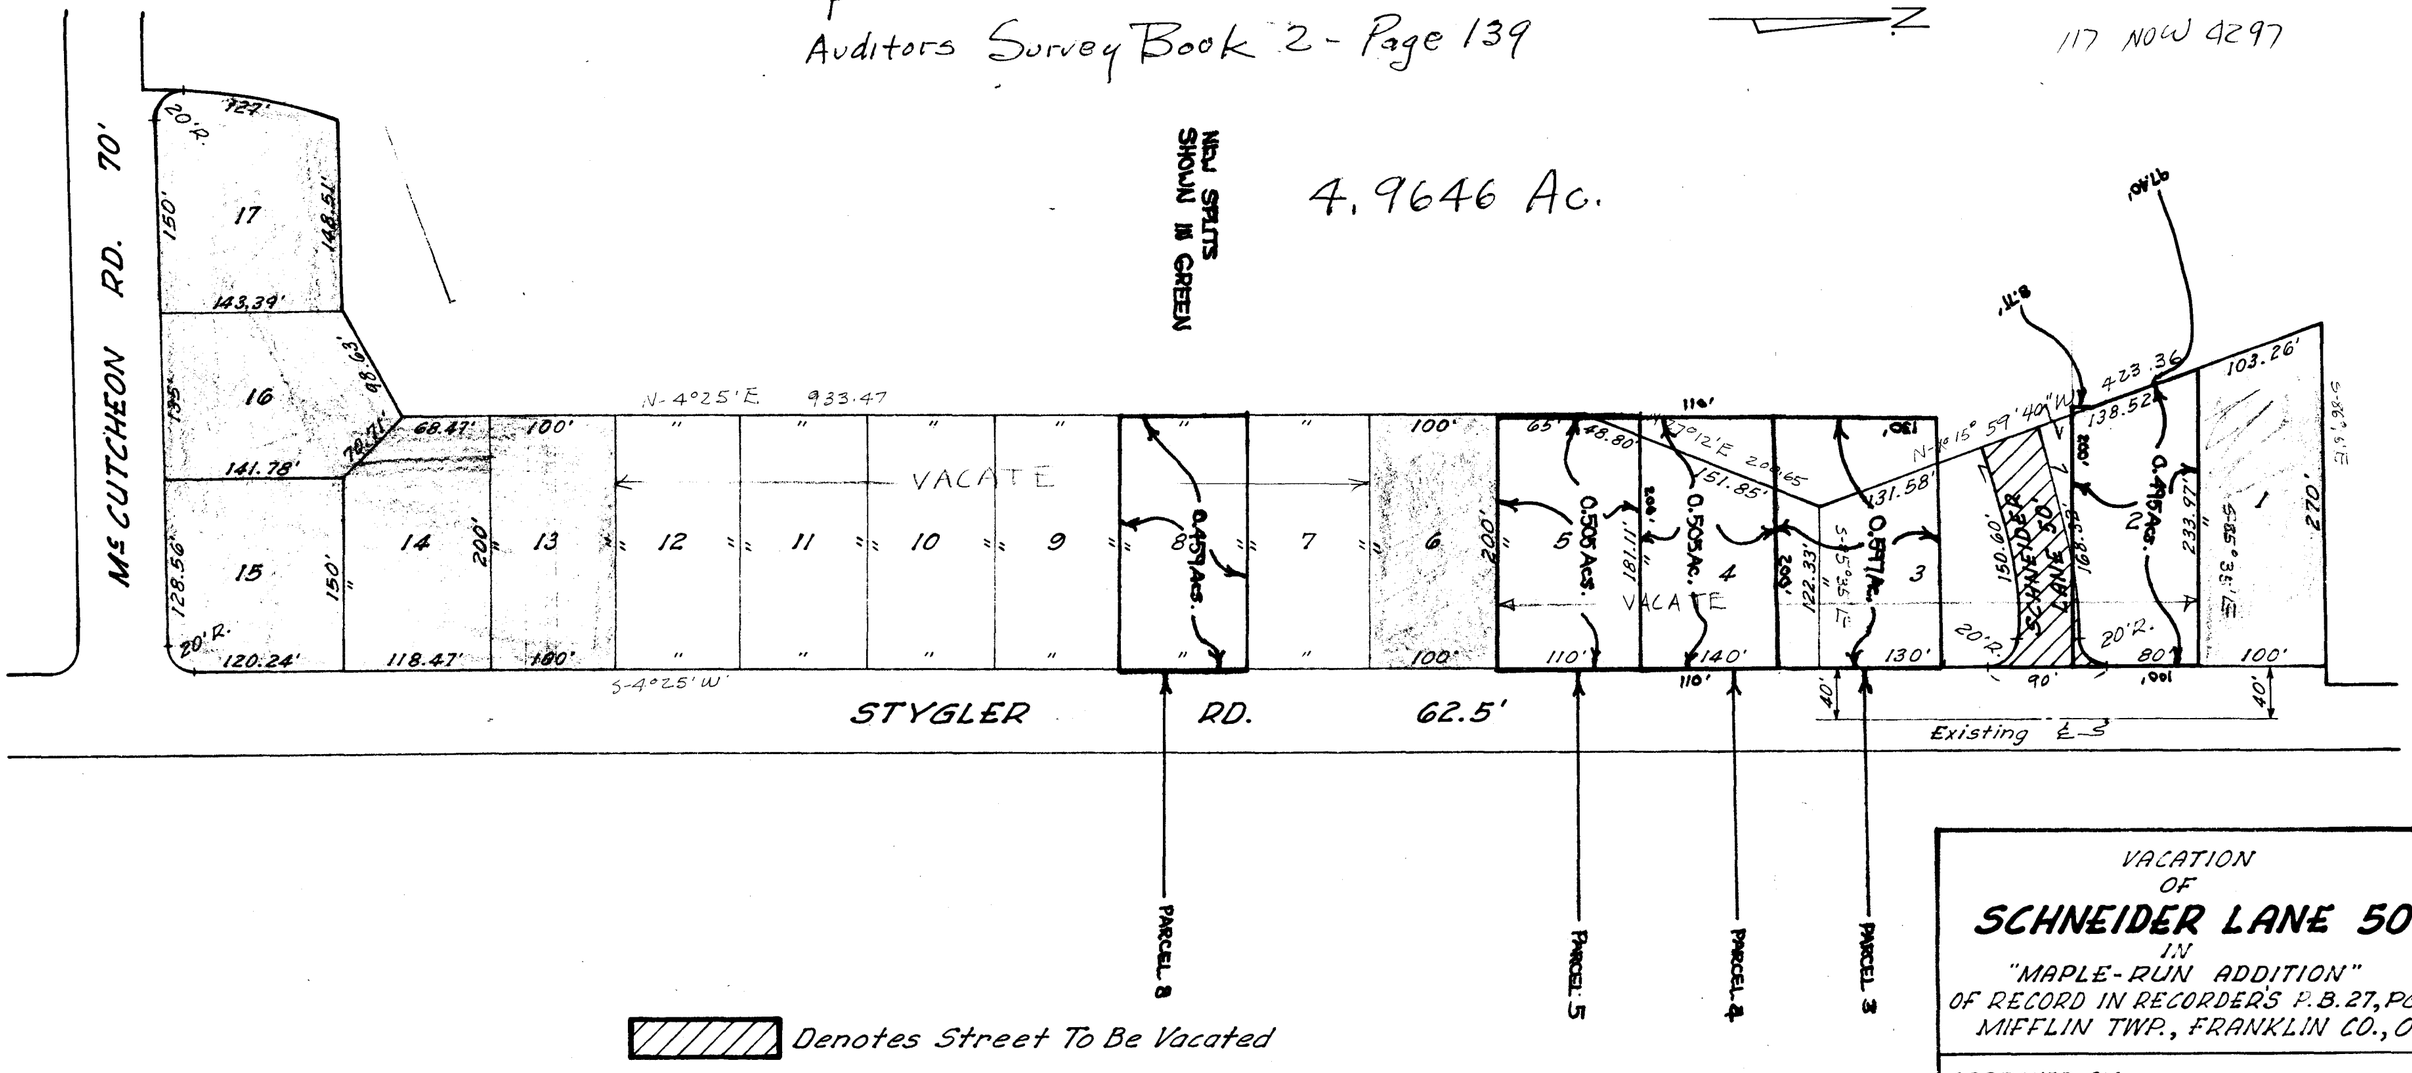

VACATION
OF
SCHNEIDER LANE 50'
IN
"MAPLE-RUN ADDITION"
OF RECORD IN RECORDER'S P.B. 27, PG. 81
MIFFLIN TWP., FRANKLIN CO., O.

APPROVED BY: _____
FRANKLIN COUNTY ENGINEER

DATE ___ ___ ___
SCALE 1"=100'