


AGLER ROAD

**SURVEY OF ACREAGE PARCEL**  
 LOCATED IN QUARTER TOWNSHIP 3, TOWNSHIP 1, RANGE 17,  
 UNITED STATES MILITARY LANDS  
 CITY OF COLUMBUS, FRANKLIN COUNTY, OHIO

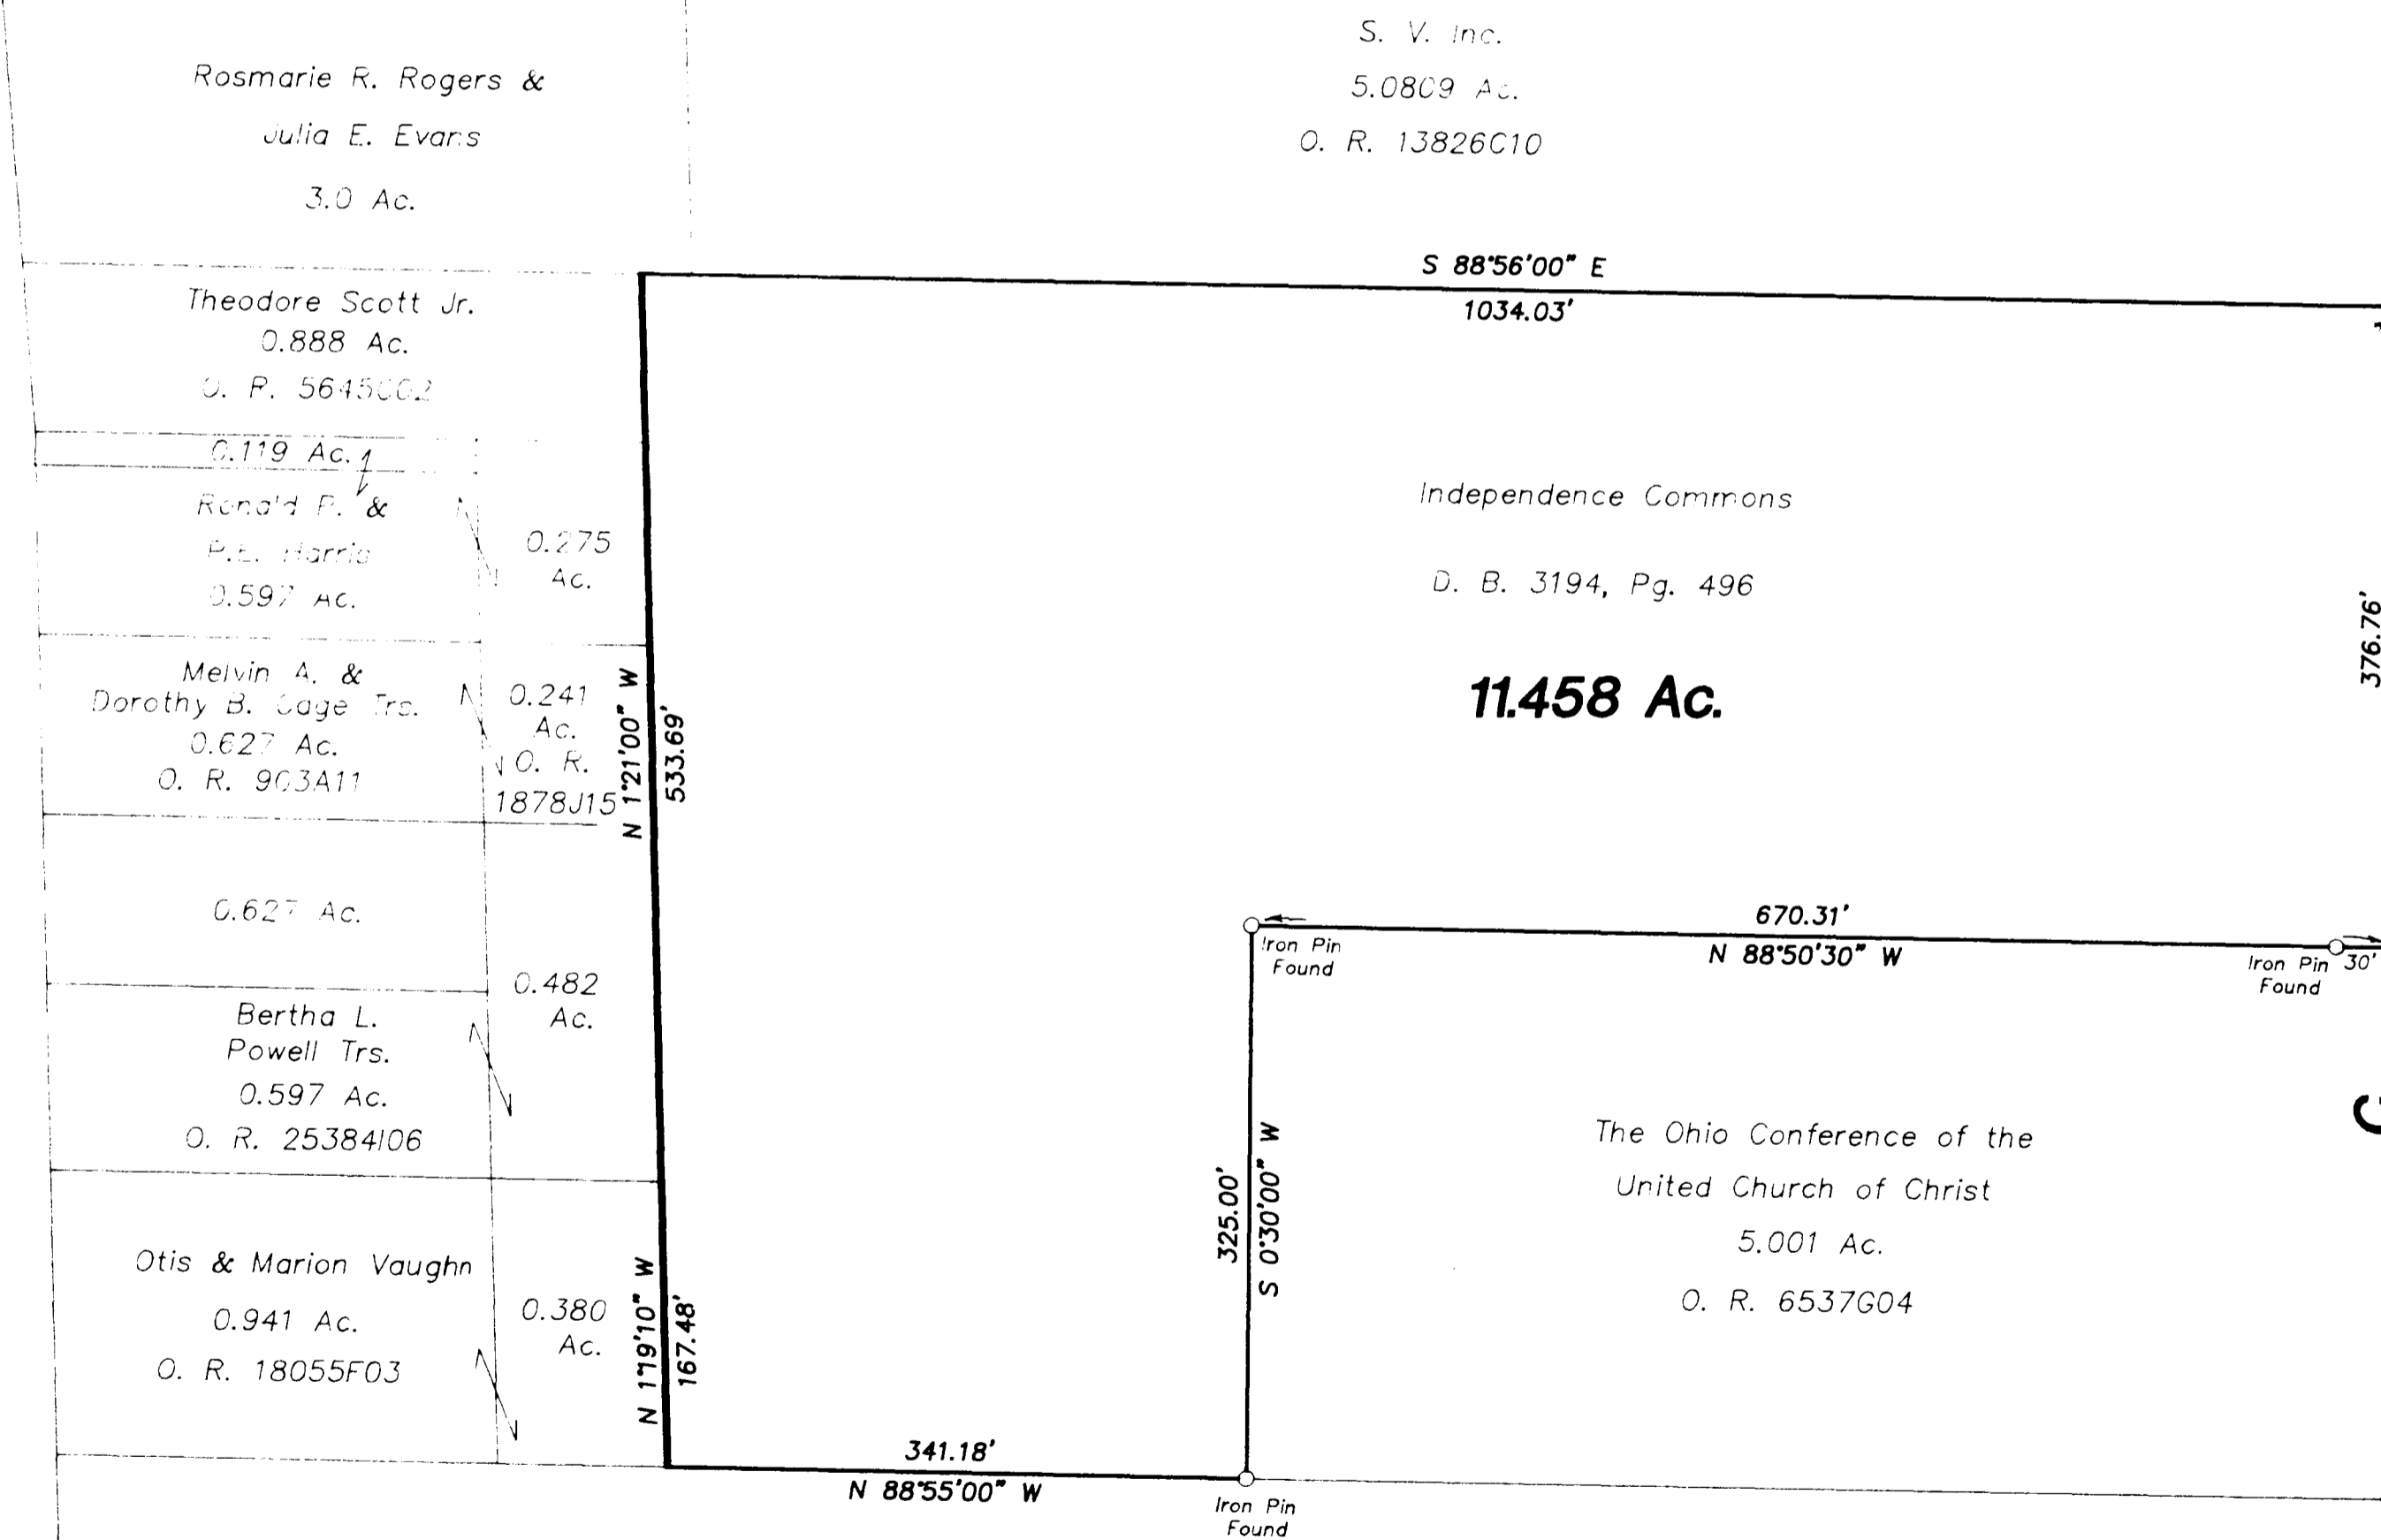

R. R. Spike Found

CASSADY AVENUE

Iron Pin Found

Iron Pin Found

Richard D. & Delois Perry  
 23.807 Ac.  
 O. R. 14175H13

S. V. Inc.  
 5.0809 Ac.  
 O. R. 13826C10

Independence Commons  
 D. B. 3194, Pg. 496

11.458 Ac.


The Ohio Conference of the  
 United Church of Christ  
 5.001 Ac.  
 O. R. 6537G04

NORTH

Surveyed & Plotted  
 By  
**EVANS, MECHWART, HAMBLETON, & TILTON INC.**  
 CONSULTING ENGINEERS AND SURVEYORS  
 170 MILL STREET  
 GAHANNA, OHIO 43230  
 614/471-5150

By *Thomas D. Sibbalds*  
 Thomas D. Sibbalds  
 Registered Surveyor No. 5908

SCALE 1" = 100' AUGUST 12, 1994

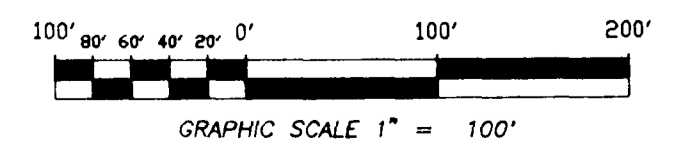

NOTE:

The bearings shown hereon are based on the same meridian as the centerline of Cassidy Avenue ( S 0° 30' 00" W ) of record in Deed Book 3194, Page 496.