

SURVEY OF 3.525 ACRE TRACT

Located in Section 3, Township 1, Range 17

United States Military Lands

Mifflin Township, Franklin County, Ohio

Surveyed & Platted

By

EVANS, MECHWART, HAMBLETON & TILTON, INC.

Consulting Engineers & Surveyors


Gahanna, Ohio

By W. H. Mechwart
Registered Surveyor No. 4072

Scale: 1"=100'

December 13, 1968

o = Iron Pin

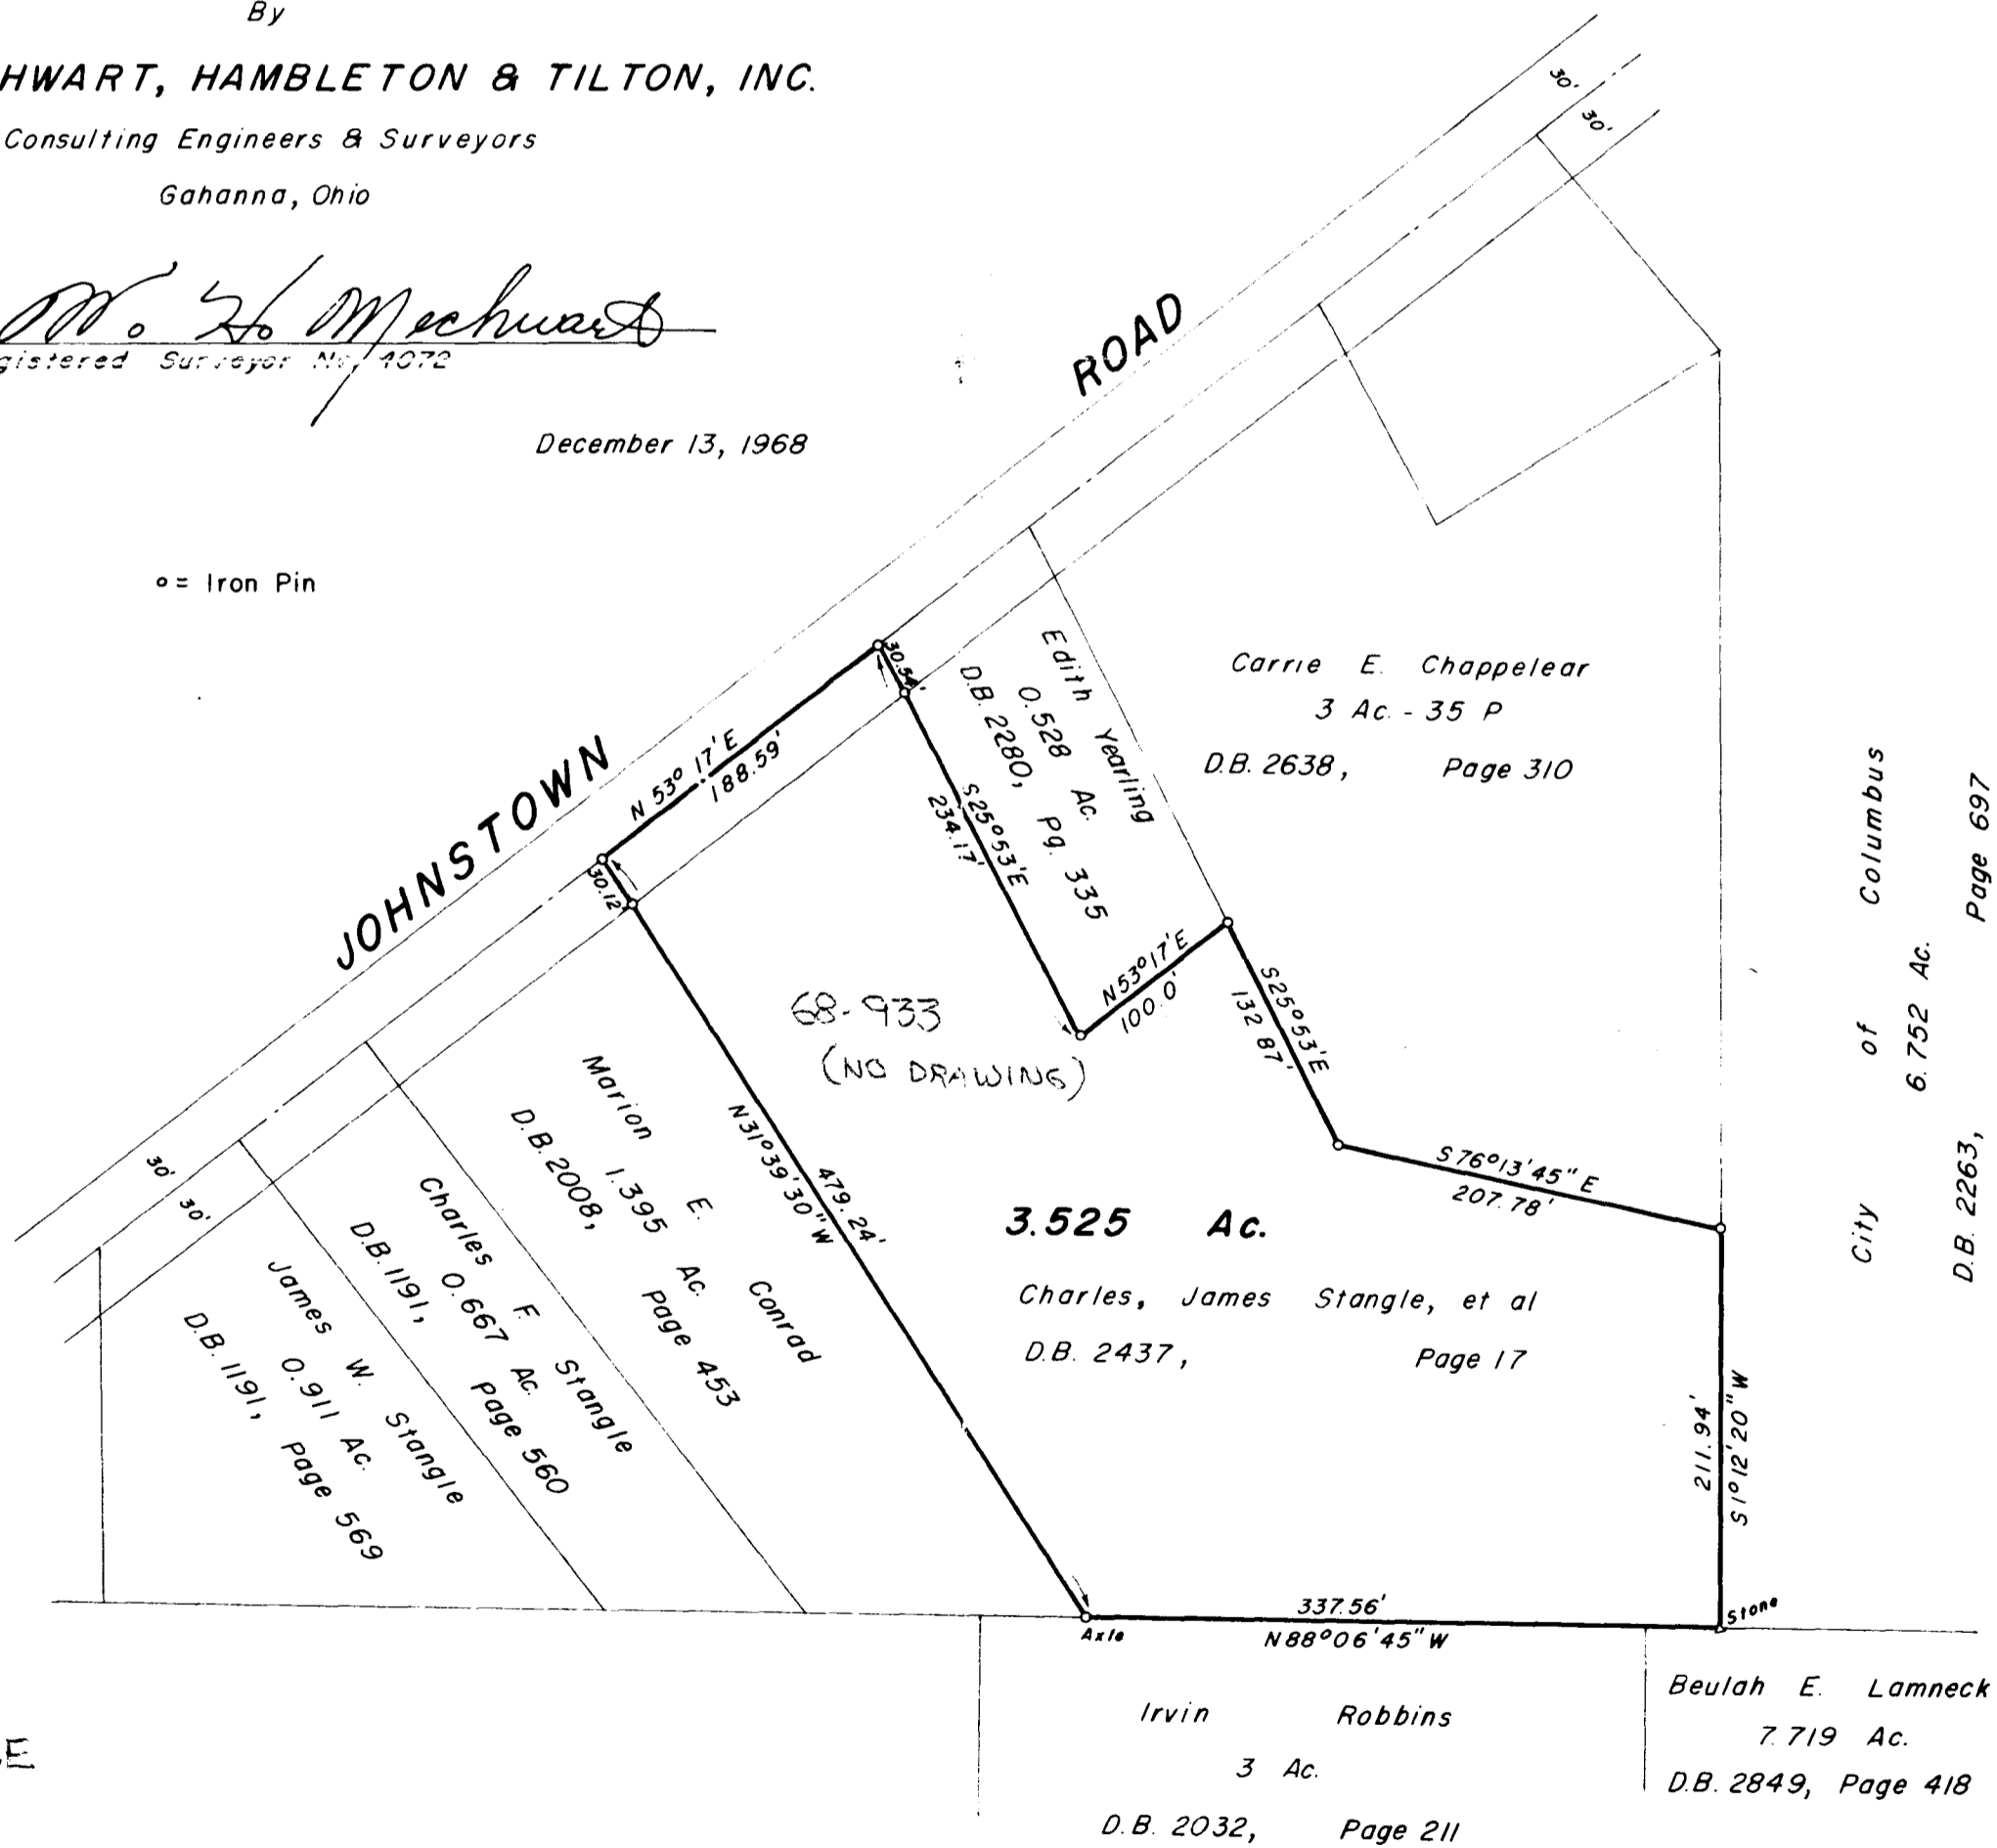

(NEW SURVEY)
LETTER WRITTEN
CHANGING ACREAGE
R.T.M. 12-20-68

NO DRAWING

2510 120 021 053 5 10 11 12 

0-28