



**SURVEY OF LOTS 12 1/2, 13, 14 AND PART OF 12
OF THE TOWN PLAT OF GAHANNA**
Located In Quarter Township 1, Township 1, Range 17,

United States Military Lands
City Of Gahanna, Franklin County, Ohio

N 39

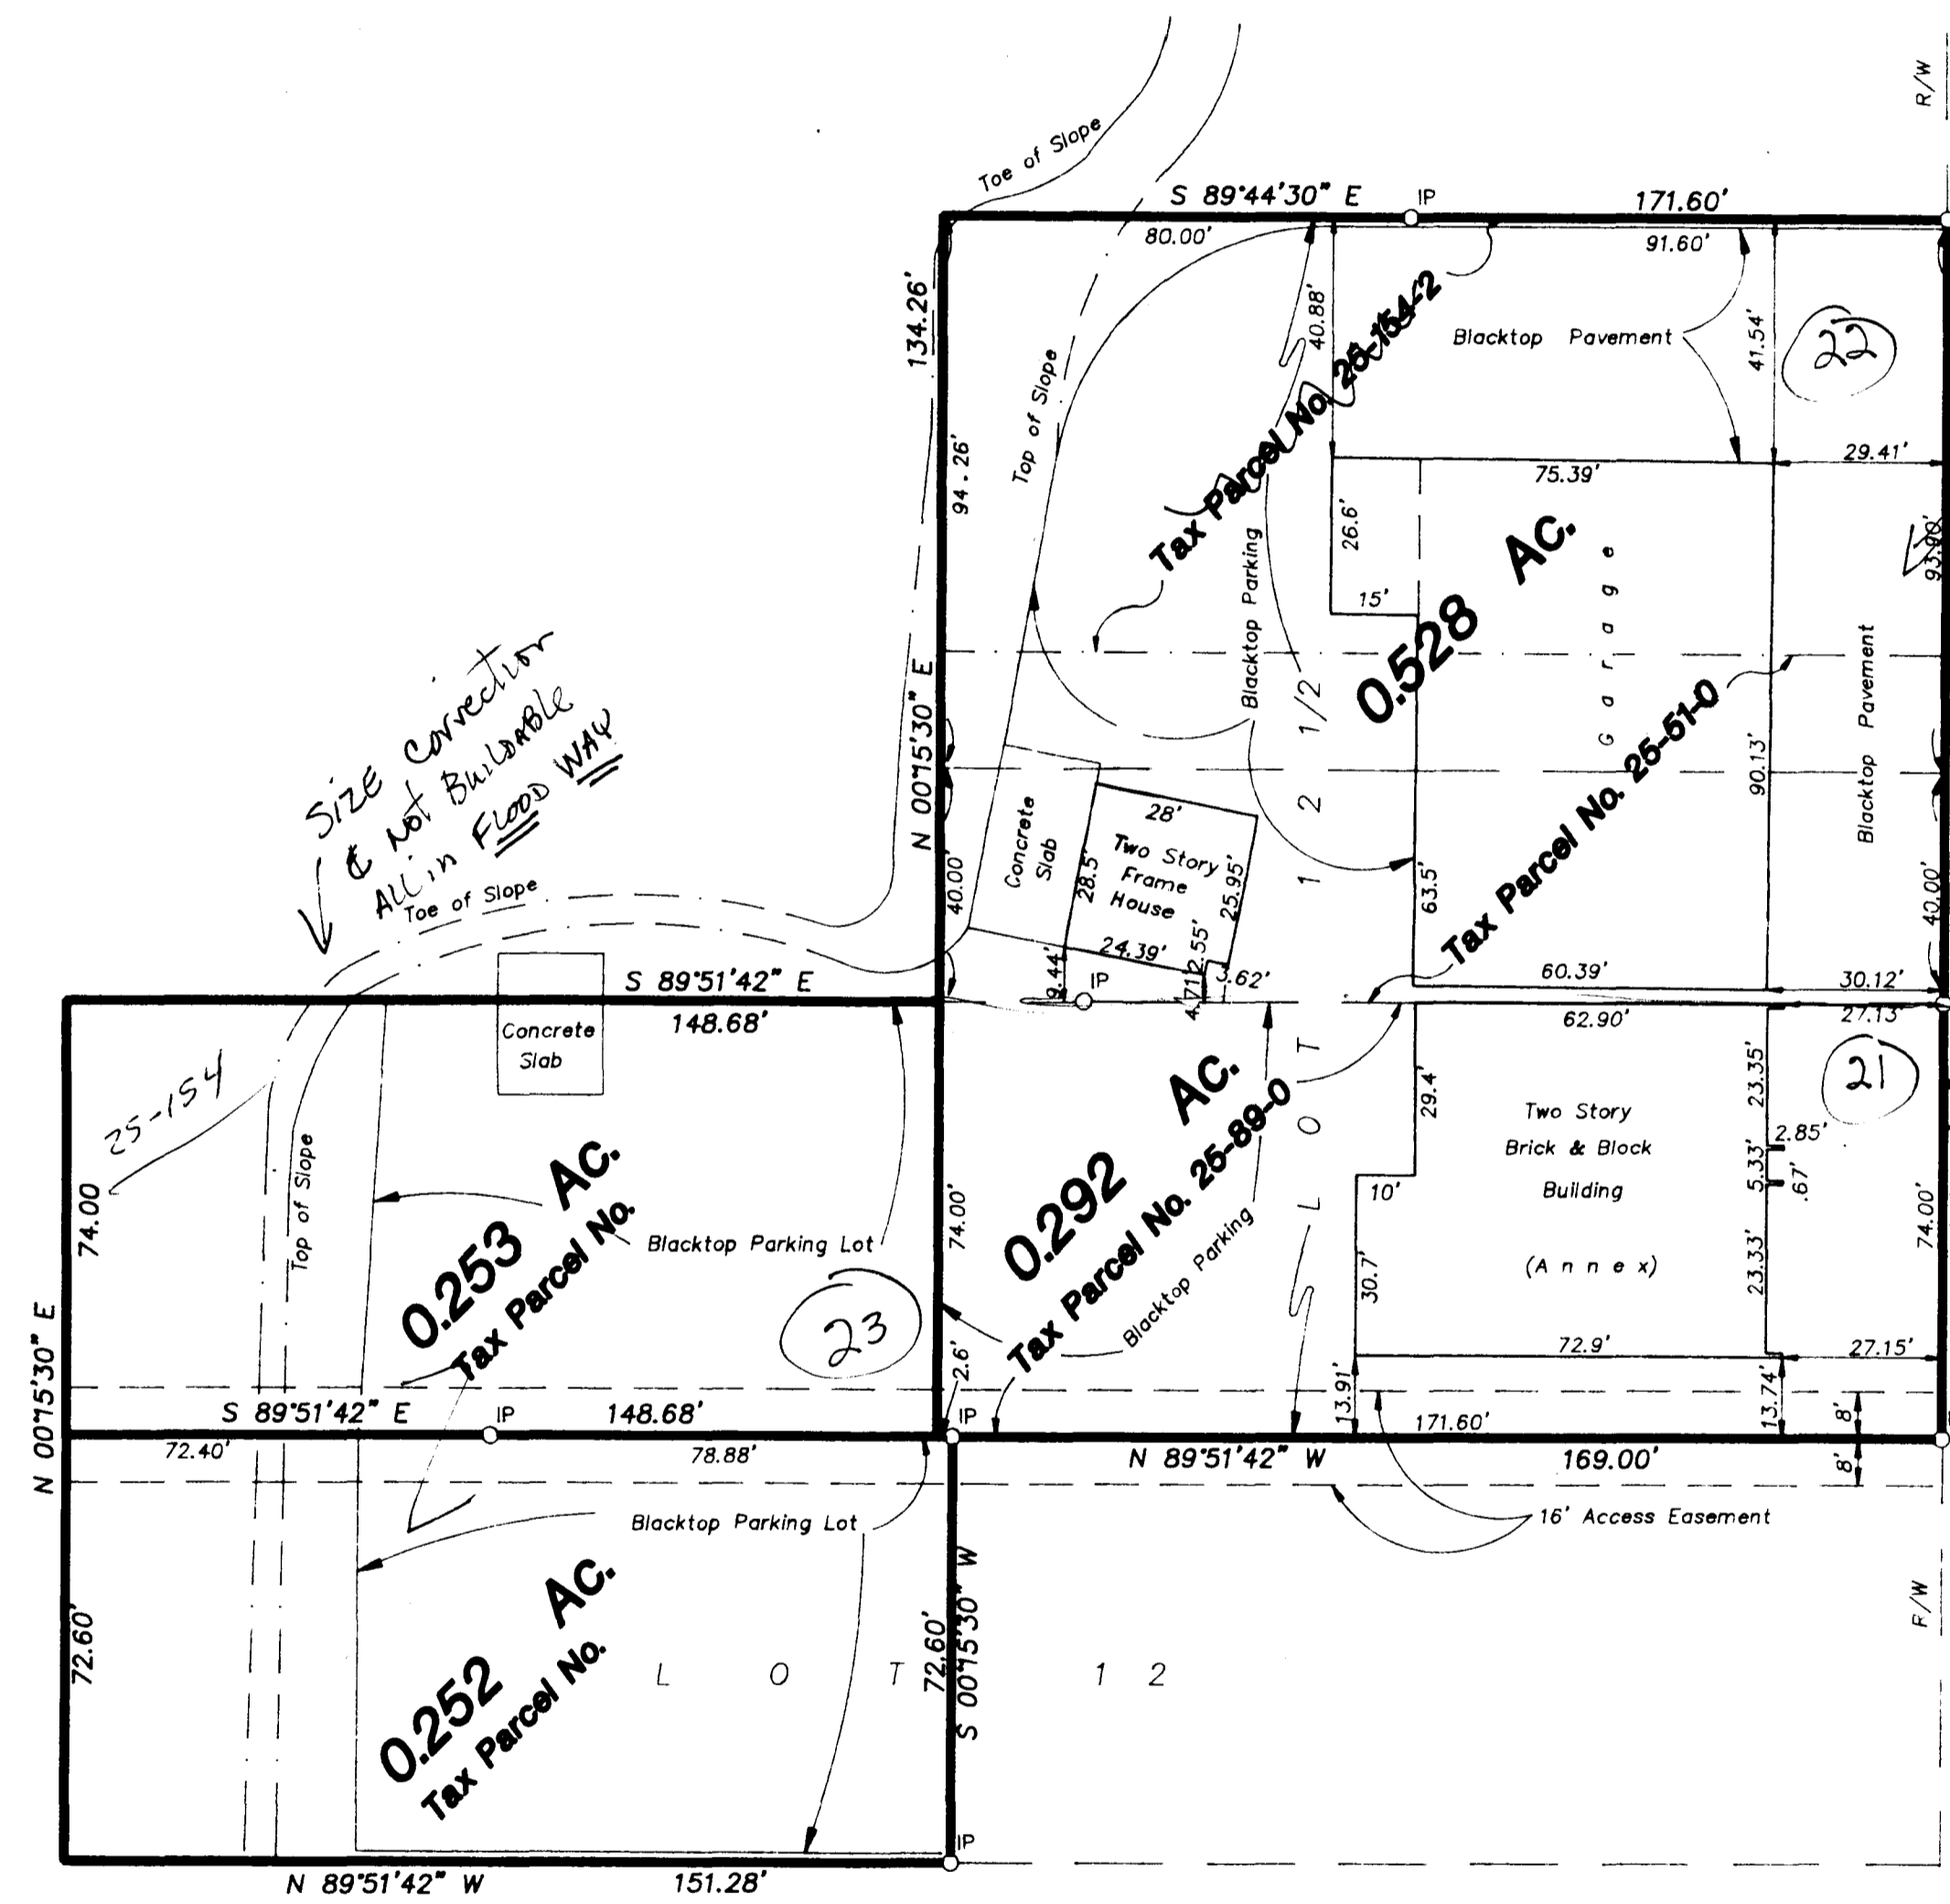

NEEDS
DESC. on
TAX BILL
CORRECTED
From DEED

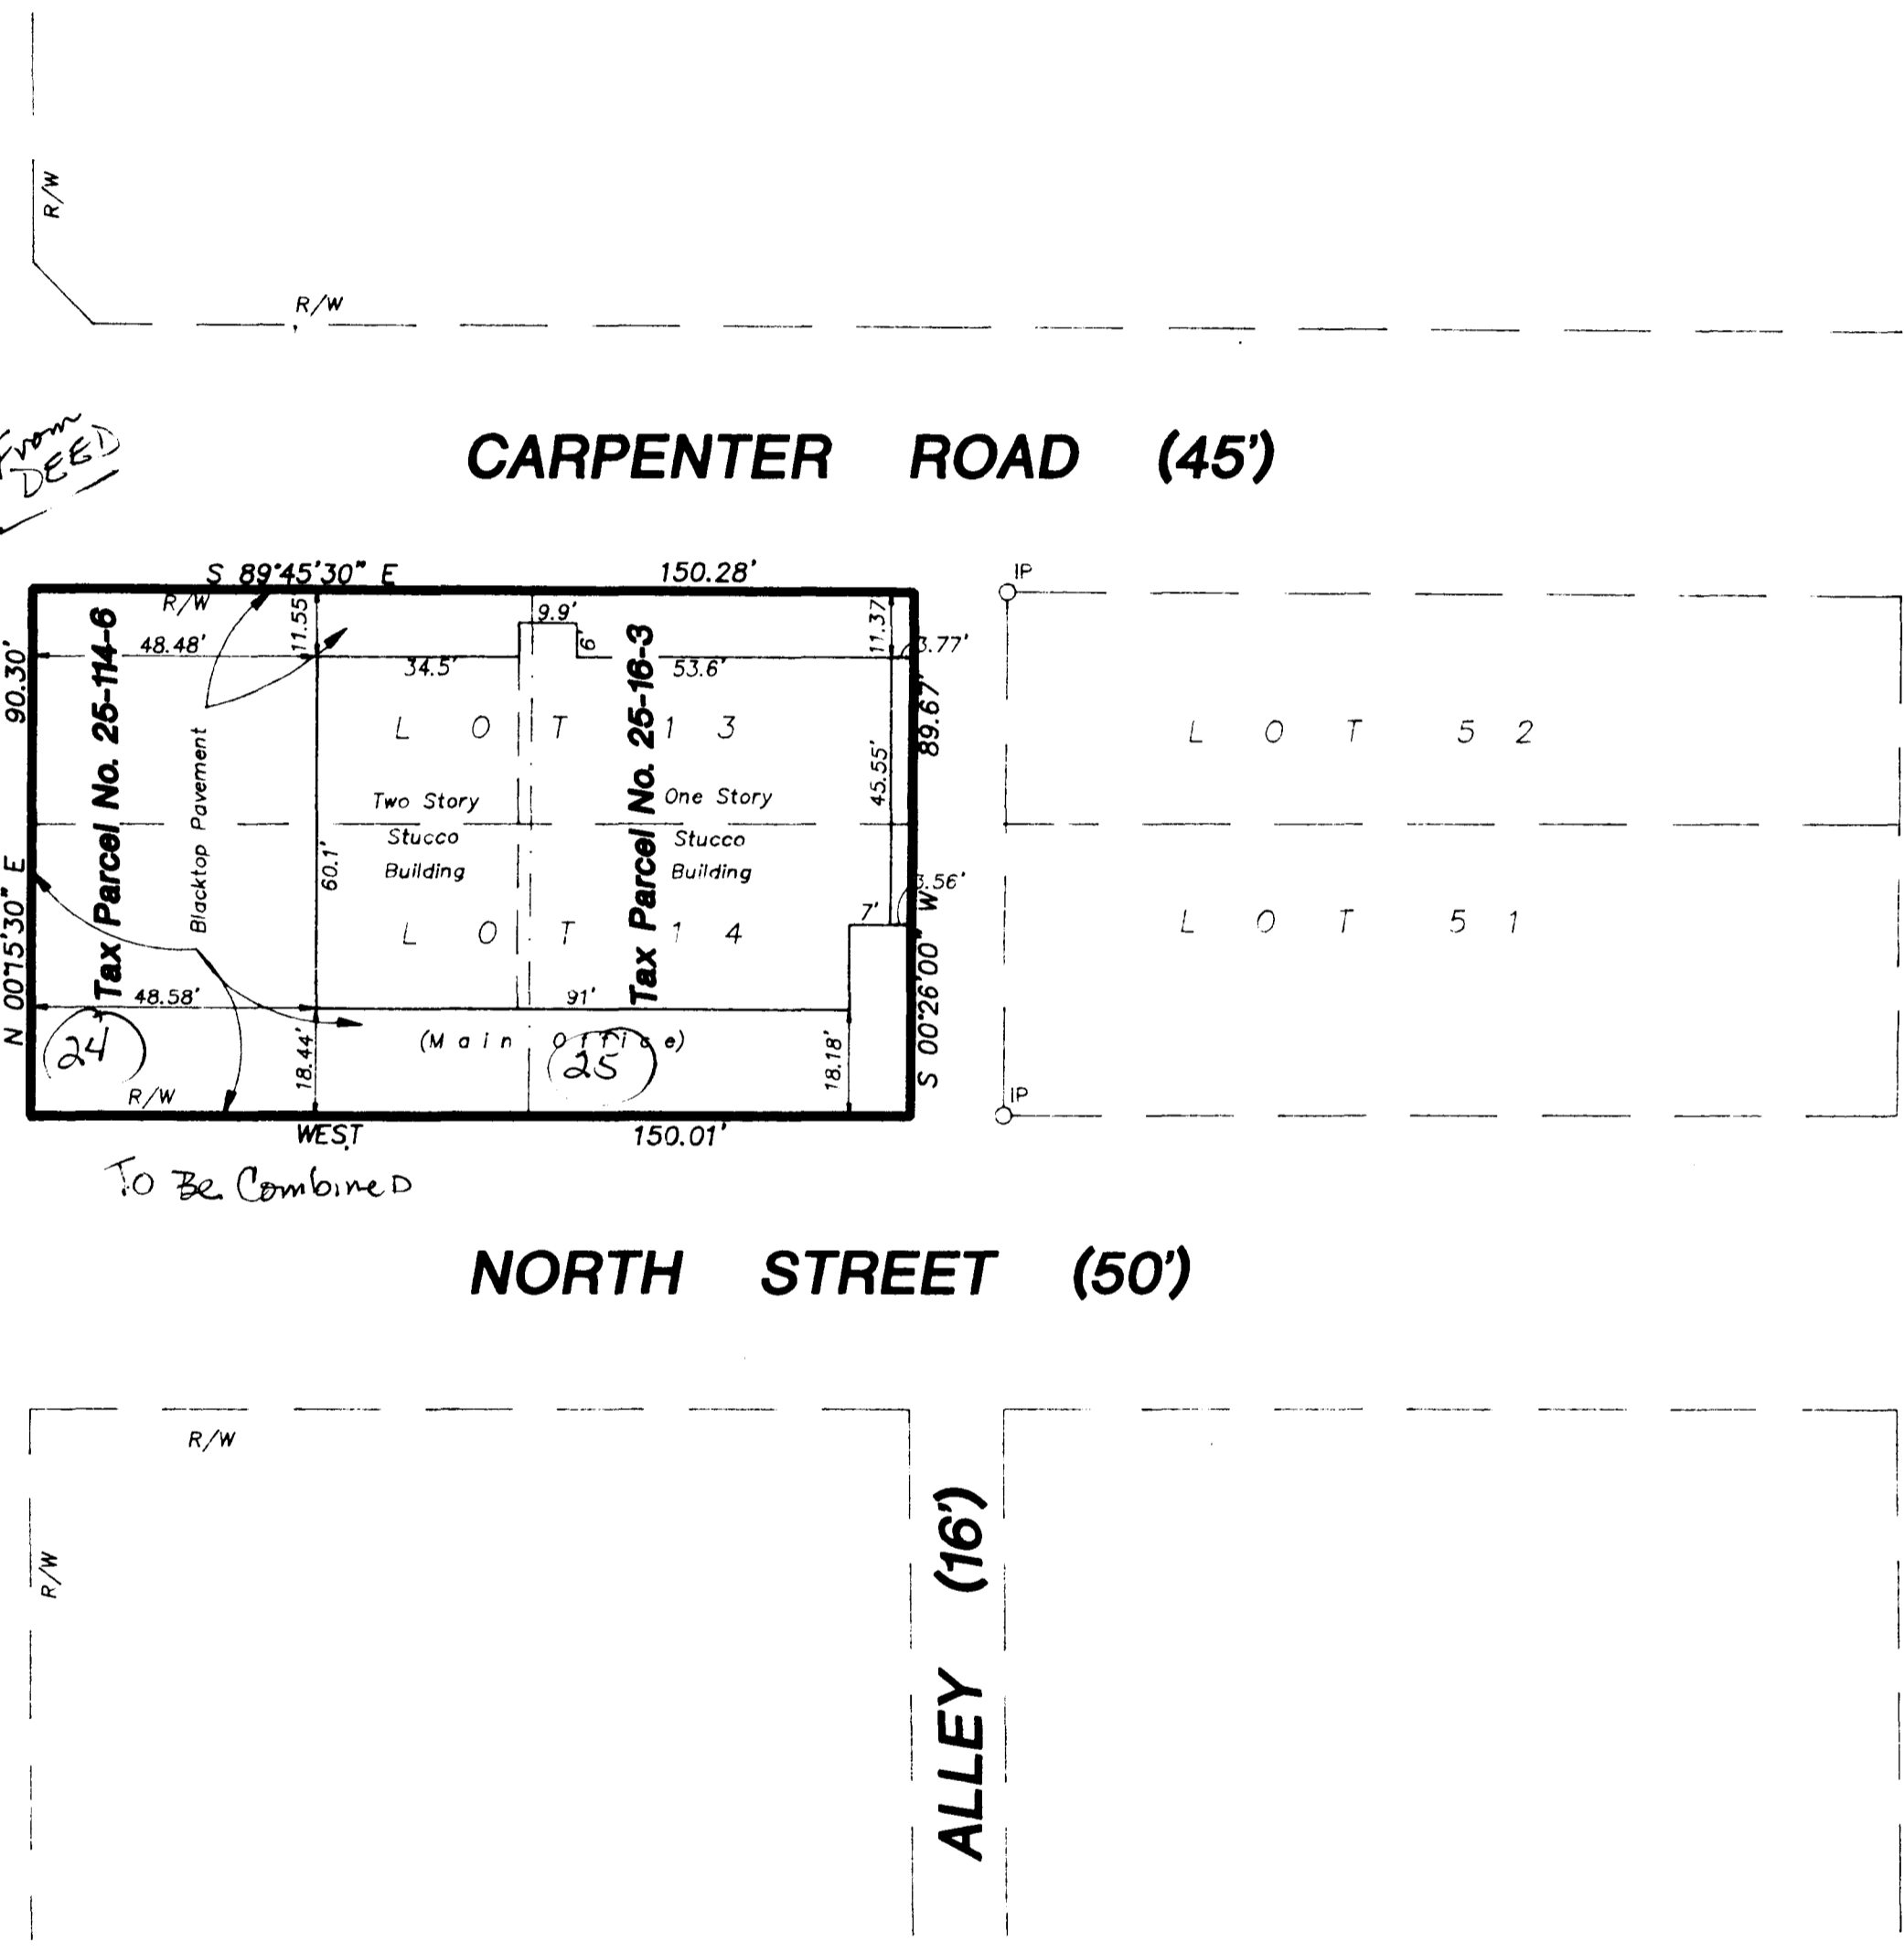

025-154
025-51+
025-89
025-114
025-16

Surveyed & Plotted
By
EVANS, MECHWART, HAMBLETON, & TILTON INC.
CONSULTING ENGINEERS AND SURVEYORS
170 MILL STREET
GAHANNA, OHIO 43230
614/471-5150

By James R. Hill
James R. Hill
Registered Surveyor No. 6919
SCALE 1" = 30' NOVEMBER 7, 1991

