


SURVEY OF ACREAGE PARCEL
 LOT 18, QTR. TWP. 4, TWP. 1, RNG. 16
 UNITED STATES MILITARY LANDS
 CITY OF COLUMBUS, FRANKLIN COUNTY, OHIO

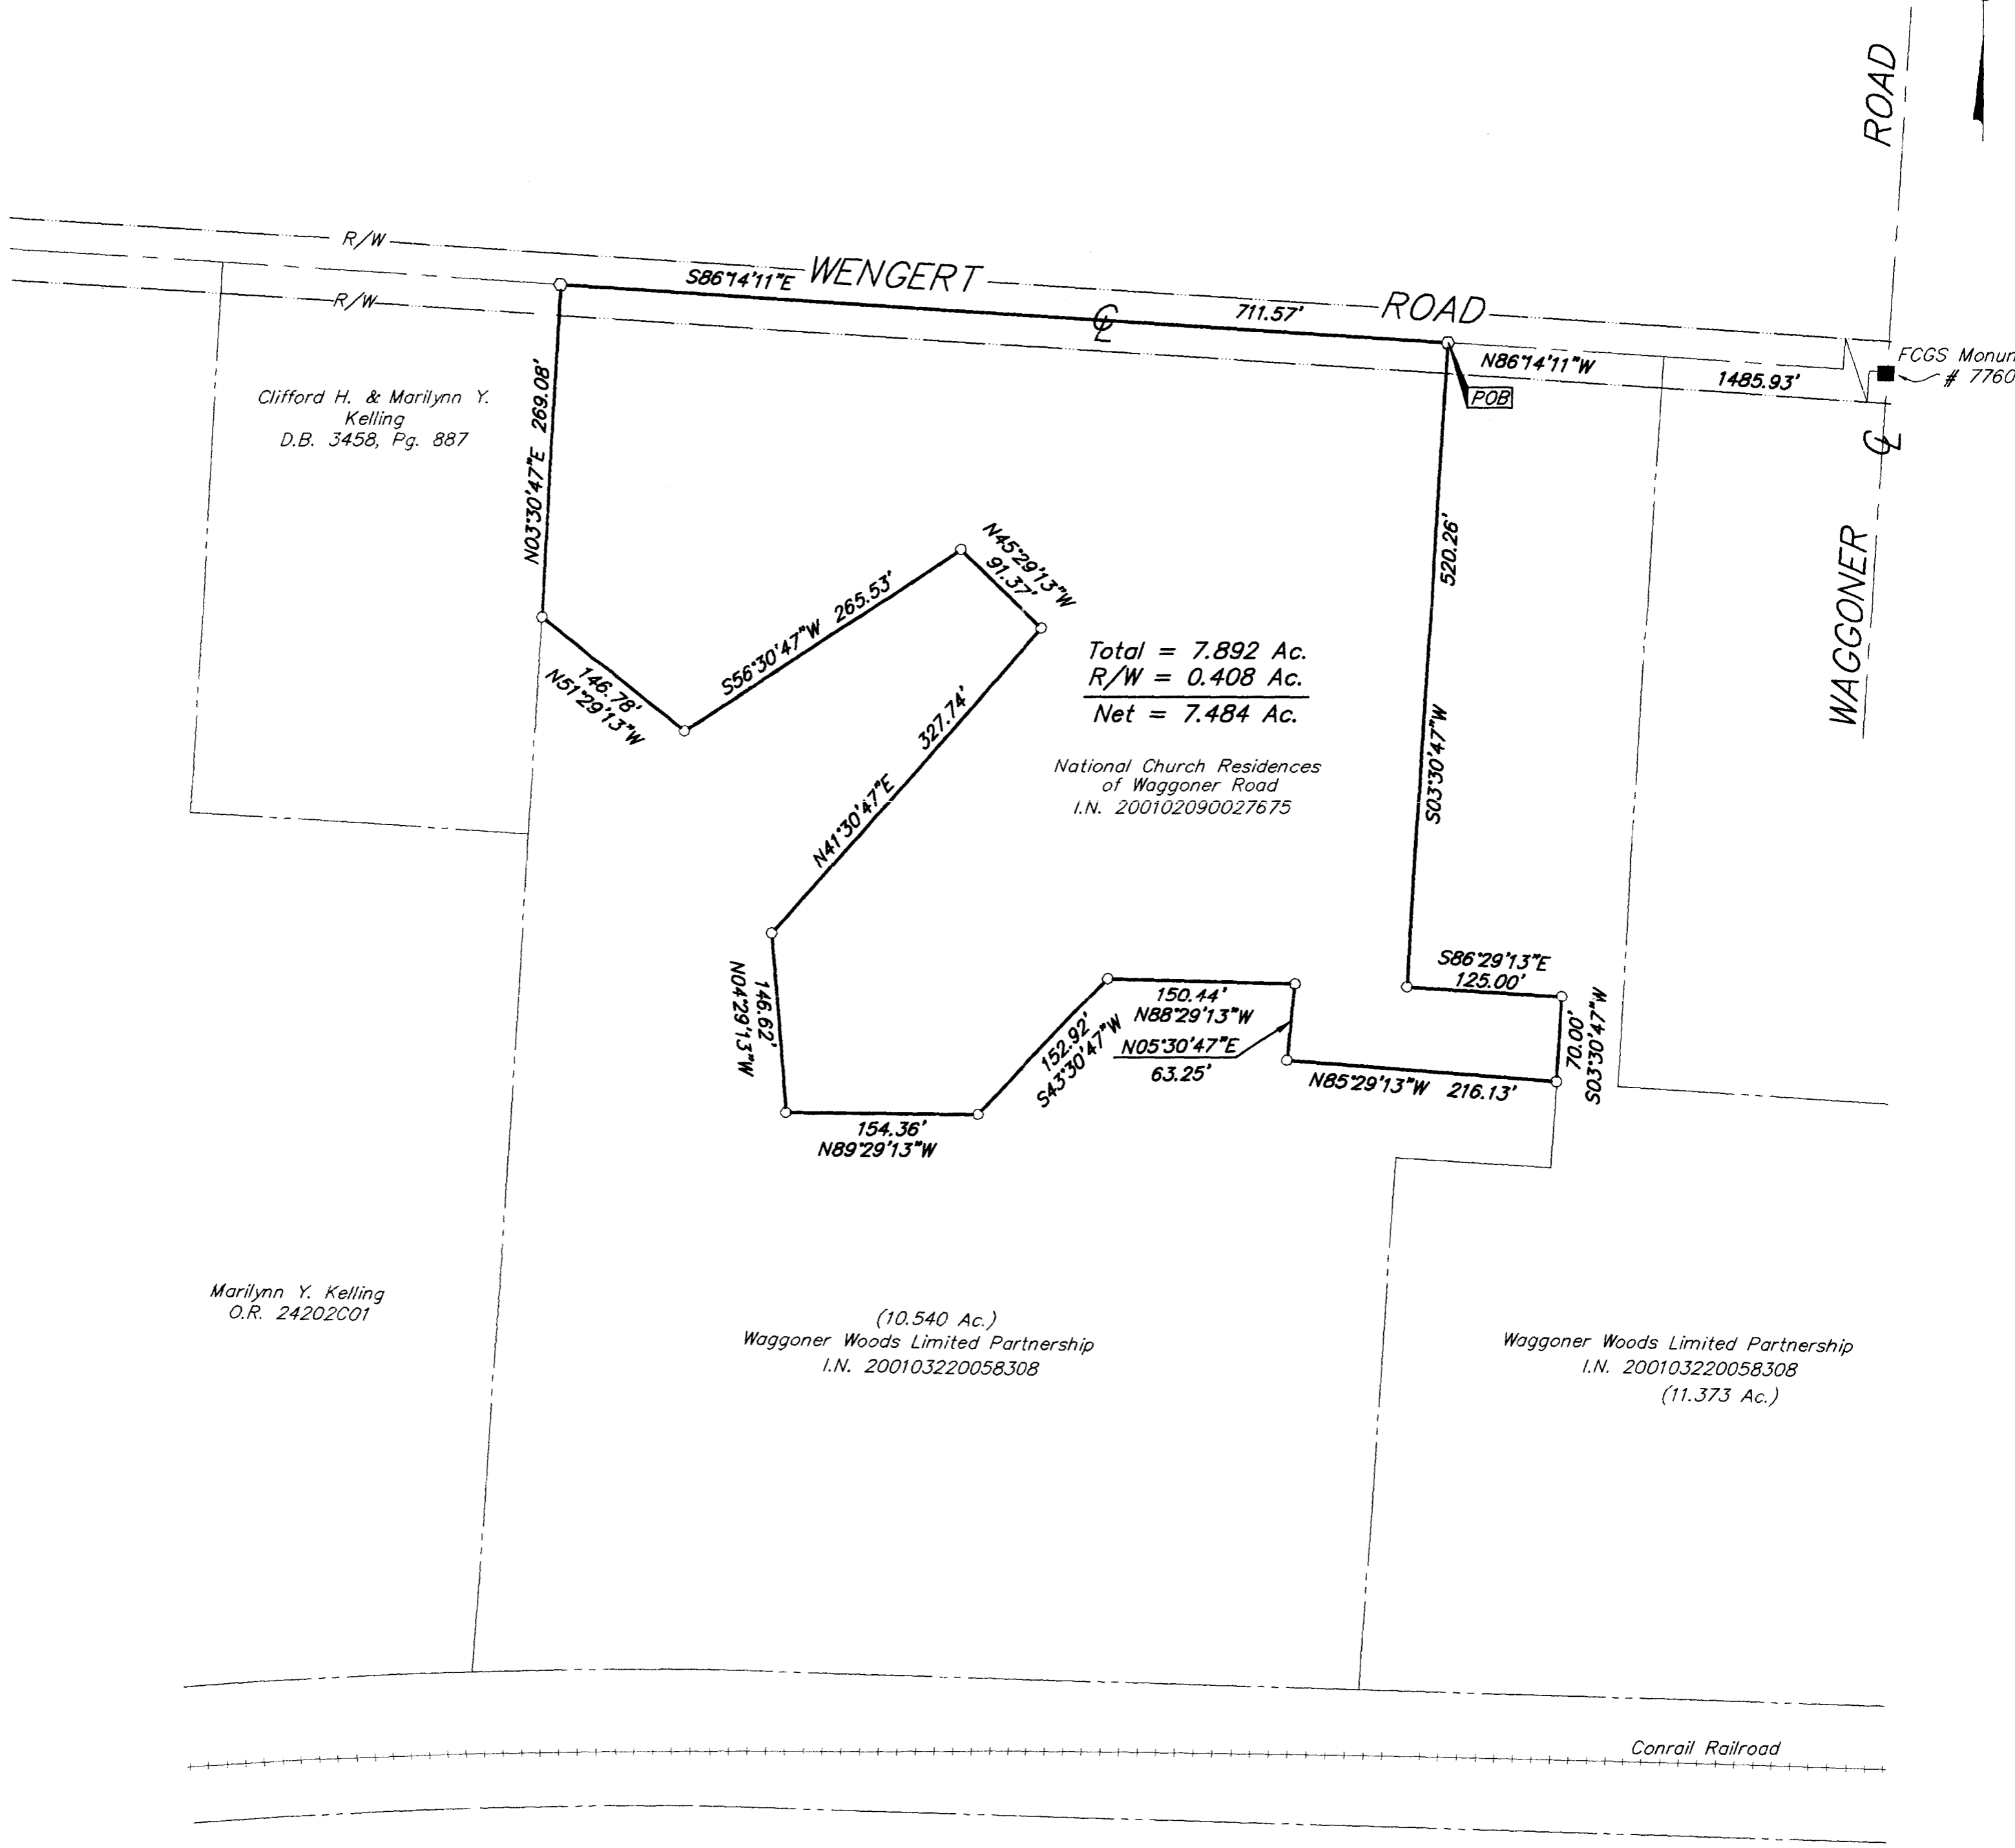

Total = 7.892 Ac.
 R/W = 0.408 Ac.
 Net = 7.484 Ac.

National Church Residences
 of Waggoner Road
 I.N. 200102090027675

(10.540 Ac.)
 Waggoner Woods Limited Partnership
 I.N. 200103220058308

Waggoner Woods Limited Partnership
 I.N. 200103220058308
 (11.373 Ac.)


- = MON. FND.
- = I.P. FND.
- = I.P. SET
- = MAG. NAIL FND.
- = MAG. NAIL SET
- ▲ = R.R. SPK. FND.
- △ = R.R. SPK. SET
- ◆ = P.K. NAIL FND.

I.P.S. Set are 1 3/16" I.D. Iron pipe W/ cap inscribed EMH&T.



By Matthew A. Kirk
 Professional Surveyor No. 7865

Surveyed & Prepared
 By
EVANS, MECHWART, HAMBLETON & TILTON INC.
 CONSULTING ENGINEERS & SURVEYORS
 170 MILL STREET
 GAHANNA, OHIO 43230
 614/471-5150

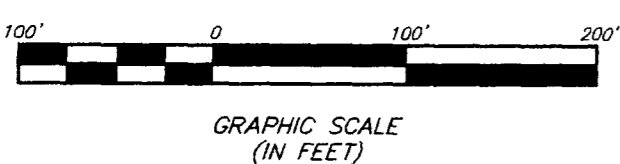

BASIS OF BEARINGS: Bearings are based on the Ohio State Plane Coordinate System as per NAD83. Control for bearings was from coordinates of monument numbers 7760 & 7776, having a bearing of South 86°14'11" East, between said Monuments, established by the Franklin County Engineering Department.