SURVEY OF 14.640 ACRE TRACT

LOCATED IN

Half Section 1, Township 5, Range 22

Refugee Lands

City of Columbus, Franklin County, Ohio

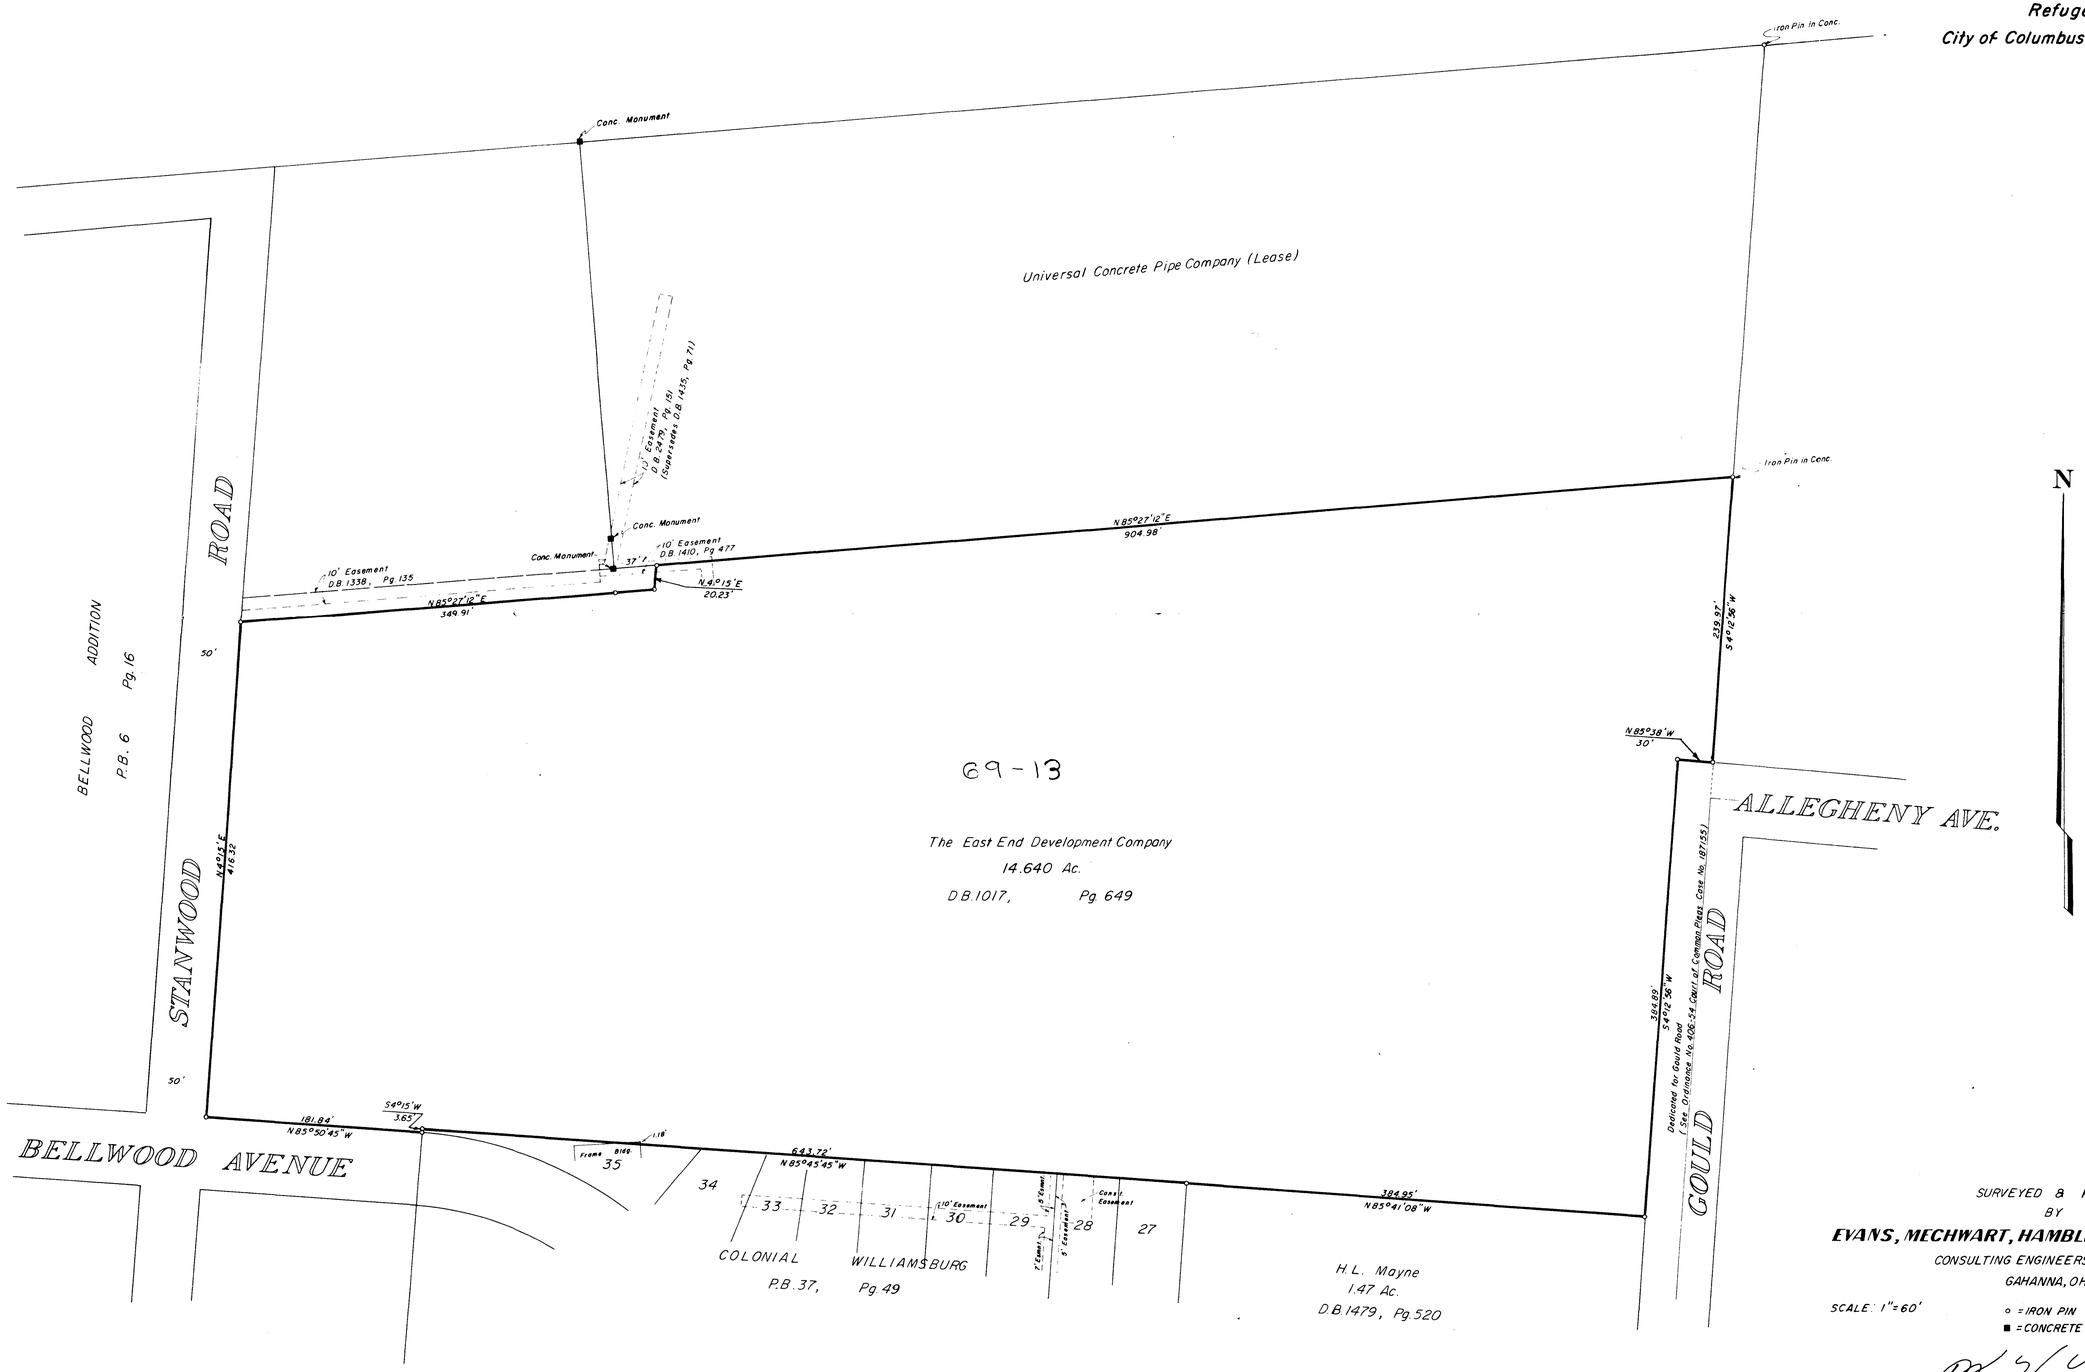

SURVEYED & PLATTED

BY

EVANS, MECHWART, HAMBLETON & TILTON, INC.

CONSULTING ENGINEERS & SURVEYORS

GAHANNA, OHIO

SCALE: 1" = 60'

○ = IRON PIN

■ = CONCRETE MONUMENT

JANUARY 4, 1969

By W. L. Mechwart

Registered Surveyor No. 4072

29-134-785-68-D21-F3